

203.16 SOLID ROCK EXCAVATION

- STA. 54+23 - STA. 54+36 LT
- STA. 54+26 - STA. 54+39 RT
- STA. 54+76 - STA. 54+91 LT
- STA. 54+78 - STA. 54+90 RT
- STA. 58+21 - STA. 58+26 RT
- STA. 58+78 - STA. 58+89 LT
- STA. 58+82 - STA. 58+87 RT

618.10 PORTLAND CEMENT CONCRETE SIDEWALK, 5 INCH

- STA. 54+23 - STA. 54+36 LT
- STA. 54+26 - STA. 54+39 RT
- STA. 54+76 - STA. 54+91 LT
- STA. 54+78 - STA. 54+90 RT
- STA. 58+21 - STA. 58+26 RT
- STA. 58+78 - STA. 58+89 LT
- STA. 58+82 - STA. 58+87 RT

618.30 DETECTABLE WARNING SURFACE

- STA. 54+26 LT STA. 54+86 RT
- STA. 54+29 RT STA. 58+23 RT
- STA. 54+33 LT STA. 58+32 LT
- STA. 54+35 RT STA. 58+81 LT
- STA. 54+79 LT STA. 58+85 RT
- STA. 54+82 RT STA. 58+86 LT
- STA. 54+85 LT

604.40 CHANGING ELEVATION OF DROP INLETS, CATCH BASINS, OR MANHOLES

- STA. 54+11 LT (DMH) STA. 54+80 LT (EMH)
- STA. 54+50 LT (EMH) STA. 58+73 RT (TEL.)
- STA. 54+71 RT (TEL.) STA. 58+77 LT (EMH)
- STA. 58+85 LT (EMH)

604.42 CHANGING ELEVATION OF SEWER MANHOLES

- STA. 54+32 LT STA. 54+76 RT
- STA. 54+60 RT STA. 58+57 CL

629.20 ADJUST ELEVATION OF VALVE BOX

- STA. 54+66 RT (WSV) STA. 56+11 RT (GSV)
- STA. 54+66 RT (WSV) STA. 56+42 RT (GSV)
- STA. 54+69 LT (WSV) STA. 56+42 LT (GSV)
- STA. 54+75 RT (WSV) STA. 56+47 RT (GSV)
- STA. 55+03 LT (WSV) STA. 56+82 LT (GSV)
- STA. 55+43 LT (GSV) STA. 58+15 LT (WSV)
- STA. 56+07 RT (GSV) STA. 58+61 LT (WSV)
- STA. 56+11 RT (GSV) STA. 59+38 LT (WSV)

604.412, 604.415, 604.418 REHAB, DROP INLETS, CATCH BASINS, OR MANHOLES, CLASS I, CLASS II OR CLASS III

- STA. 54+42 RT "TYPE D GRATE"
- STA. 54+78 RT "TYPE D GRATE"
- STA. 54+80 LT "TYPE D GRATE"

646.406 DURABLE 4" WHITE LINE, RECESSED POLYUREA

- STA. 53+25 - STA. 54+20 (DASHED LT & RT)
- STA. 54+36 - STA. 54+44 LT (PARKING STALLS)
- STA. 54+67 - STA. 54+75 LT (PARKING STALLS)
- STA. 54+93 - STA. 57+93 (DASHED LT & RT)
- STA. 58+49 LT
- STA. 58+95 - STA. 59+50 (DASHED LT & RT)

646.602 TEMPORARY 4" WHITE LINE, PAINT

- STA. 53+25 - STA. 54+20 (DASHED LT & RT)
- STA. 54+36 - STA. 54+44 LT (PARKING STALLS)
- STA. 54+67 - STA. 54+75 LT (PARKING STALLS)
- STA. 54+93 - STA. 57+93 (DASHED LT & RT)
- STA. 58+49 LT
- STA. 58+95 - STA. 59+50 (DASHED LT & RT)

646.491 DURABLE LETTER OR SYMBOL, TYPE I TAPE

- STA. 58+45 LT ARROW STA. 58+56 LT ARROW


646.692 TEMPORARY LETTER OR SYMBOL, PAINT

- STA. 58+45 LT ARROW STA. 58+56 LT ARROW

- STA. 53+25 - STA. 54+20 (SOLID LT & RT)
- STA. 54+55 LT (CENTERLINE COLLEGE ST.)
- STA. 54+60 RT (CENTERLINE COLLEGE ST.)
- STA. 54+93 - STA. 57+94 (SOLID LT & RT)
- STA. 58+62 LT (CENTERLINE BANK ST.)
- STA. 58+95 - STA. 59+50 (CENTERLINE RT)

646.612 TEMPORARY 4" YELLOW LINE, PAINT

- STA. 53+25 - STA. 54+20 (SOLID LT & RT)
- STA. 54+55 LT (CENTERLINE COLLEGE ST.)
- STA. 54+60 RT (CENTERLINE COLLEGE ST.)
- STA. 54+93 - STA. 57+94 (SOLID LT & RT)
- STA. 58+62 LT (CENTERLINE BANK ST.)
- STA. 58+95 - STA. 59+50 (CENTERLINE RT)

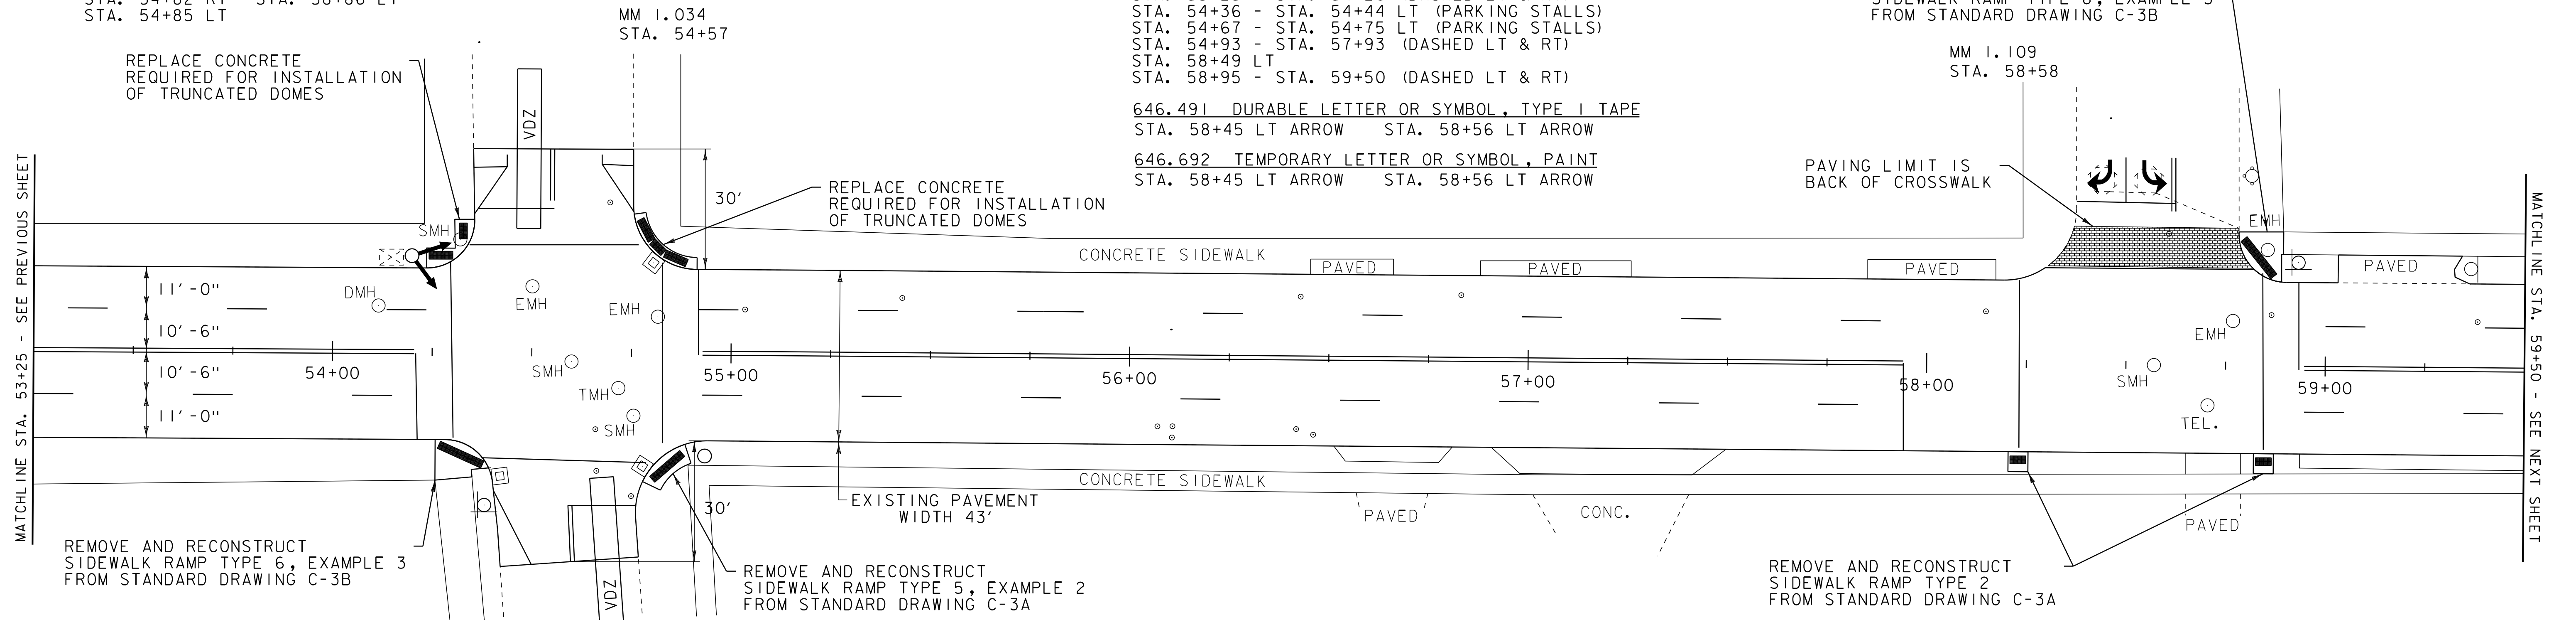

616.28 CAST-IN-PLACE CONCRETE CURB, TYPE B

- STA. 54+23 - STA. 54+36 LT
- STA. 54+76 - STA. 54+91 LT
- STA. 58+17 - STA. 58+37 LT
- STA. 58+21 - STA. 58+26 RT
- STA. 58+78 - STA. 58+89 LT
- STA. 58+82 - STA. 58+87 RT

616.41 REMOVAL OF EXISTING CURB

- STA. 54+23 - STA. 54+36 LT
- STA. 54+76 - STA. 54+91 LT
- STA. 58+17 - STA. 58+37 LT
- STA. 58+21 - STA. 58+26 RT
- STA. 58+78 - STA. 58+89 LT
- STA. 58+82 - STA. 58+87 RT

646.501 DURABLE CROSSWALK MARKING, TYPE I TAPE

- STA. 54+30 LT & RT
- STA. 54+34 - STA. 54+77 LT
- STA. 54+38 - STA. 54+79 RT
- STA. 54+83 LT & RT
- STA. 58+23 LT & RT
- STA. 58+84 LT & RT

646.702 TEMPORARY CROSSWALK MARKING, PAINT

- STA. 54+30 LT & RT
- STA. 54+34 - STA. 54+77 LT
- STA. 54+38 - STA. 54+79 RT
- STA. 54+83 LT & RT
- STA. 58+23 LT & RT
- STA. 58+35 - STA. 58+79 LT
- STA. 58+84 LT & RT

900.620 SPECIAL PROVISION (VIDEO VEHICLE DETECTION SYSTEM) (U.S. ALT. ROUTE 7 @ COLLEGE ST.)

- STA. 54+20 LT STA. 54+20 LT

900.640 SPECIAL PROVISION (DURABLE CROSSWALK MARKING, IMPRINTED/COLORIZED)

- STA. 58+35 - STA. 58+79 LT

646.486 DURABLE 24" STOP BAR, RECESSED POLYUREA

- STA. 54+20 RT
- STA. 54+36 - STA. 54+55 LT
- STA. 54+59 - STA. 54+76 RT
- STA. 54+93 LT
- STA. 57+93 RT
- STA. 58+37 - STA. 58+62 LT
- STA. 58+94 LT

646.682 TEMPORARY 24" STOP BAR, PAINT

- STA. 54+20 RT
- STA. 54+36 - STA. 54+55 LT
- STA. 54+59 - STA. 54+76 RT
- STA. 54+93 LT
- STA. 57+93 RT
- STA. 58+37 - STA. 58+62 LT
- STA. 58+94 LT

LEGEND

- HYDRANT
- MANHOLE
- VALVE
- GAS PIPELINE MARKER
- CATCH BASIN / DROP INLET
- CURB INLET
- ⊕ PARKING METER
- VDZ VIDEO DETECTION ZONE
- ➔ VIDEO CAMERA

SIGN LEGEND

- R = REMOVE
- R&S = REMOVE AND SALVAGE
- RET = RETAIN
- S = SALVAGE
- N = NEW
- B-B = BACK TO BACK

PROJECT LAYOUT SHEET 10

PROJECT NAME: BURLINGTON (CLASS I)  
PROJECT NUMBER: STP 2722 (I)

FILE NAME: 07d028.dgn  
PROJECT LEADER: EPD  
DESIGNED BY: CDL  
PLOT FILE: 07d028\_24.i

PLOT DATE: 05-JUN-2014 11:20  
DRAWN BY: SJL  
CHECKED BY: EPD  
SHEET 24 OF 61

NOT TO SCALE