

**203.16 SOLID ROCK EXCAVATION**

STA. 61+27 - STA. 61+34 RT  
 STA. 61+64 - STA. 61+74 RT  
 STA. 62+27 - STA. 62+39 LT  
 STA. 62+29 - STA. 62+38 RT  
 STA. 62+79 - STA. 62+92 LT  
 STA. 62+84 - STA. 62+92 RT

**604.412, 604.415, 604.418 REHAB, DROP INLETS, CATCH BASINS, OR MANHOLES, CLASS I, CLASS II OR CLASS III**

STA. 61+68 RT "TYPE D GRATE"  
 STA. 62+37 LT "TYPE D GRATE"  
 STA. 62+83 LT "TYPE D GRATE"

**604.40 CHANGING ELEVATION OF DROP INLETS, CATCH BASINS, OR MANHOLES**

STA. 60+17 LT (EMH) STA. 62+48 LT (EMH)  
 STA. 61+38 LT (EMH) STA. 62+75 LT (EMH)  
 STA. 62+45 LT (EMH) STA. 64+17 LT (EMH)

**604.42 CHANGING ELEVATION OF SEWER MANHOLES**

STA. 61+38 LT STA. 62+66 LT  
 STA. 61+63 RT STA. 63+00 RT  
 STA. 65+21 LT

**616.28 CAST-IN-PLACE CONCRETE CURB, TYPE B**

STA. 62+29 - STA. 62+38 RT  
 STA. 62+83 - STA. 62+92 RT  
 STA. 63+21 - STA. 64+43 LT

**616.41 REMOVAL OF EXISTING CURB**

STA. 62+29 - STA. 62+38 RT  
 STA. 62+83 - STA. 62+92 RT  
 STA. 63+21 - STA. 64+43 LT

**629.20 ADJUST ELEVATION OF VALVE BOX**

STA. 61+86 RT (GSV) STA. 63+14 LT (WSV)  
 STA. 62+66 LT (WSV) STA. 63+33 LT (WSV)  
 STA. 62+70 LT (WSV) STA. 63+41 RT (GSV)

**618.10 PORTLAND CEMENT CONCRETE SIDEWALK, 5 INCH**

STA. 61+27 - STA. 61+34 RT  
 STA. 61+64 - STA. 61+74 RT  
 STA. 62+27 - STA. 62+39 LT  
 STA. 62+29 - STA. 62+38 RT  
 STA. 62+79 - STA. 62+92 LT  
 STA. 62+84 - STA. 62+92 RT  
 STA. 63+21 - STA. 64+43 LT

**618.30 DETECTABLE WARNING SURFACE**

STA. 61+30 RT STA. 62+36 LT  
 STA. 61+68 RT STA. 62+83 LT  
 STA. 62+31 LT STA. 62+88 RT  
 STA. 62+34 RT STA. 62+89 LT

**646.406 DURABLE 4" WHITE LINE, RECESSED POLYUREA**

STA. 59+50 - STA. 62+24 (DASHED LT & RT)  
 STA. 61+50 RT (EDGELINES BUELL ST.)  
 STA. 62+98 - STA. 65+25 (DASHED LT)  
 STA. 62+98 - STA. 64+75 (DASHED RT)  
 STA. 64+75 - STA. 65+25 (SOLID RT)

**646.602 TEMPORARY 4" WHITE LINE, PAINT**

STA. 59+50 - STA. 62+24 (DASHED LT & RT)  
 STA. 61+50 RT (EDGELINES BUELL ST.)  
 STA. 62+98 - STA. 65+25 (DASHED LT)  
 STA. 62+98 - STA. 64+75 (DASHED RT)  
 STA. 64+75 - STA. 65+25 (SOLID RT)

**646.491 DURABLE LETTER OR SYMBOL, TYPE I TAPE**

STA. 64+81 RT "ONLY"  
 STA. 64+81 RT "ONLY"

**646.692 TEMPORARY LETTER OR SYMBOL, PAINT**

STA. 64+81 RT "ONLY"  
 STA. 64+81 RT "ONLY"

**646.416 DURABLE 4" YELLOW LINE, RECESSED POLYUREA**


STA. 59+50 - STA. 62+25 (SOLID LT & RT)  
 (WITH BREAKS AT TOWN ROADS)  
 STA. 62+59 LT (CENTERLINE CHERRY ST.)  
 STA. 62+98 - STA. 65+25 (SOLID LT & RT)

**646.612 TEMPORARY 4" YELLOW LINE, PAINT**

STA. 59+50 - STA. 62+25 (SOLID LT & RT)  
 (WITH BREAKS AT TOWN ROADS)  
 STA. 62+59 LT (CENTERLINE CHERRY ST.)  
 STA. 62+98 - STA. 65+25 (SOLID LT & RT)

**VEHICLE LOOP DETECTOR SCHEDULE NOT INSTALLED**

STREET	STATION	SIZE	TYPE	TURNS	MODE
CHERRY ST.	STA. 62+46 - STA. 62+52	6' X 6'	QUAD	3	PRES

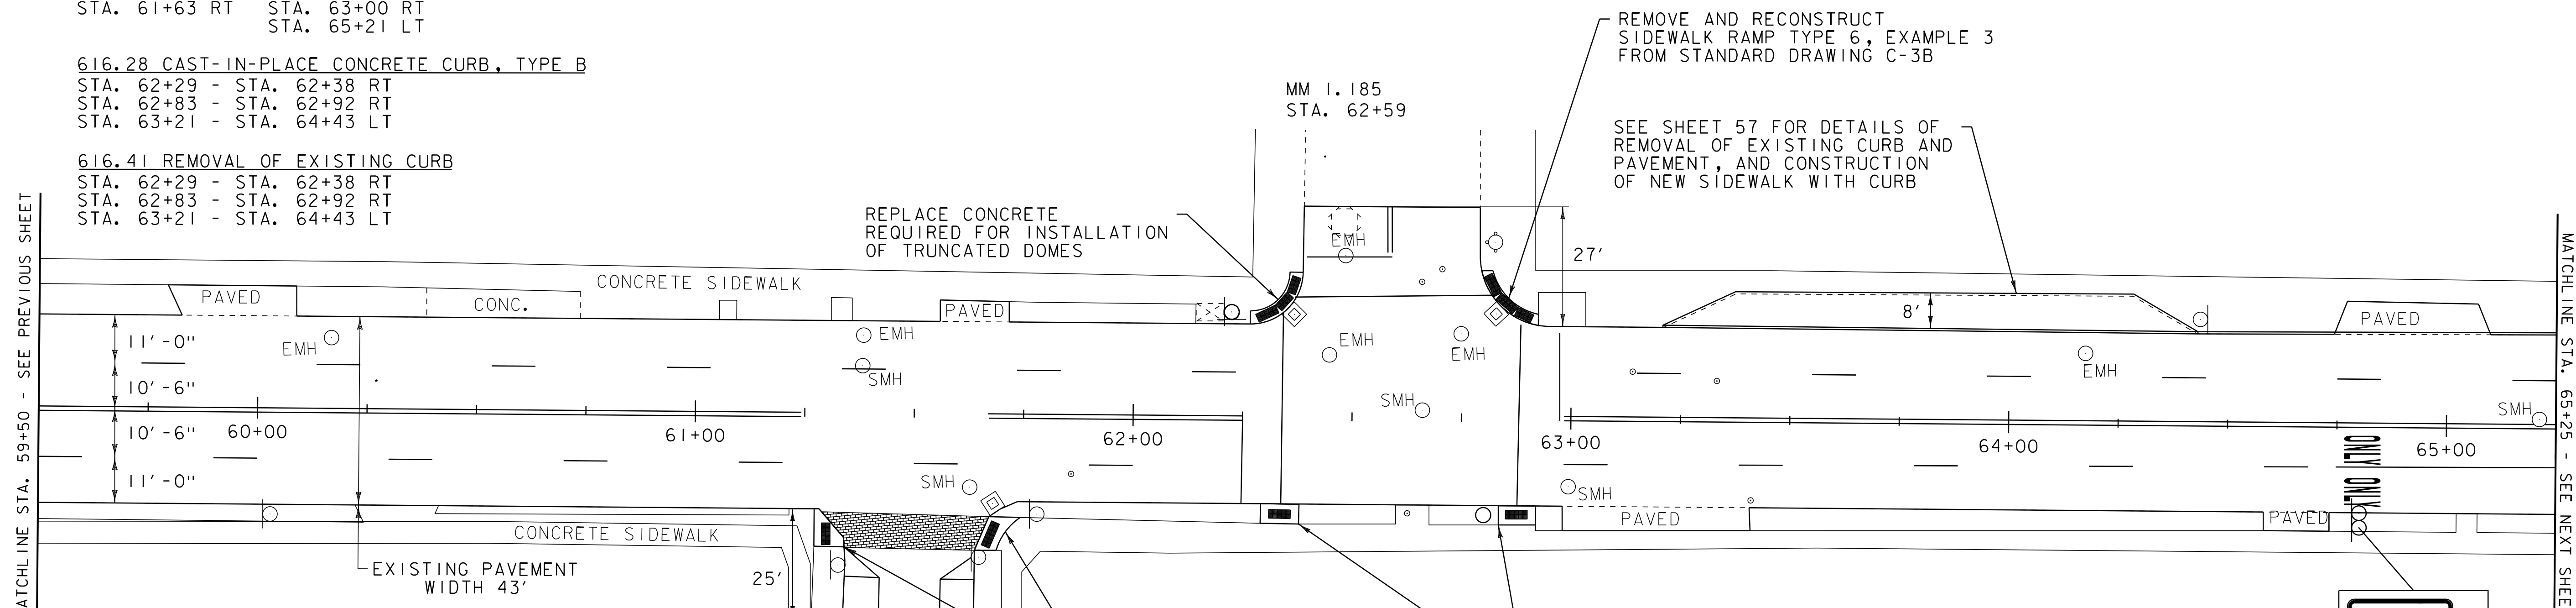

**646.486 DURABLE 24" STOP BAR, RECESSED POLYUREA**  
 STA. 62+24 RT  
 STA. 62+39 - STA. 62+59 LT  
 STA. 62+98 LT

**646.682 TEMPORARY 24" STOP BAR, PAINT**  
 STA. 62+24 RT  
 STA. 62+39 - STA. 62+59 LT  
 STA. 62+98 LT

**646.501 DURABLE CROSSWALK MARKING, TYPE I TAPE**  
 STA. 62+34 LT & RT  
 STA. 62+37 - STA. 62+83 LT  
 STA. 62+88 LT & RT

**646.702 TEMPORARY CROSSWALK MARKING, PAINT**  
 STA. 61+33 - STA. 61+64 RT  
 STA. 62+34 LT & RT  
 STA. 62+37 - STA. 62+83 LT  
 STA. 62+88 LT & RT

**900.640 SPECIAL PROVISION (DURABLE CROSSWALK MARKING, IMPRINTED/COLORIZED)**  
 STA. 61+33 - STA. 61+64 RT

- LEGEND**
- HYDRANT
  - MANHOLE
  - VALVE
  - GAS PIPELINE MARKER
  - CATCH BASIN / DROP INLET
  - CURB INLET
  - ⊠ TRAFFIC CONTROL BOX
  - ⊕ PARKING METER
  - VDZ VIDEO DETECTION ZONE
  - ➔ VIDEO CAMERA
- SIGN LEGEND**
- ONLY ONLY

**PROJECT LAYOUT SHEET 11**

PROJECT NAME: BURLINGTON (CLASS I)	PLOT DATE: 05-JUN-2014 11:20
PROJECT NUMBER: STP 2722 (I)	DRAWN BY: SJL
FILE NAME: 07d028.dgn	CHECKED BY: EPD
PROJECT LEADER: EPD	SHEET 25 OF 61
DESIGNED BY: CDL	
PLOT FILE: 07d028.25.i	

NOT TO SCALE