



**SOUTH WINOOSKI AVE
BUS PULL-OFF RECONSTRUCTION**

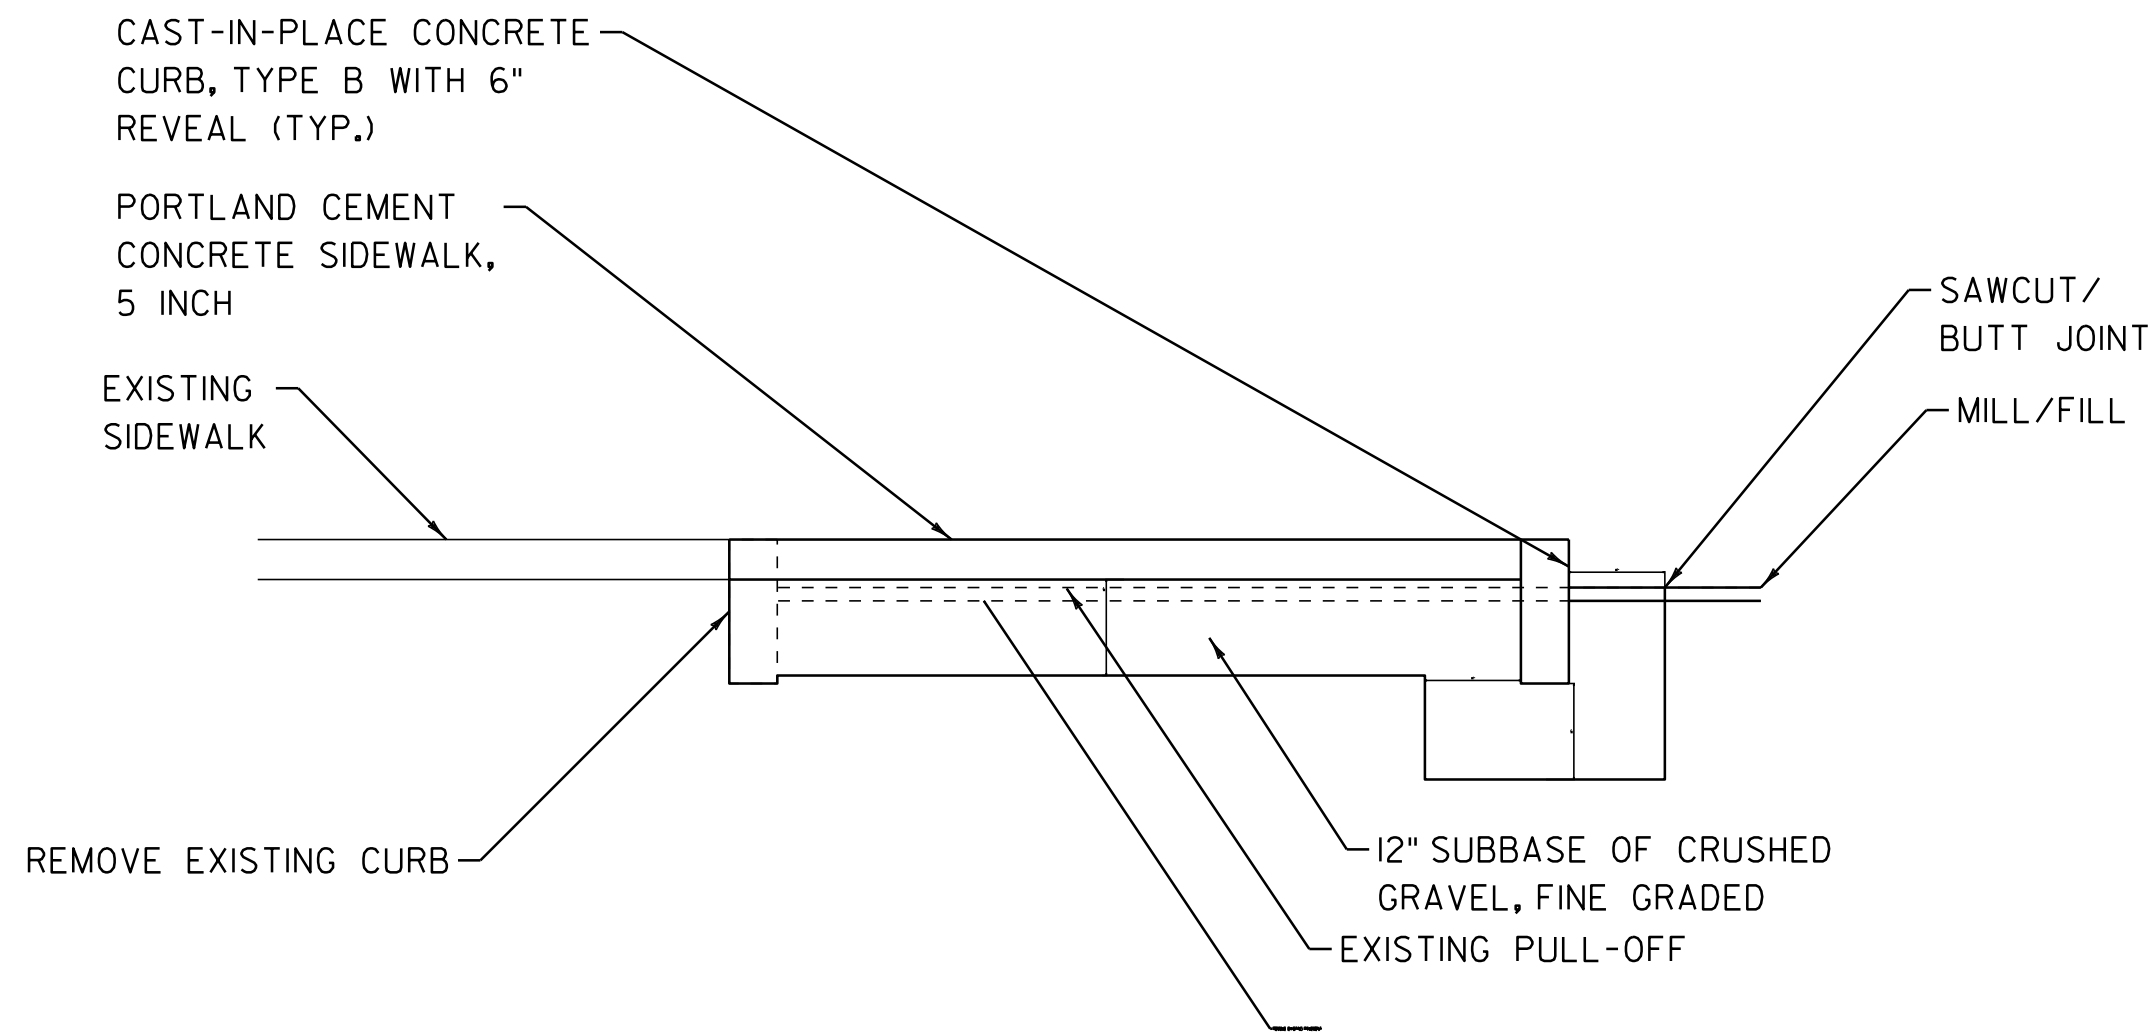


SECTION A-A

NOTES:

- CONTRACTOR TO REMOVE CURBING AND PAVEMENT AND CONSTRUCT EXISTING SIDEWALK AS SHOWN IN DETAIL.

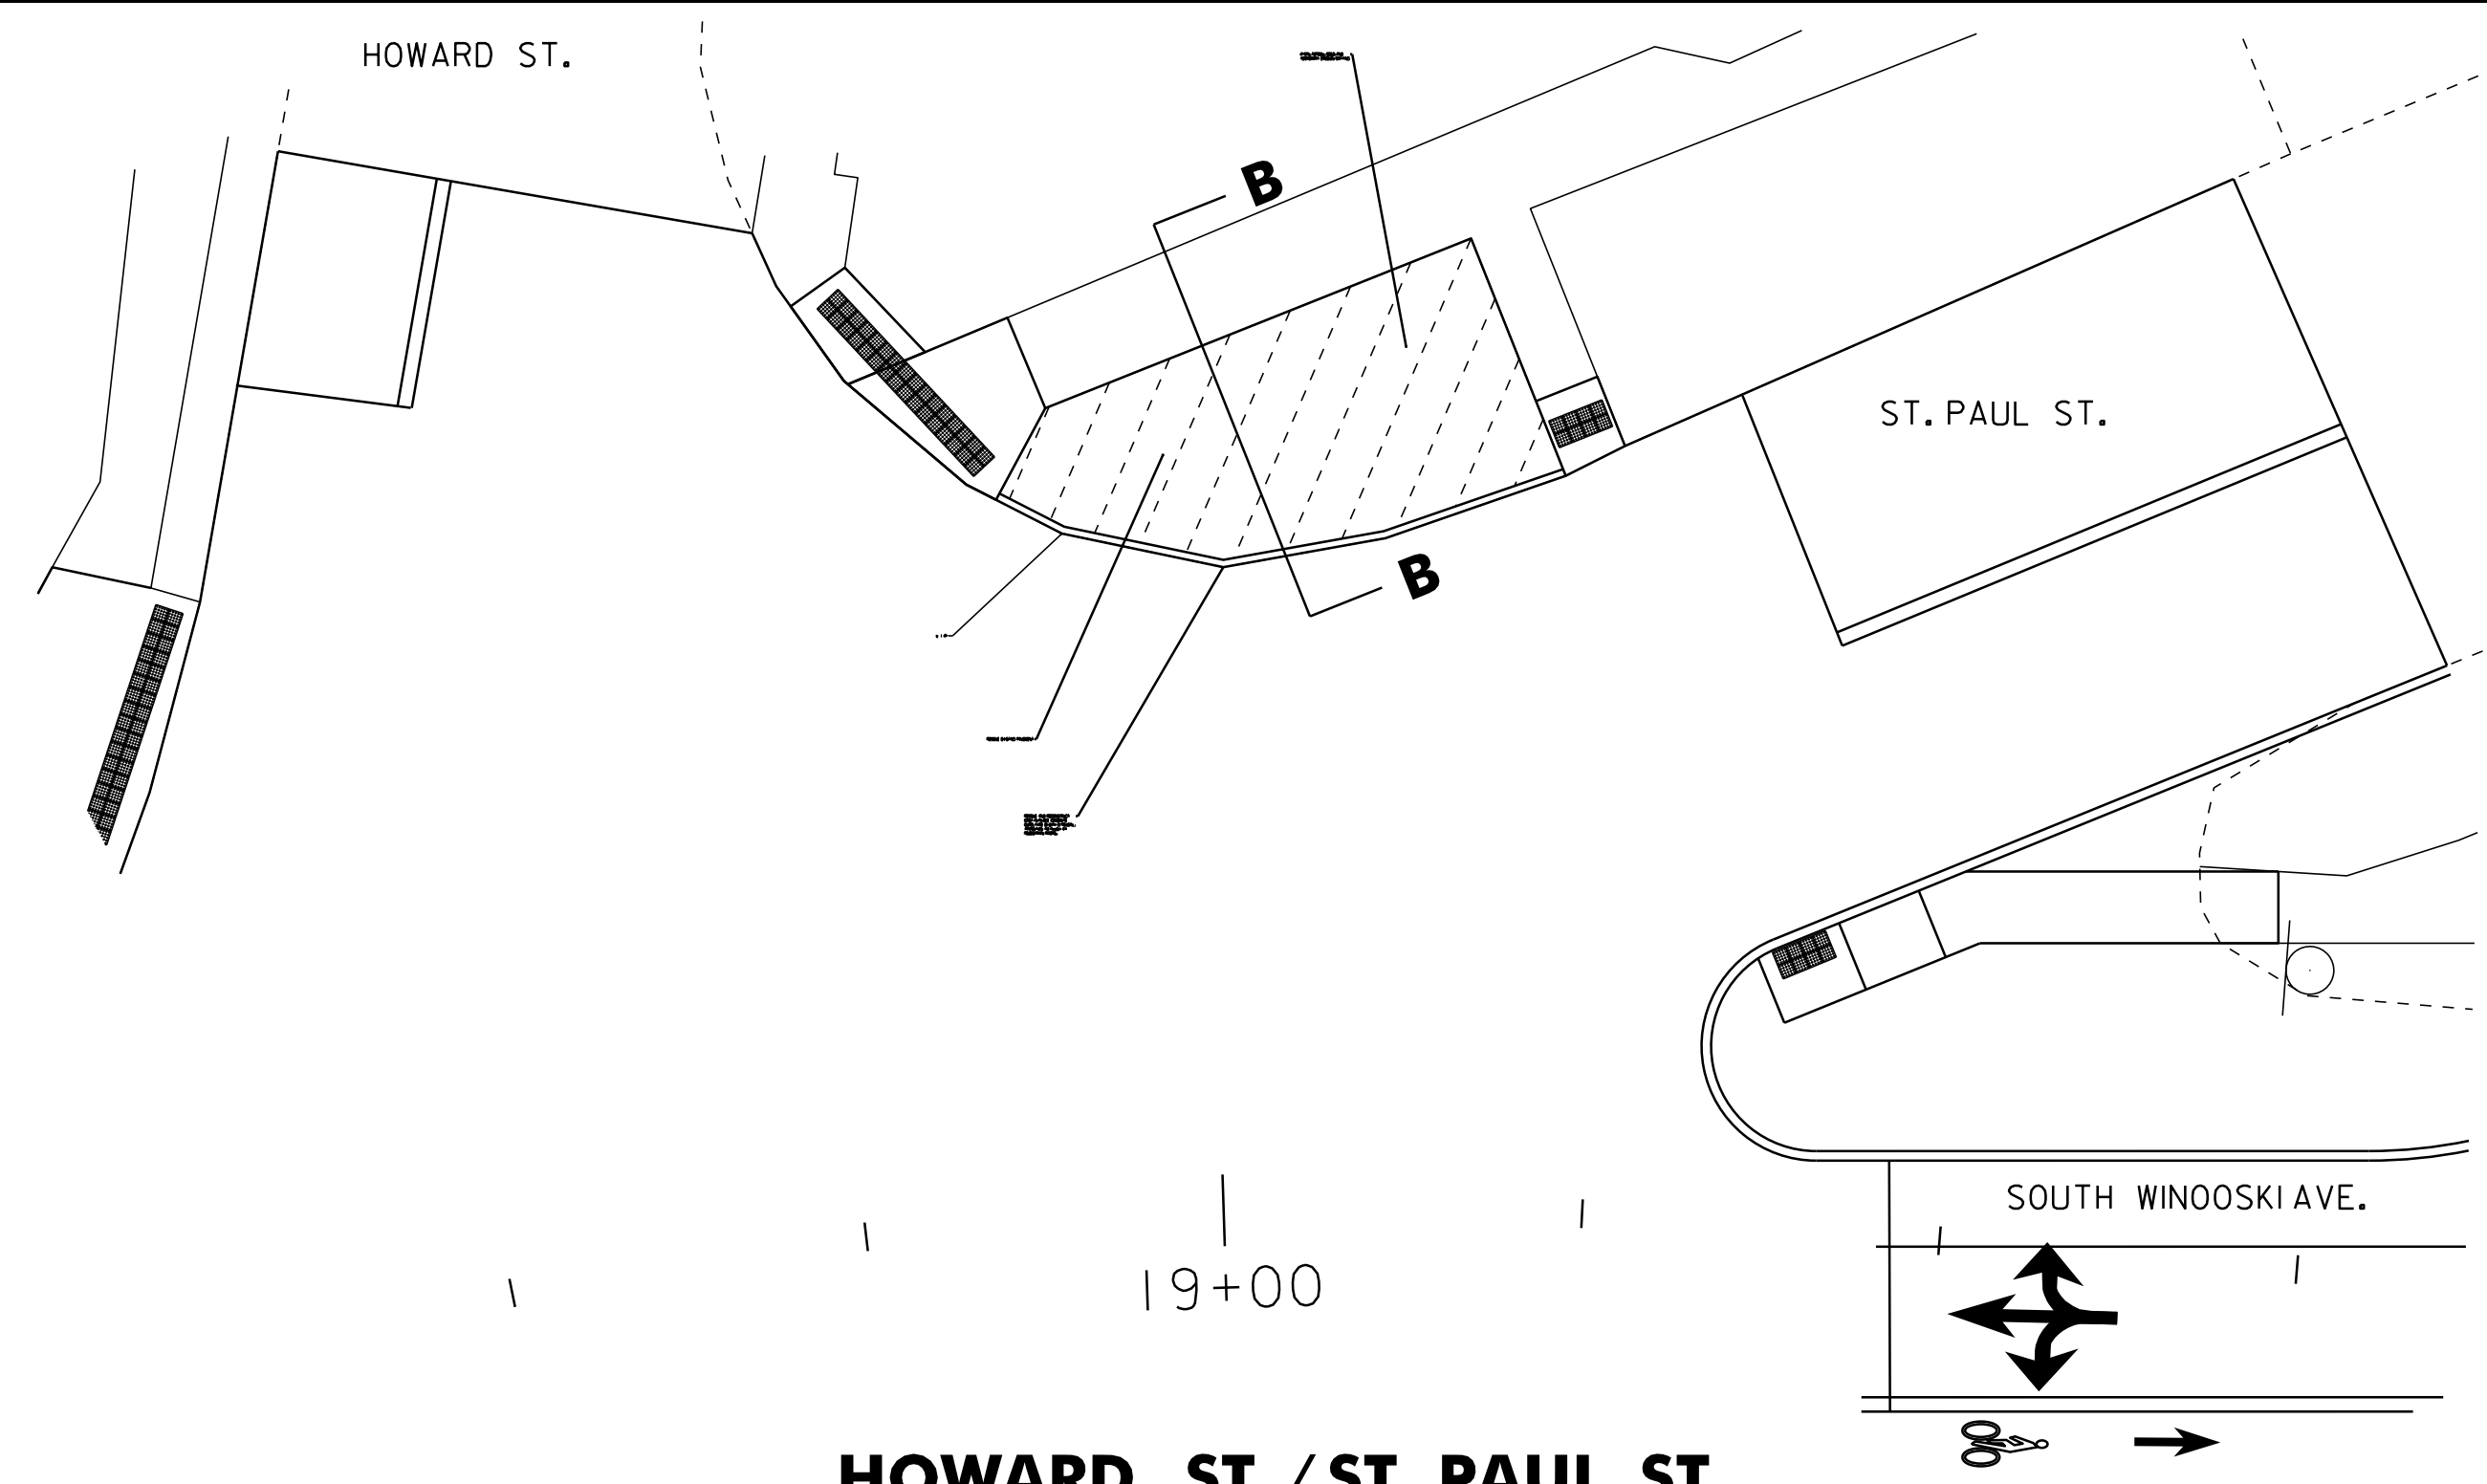

**HOWARD ST./ST. PAUL ST.
CURB RECONSTRUCTION**

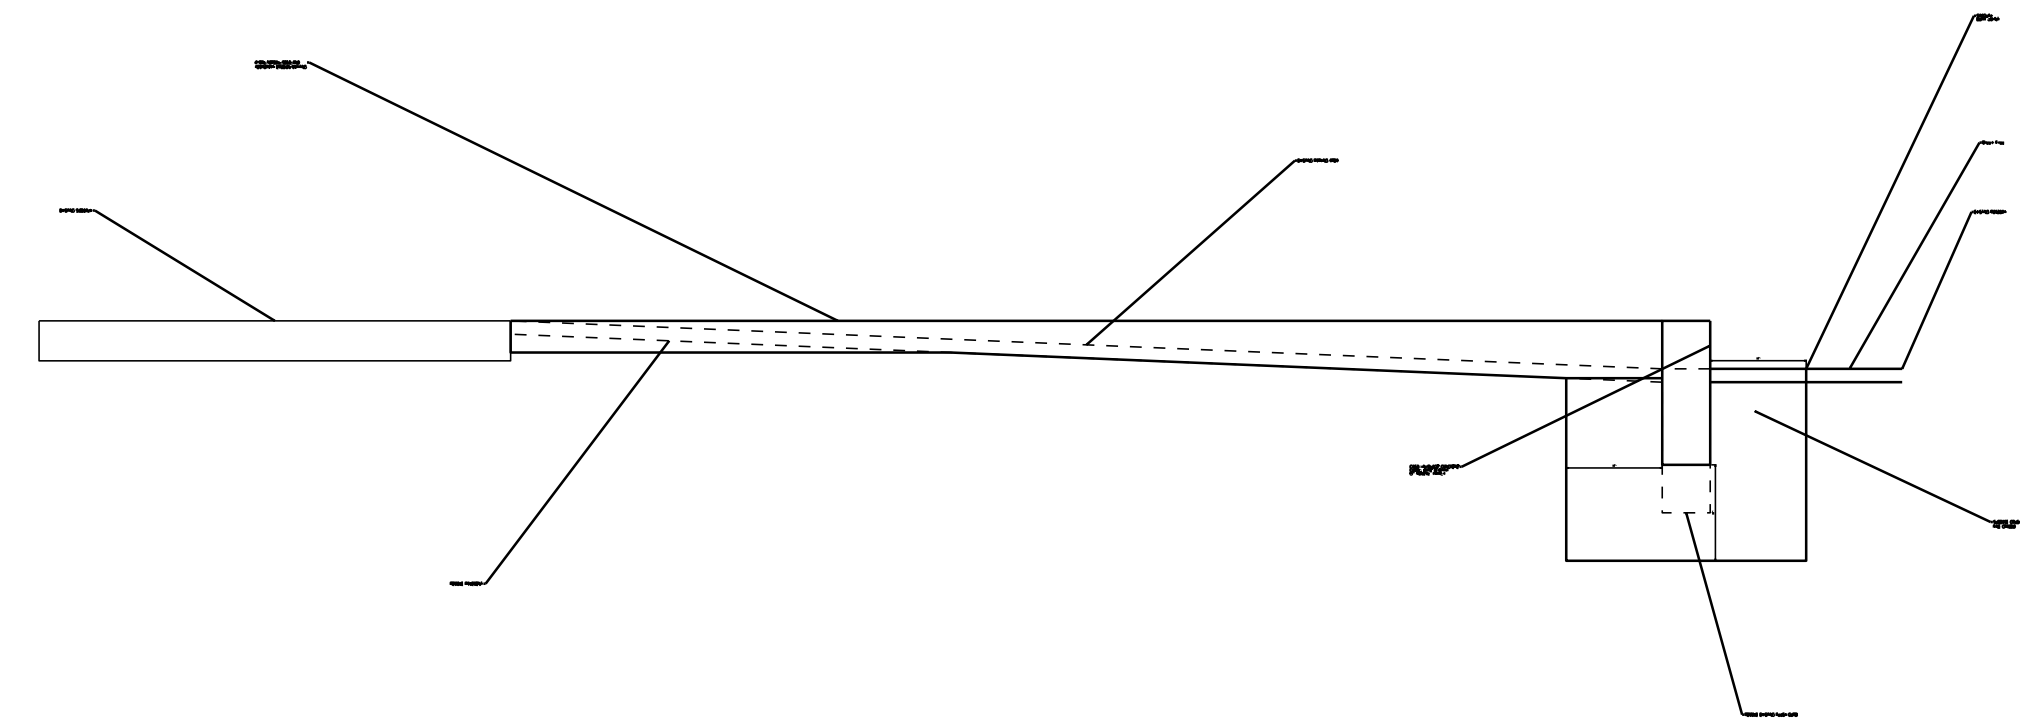

SECTION B-B

NOTES:

- CONTRACTOR TO REMOVE AND RECONSTRUCT EXISTING CURB AS SHOWN IN DETAIL.
- REGRADED AREA TO BE TOPPED WITH TOPSOIL, SEED, AND TEMPORARY EROSION MATTING TO THE EXTENTS SHOWN ON PLANS.

NOT TO SCALE

TRAFFIC SIGNS AND DETAILS SHEET 4	PROJECT NAME: BURLINGTON (CLASS I)	PLOT DATE: 05-JUN-2014 11:22
	PROJECT NUMBER: STP 2722 (I)	DRAWN BY: SJL
	FILE NAME: 07d028.dgn	CHECKED BY: EPD
	PROJECT LEADER: CDL	SHEET 57 OF 61
	DESIGNED BY: SJL	
	PLOT FILE: 07d028_57.i	