



SEE LAYOUT SHEETS FOR LOCATIONS.  
ALL BLOCK PATTERN CROSS WALKS SHALL BE  
INSTALLED PARALLEL WITH WHEEL PATHS.  
**SKewed CROSSWALK PATTERN DETAIL**  
• MAY VARY WITH 11' OR 12' LANE

**BEGIN STP 2704(1) U.S. ROUTE 5**  
**NEWPORT CITY STA. 0+00.00 = MM 0.000**

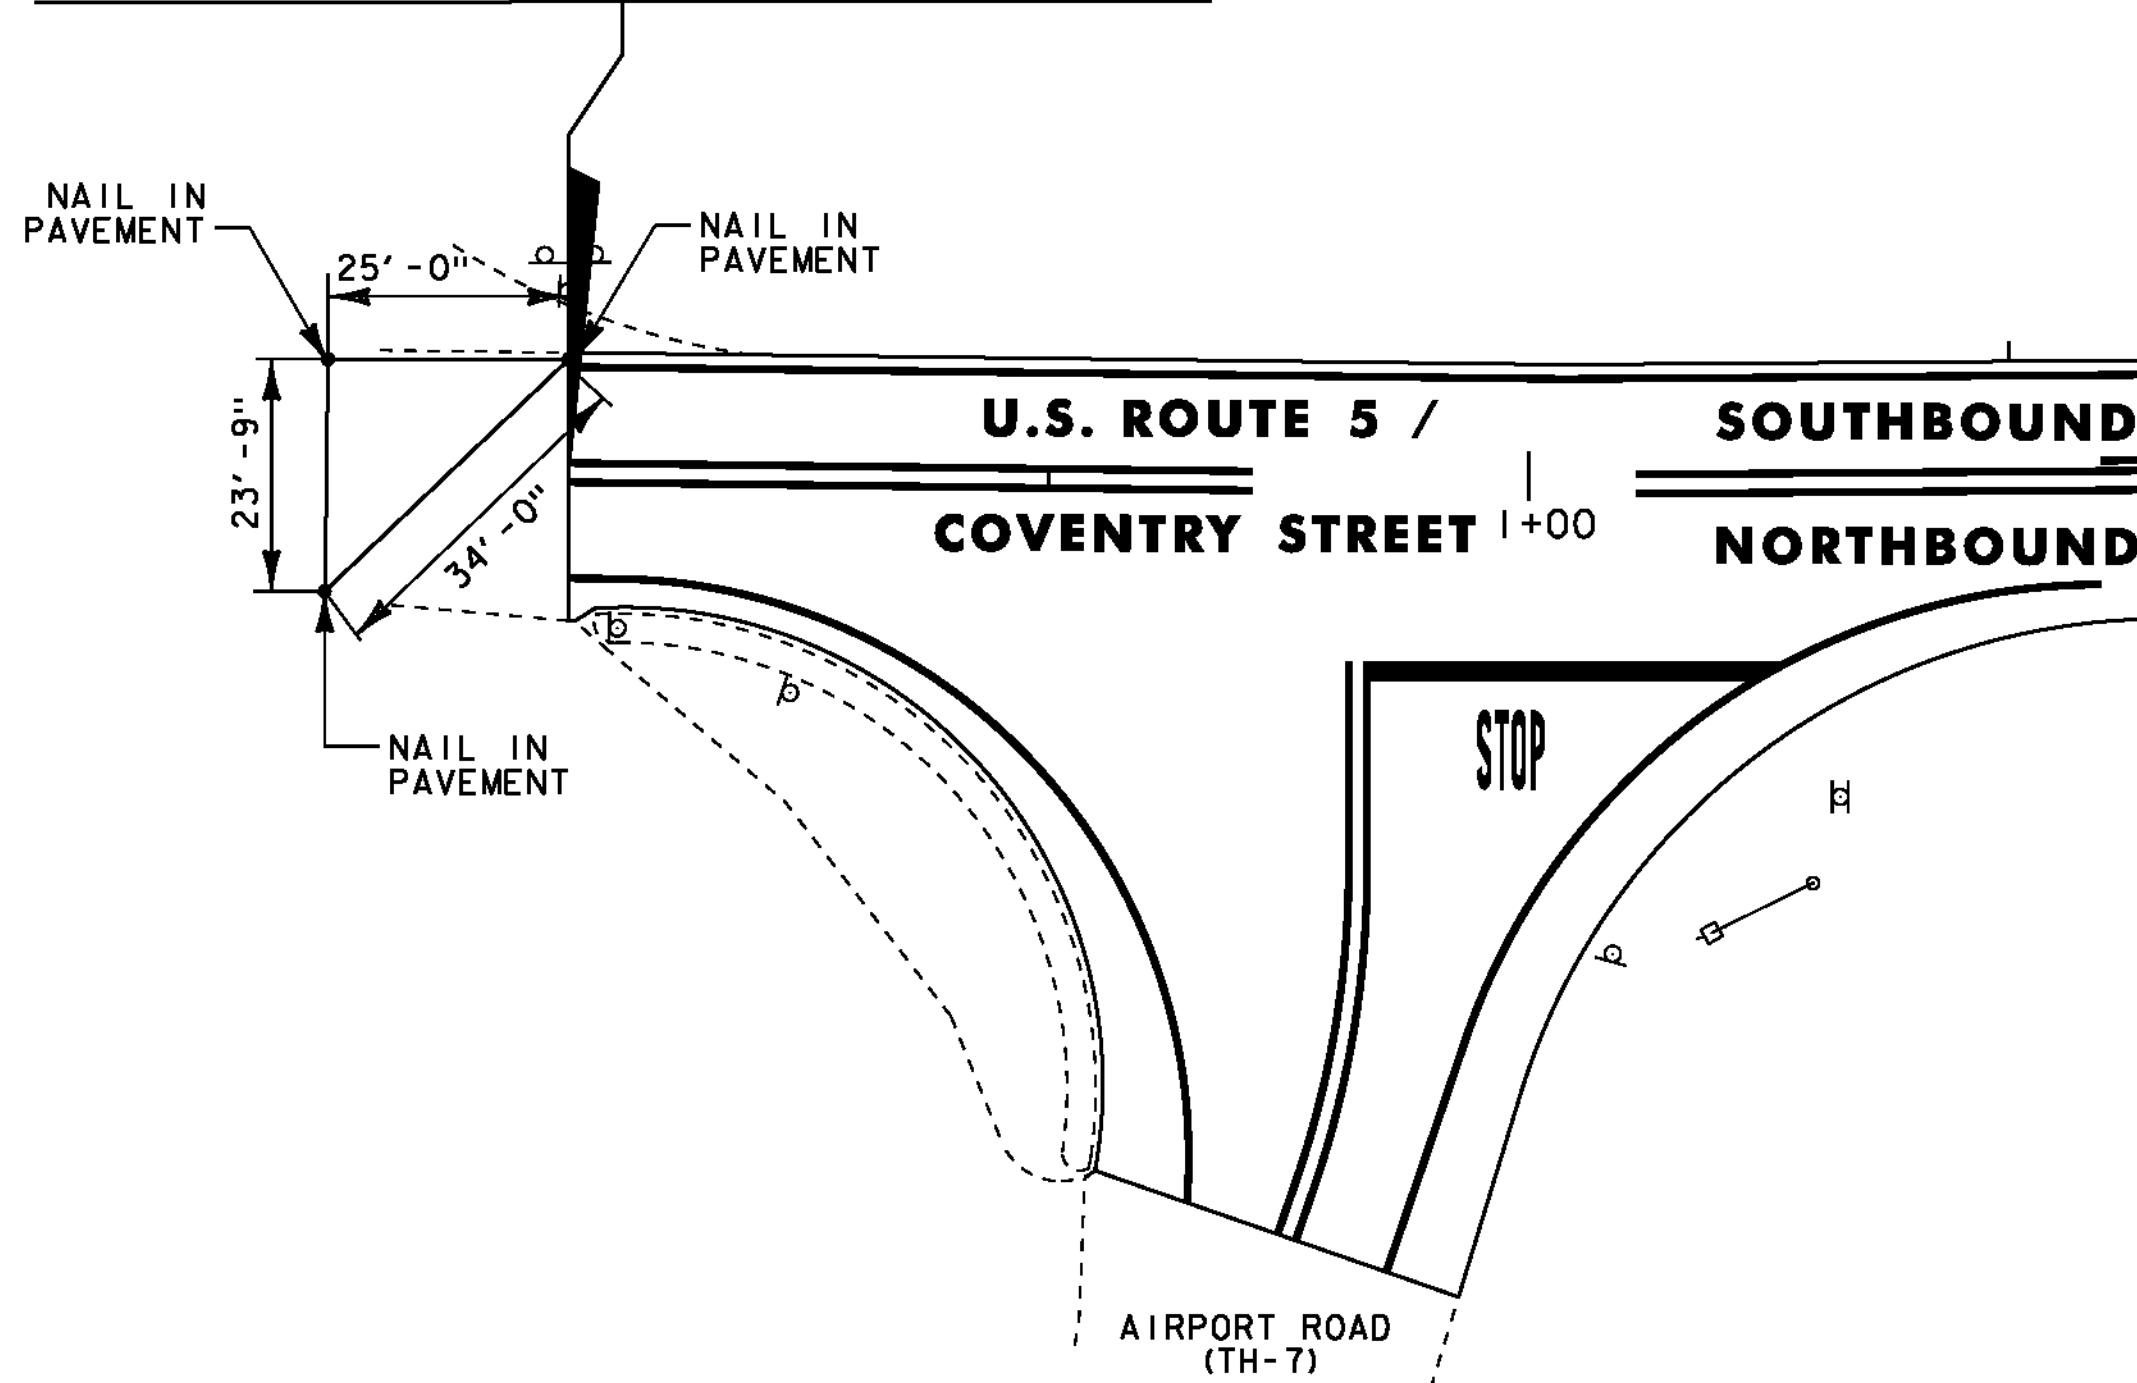


**U.S. ROUTE 5 BEGIN PROJECT LOCATION TIES**

**END STP 2704(1) U.S. ROUTE 5**  
**NEWPORT CITY STA. 205+33.92 = MM 3.889**

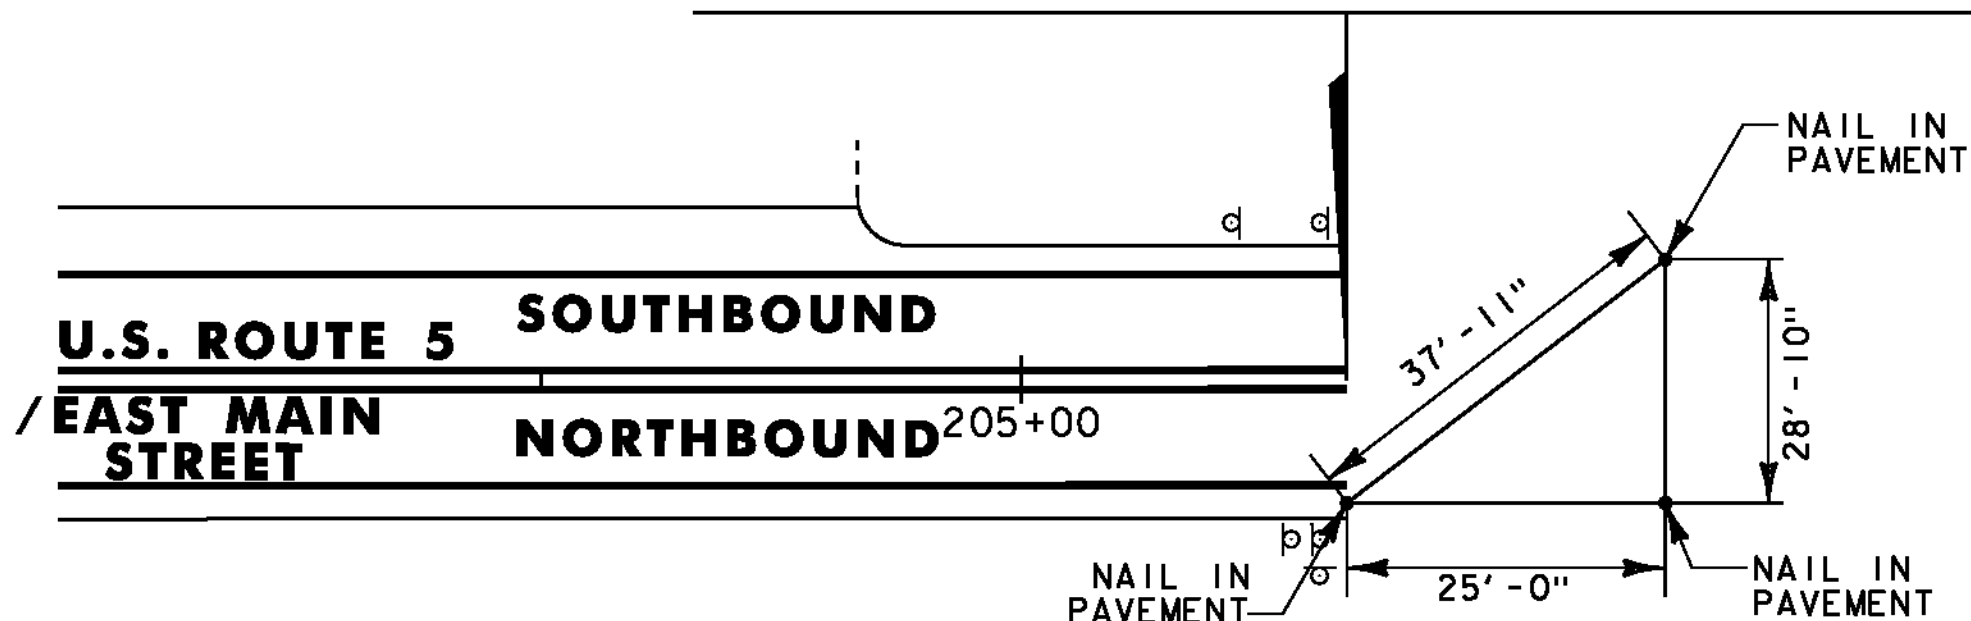


**U.S. ROUTE 5 END PROJECT LOCATION TIES**

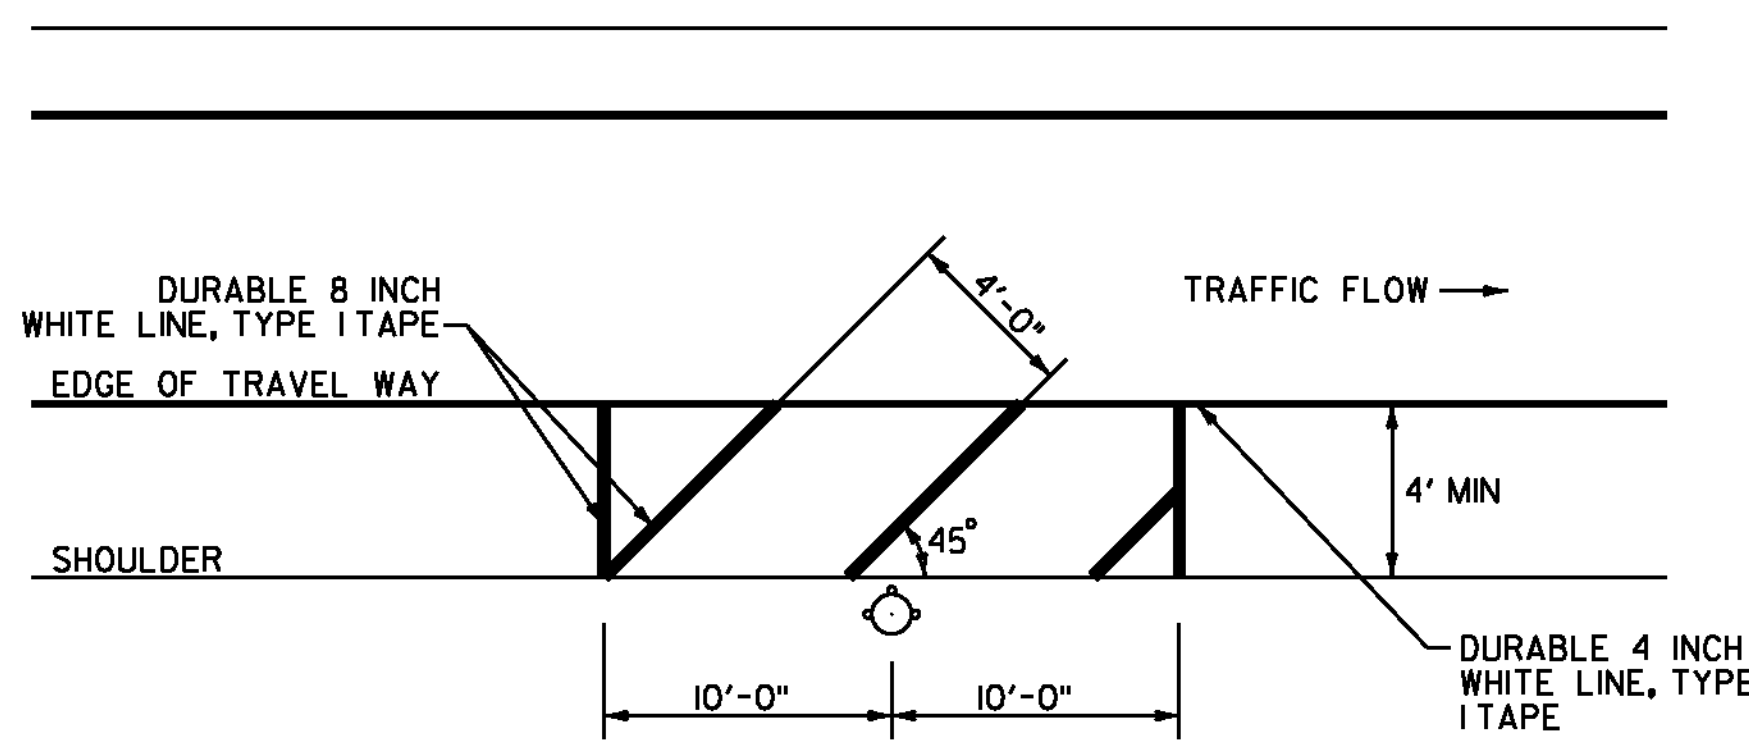

**FIRE HYDRANT PAVEMENT MARKING DETAIL**


- U.S. ROUTE 5 STA. 68+71, LT
- U.S. ROUTE 5 STA. 74+49, LT
- U.S. ROUTE 5 STA. 85+13, LT
- U.S. ROUTE 5 STA. 113+54, LT
- U.S. ROUTE 5 STA. 119+18, LT
- U.S. ROUTE 5 STA. 127+68, LT
- U.S. ROUTE 5 STA. 176+32, LT
- U.S. ROUTE 5 STA. 180+58, LT
- U.S. ROUTE 5 STA. 183+78, LT
- U.S. ROUTE 5 STA. 187+38, LT

**NOTE:**  
THE CONTRACTOR SHALL ADJUST THE PLACEMENT OF THE FIRE  
HYDRANT PAVEMENT MARKINGS TO MEET THE EXISTING SITE  
CONSTRAINTS AS DIRECTED BY THE RESIDENT ENGINEER.

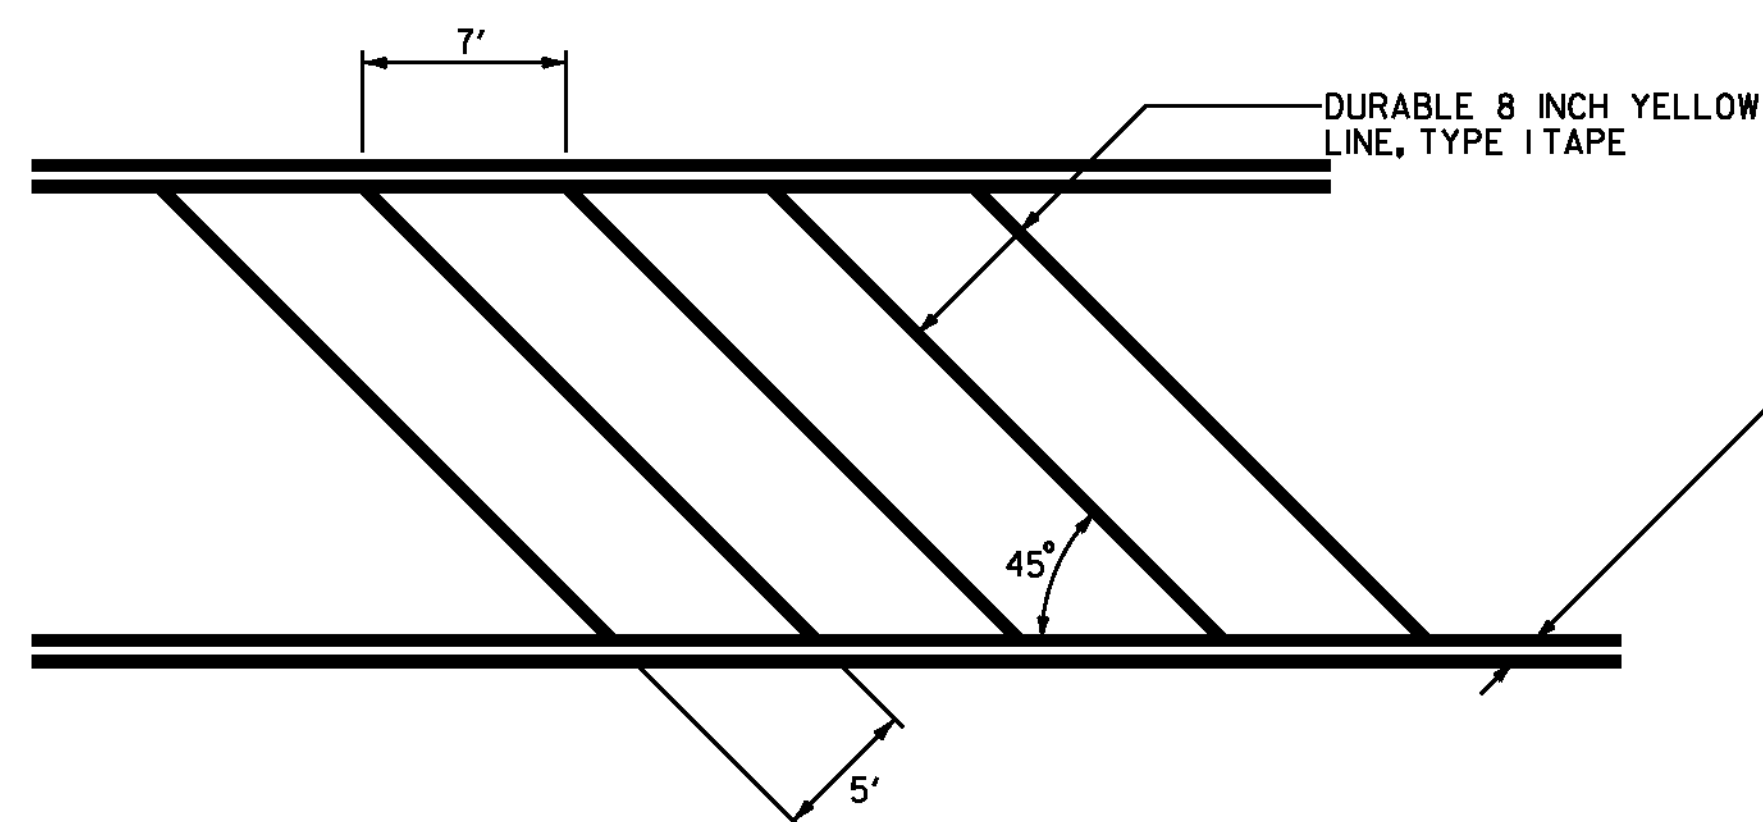

**PAINTED ISLAND DETAIL**

- SEE LAYOUT SHEETS FOR LOCATIONS
- U.S. ROUTE 5 STA. 76+20-77+07, LT & RT
- U.S. ROUTE 5 STA. 84+29-85+53, LT
- U.S. ROUTE 5 STA. 85+92-86+00, RT
- U.S. ROUTE 5 STA. 93+23-93+89, LT & RT
- U.S. ROUTE 5 STA. 96+98-98+63, LT & RT
- U.S. ROUTE 5 STA. 105+27-106+67, LT & RT
- U.S. ROUTE 5 STA. 132+75-133+58, LT & RT
- U.S. ROUTE 5 STA. 136+08-136+60, RT

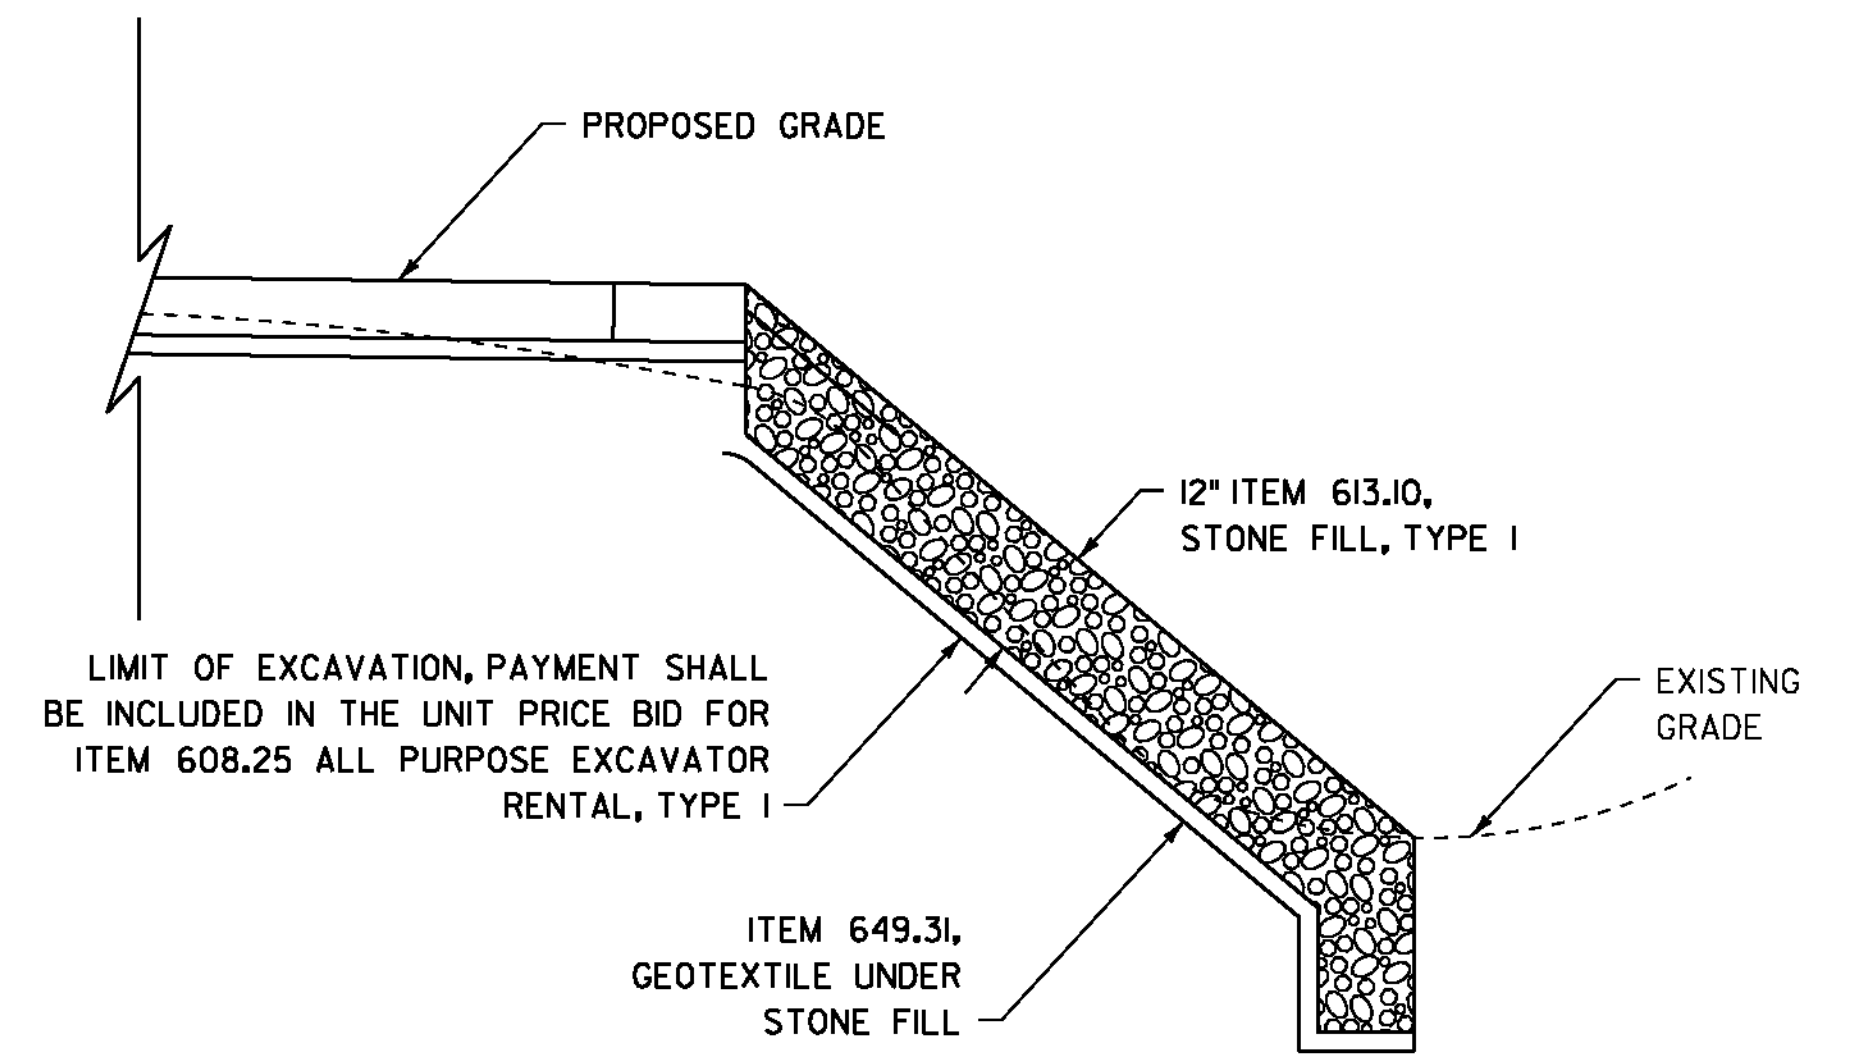


**SLOPE EROSION PREVENTION DETAIL**

U.S. ROUTE 5 STA. 163+92 TO 164+02, RT (10 FT)

**NOTE:**

AN ESTIMATED QUANTITY OF ITEM 613.11 STONE FILL, TYPE II HAS  
BEEN INCLUDED AS AN OPTION FOR USE, AS DIRECTED BY THE  
RESIDENT ENGINEER. IF ITEM 613.11 IS NECESSARY, THE ADDITIONAL  
EXCAVATION DEPTH REQUIRED WILL BE PAID AS ITEM 608.25 ALL  
PURPOSE EXCAVATOR RENTAL, TYPE I.

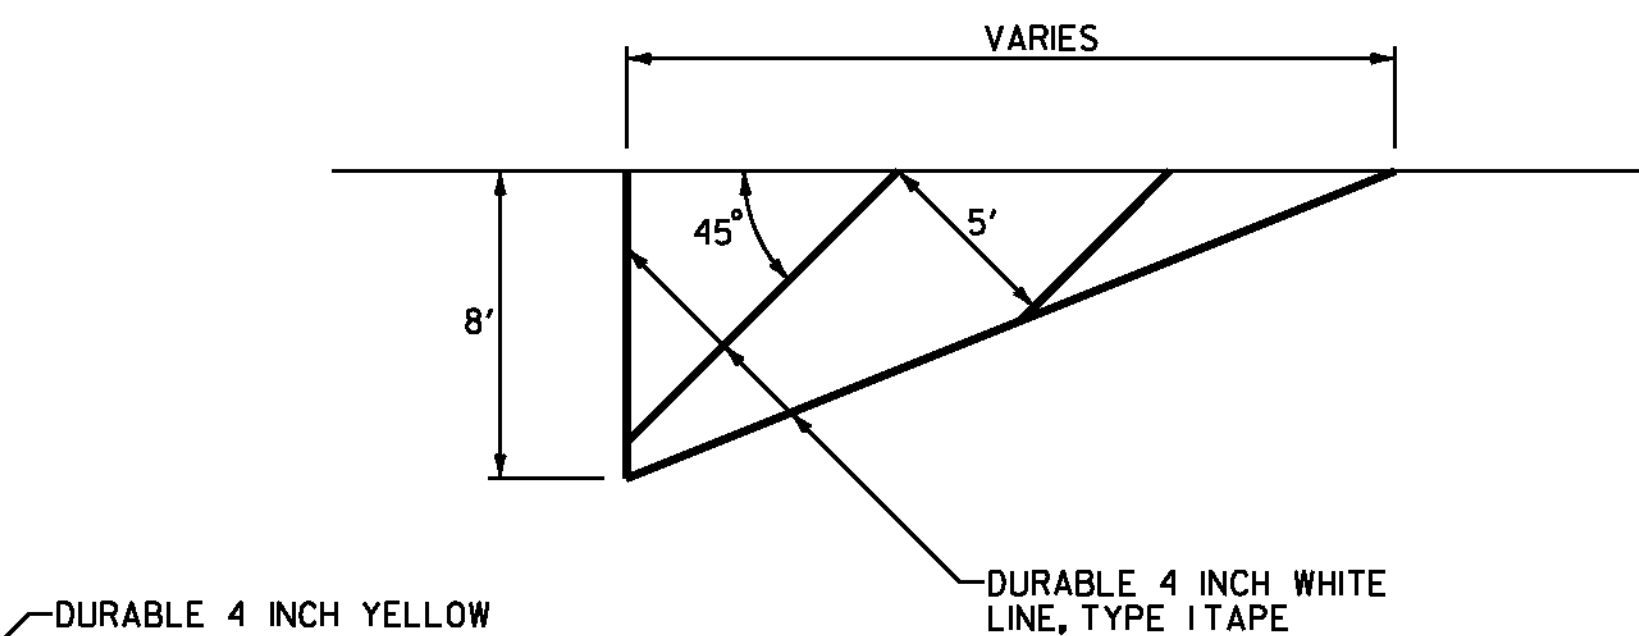

**NO PARKING PAVEMENT MARKING DETAIL**

- U.S. ROUTE 5 STA. 71+57, RT
- U.S. ROUTE 5 STA. 71+65, LT
- U.S. ROUTE 5 STA. 73+28, RT
- U.S. ROUTE 5 STA. 74+13, RT
- U.S. ROUTE 5 STA. 74+15, LT
- U.S. ROUTE 5 STA. 76+78, LT
- U.S. ROUTE 5 STA. 76+78, RT
- U.S. ROUTE 5 STA. 77+06, LT
- U.S. ROUTE 5 STA. 79+40, RT
- U.S. ROUTE 5 STA. 79+52, LT
- U.S. ROUTE 5 STA. 80+96, LT
- U.S. ROUTE 5 STA. 82+35, RT
- U.S. ROUTE 5 STA. 83+77, RT
- U.S. ROUTE 5 STA. 86+34, RT

NOT TO SCALE

**MISCELLANEOUS  
DETAIL  
SHEET #1**

PROJECT NAME: NEWPORT CITY  
PROJECT NUMBER: STP 2704(1)

FILE NAME: p07d196.dgn  
PROJECT LEADER: JLL  
DESIGNED BY: STANTEC  
IPARM FILE: p07d196md01.i

PLOT DATE: 03-APR-2012  
DRAWN BY: STANTEC  
CHECKED BY: STANTEC  
SHEET 15 OF 91

