


**DURABLE 4 INCH WHITE LINE**  
 (ALL LINES WILL INCLUDE EDGE LINE BREAKS  
 AND RADII FOR SIDE ROADS)  
 STA. 2+50 TO 8+50, SOLID LT & RT

**TEMPORARY 4 INCH WHITE LINE, PAINT**  
 (ALL LINES WILL INCLUDE EDGE LINE BREAKS  
 AND RADII FOR SIDE ROADS)  
 STA. 2+50 TO 8+50, SOLID LT & RT

**REMOVING SIGNS**  
 AS SHOWN - 1

**DURABLE 4 INCH YELLOW LINE**  
 (ALL LINES WILL INCLUDE  $\phi$  BREAKS FOR SIDE ROADS)  
 STA. 2+50 TO 8+50, SOLID LT & RT

**TEMPORARY 4 INCH YELLOW LINE, PAINT**  
 (ALL LINES WILL INCLUDE  $\phi$  BREAKS FOR SIDE ROADS)  
 STA. 2+50 TO 8+50, SOLID LT & RT

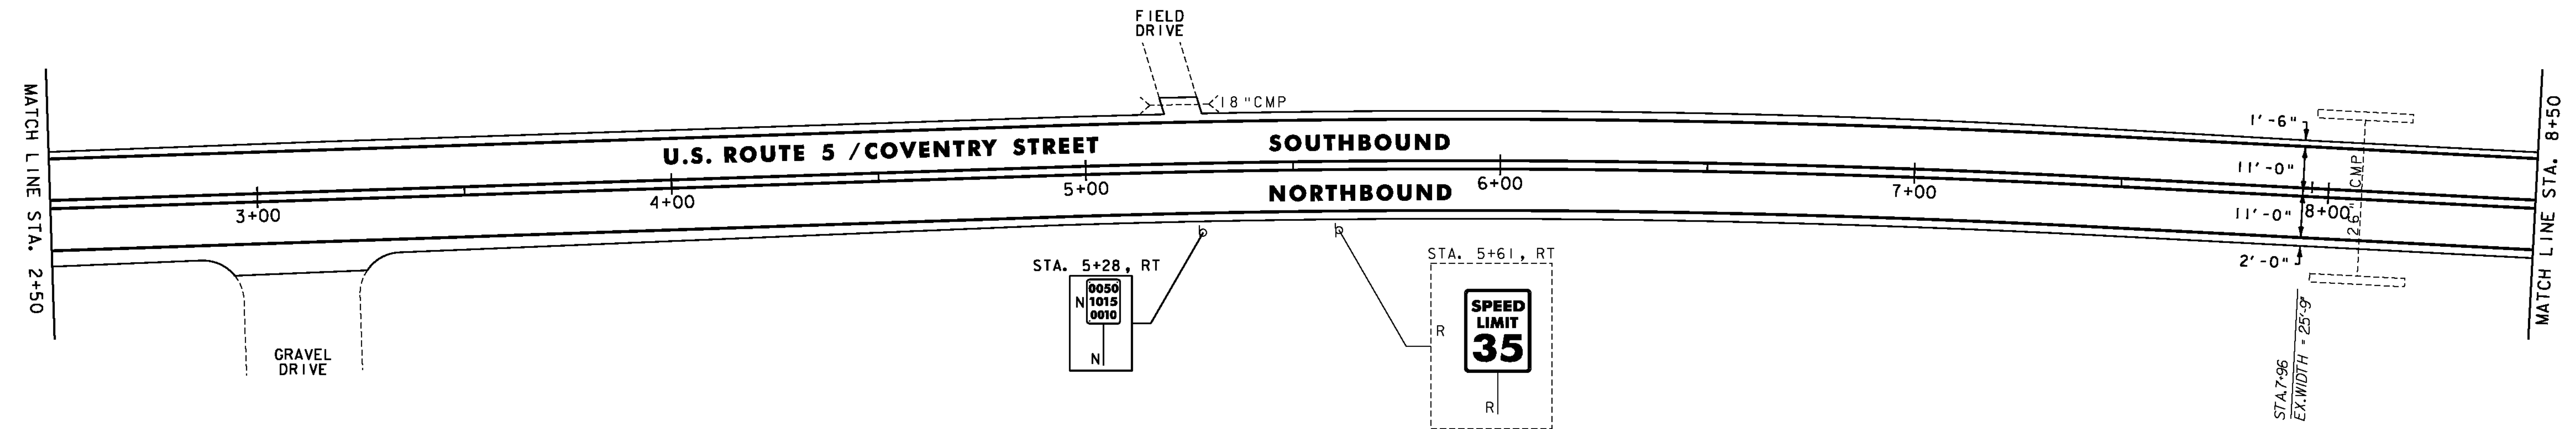


**DURABLE 4 INCH WHITE LINE**  
 (ALL LINES WILL INCLUDE EDGE LINE BREAKS  
 AND RADII FOR SIDE ROADS)  
 STA. 8+50 TO 14+50, SOLID LT & RT

**TEMPORARY 4 INCH WHITE LINE, PAINT**  
 (ALL LINES WILL INCLUDE EDGE LINE BREAKS  
 AND RADII FOR SIDE ROADS)  
 STA. 8+50 TO 14+50, SOLID LT & RT

**REMOVING SIGNS**  
 AS SHOWN - 1

**DURABLE 4 INCH YELLOW LINE**  
 (ALL LINES WILL INCLUDE  $\phi$  BREAKS FOR SIDE ROADS)  
 STA. 8+50 TO 14+50, SOLID LT & RT

**TEMPORARY 4 INCH YELLOW LINE, PAINT**  
 (ALL LINES WILL INCLUDE  $\phi$  BREAKS FOR SIDE ROADS)  
 STA. 8+50 TO 14+50, SOLID LT & RT

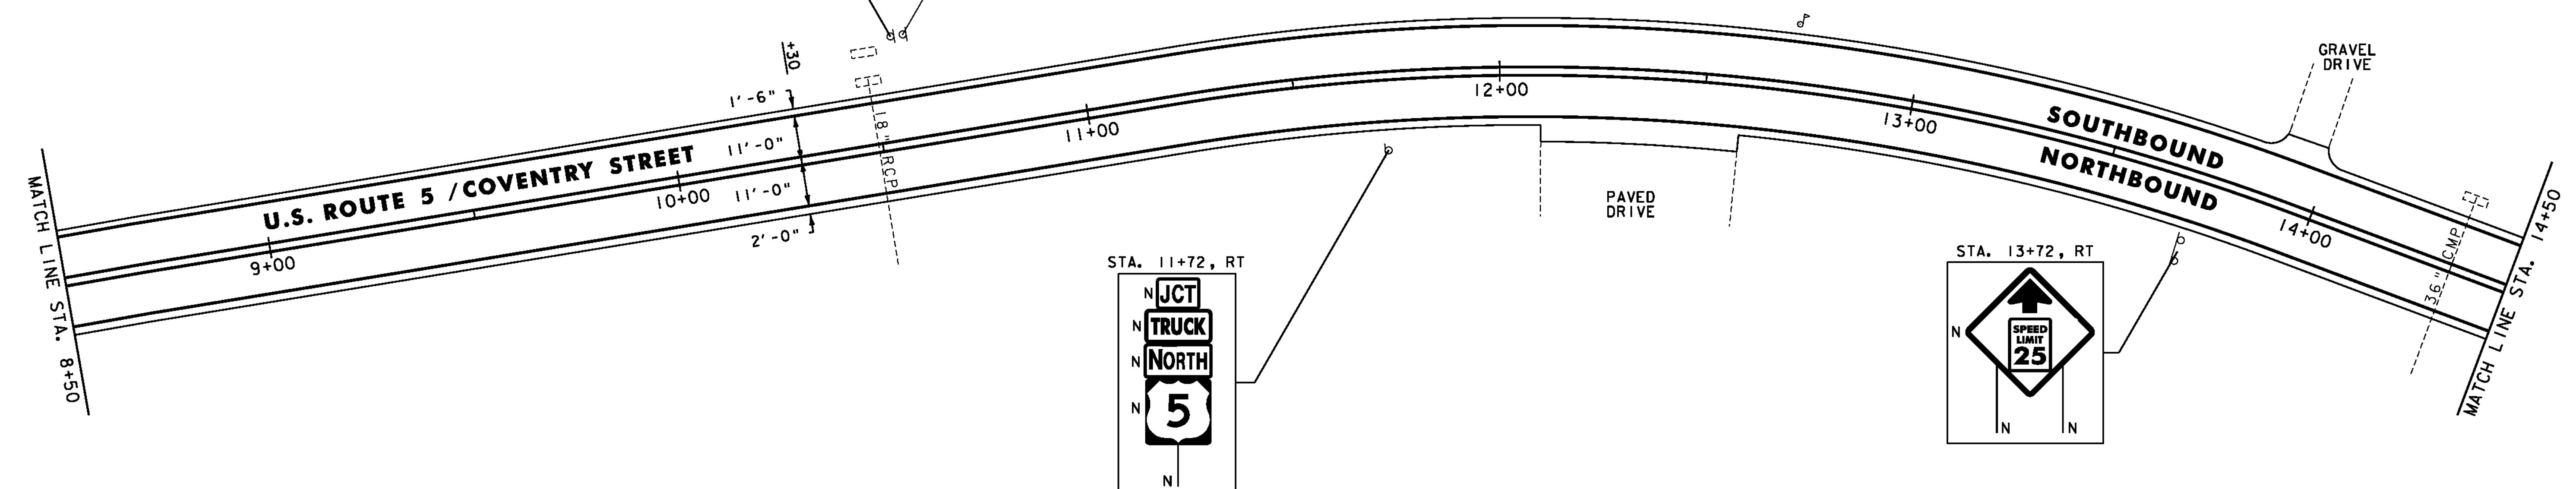

**NOTES:**

- FOR LEGEND, SEE SHEET #18.
- ALL EXISTING SIGNS NOT SHOWN SHALL BE RETAINED.

NOT TO SCALE

**PROJECT LAYOUT SHEET #2**

PROJECT NAME: NEWPORT CITY  
 PROJECT NUMBER: STP 2704(I)

FILE NAME: p07d196.dgn  
 PROJECT LEADER: JLL  
 DESIGNED BY: STANTEC  
 IPARM FILE: p07d196102.i

PLOT DATE: 3/6/2012  
 DRAWN BY: STANTEC  
 CHECKED BY: STANTEC  
 SHEET 19 OF 91

