

CHANGING ELEVATION OF SEWER MANHOLES
STA. 29+97, RT

TREATED TIMBER CURB
STA. 26+50 TO 26+73.5, RT

BITUMINOUS CONCRETE GUTTERS
AND TRAFFIC ISLANDS
WITH BREAKS FOR DRIVES AND SIDE ROADS
STA. 26+50 TO 32+50, LT

STEEL BEAM GUARDRAIL, GALVANIZED
STA. 32+15 TO 32+50, RT

STEEL BEAM GUARDRAIL, GALVANIZED
W/8 FEET POSTS
STA. 26+50 TO 28+53.5, RT

ANCHOR FOR STEEL BEAM RAIL
STA. 28+53.5, RT

STA. 32+15, RT

REMOVAL AND DISPOSAL OF GUARDRAIL
STA. 26+50 TO 28+53.5, RT

STA. 32+13 TO 32+50, RT


DURABLE 4 INCH WHITE LINE
(ALL LINES WILL INCLUDE EDGE LINE BREAKS
AND RADII FOR SIDE ROADS)
STA. 26+50 TO 32+50, SOLID LT & RT

DURABLE 4 INCH YELLOW LINE
(ALL LINES WILL INCLUDE C BREAKS FOR SIDE ROADS)
STA. 26+50 TO 32+50, SOLID LT & RT

TEMPORARY 4 INCH WHITE LINE, PAINT
(ALL LINES WILL INCLUDE EDGE LINE BREAKS
AND RADII FOR SIDE ROADS)
STA. 26+50 TO 32+50, SOLID LT & RT

TEMPORARY 4 INCH YELLOW LINE, PAINT
(ALL LINES WILL INCLUDE C BREAKS FOR SIDE ROADS)
STA. 26+50 TO 32+50, SOLID LT & RT

REMOVING SIGNS
AS SHOWN - 2

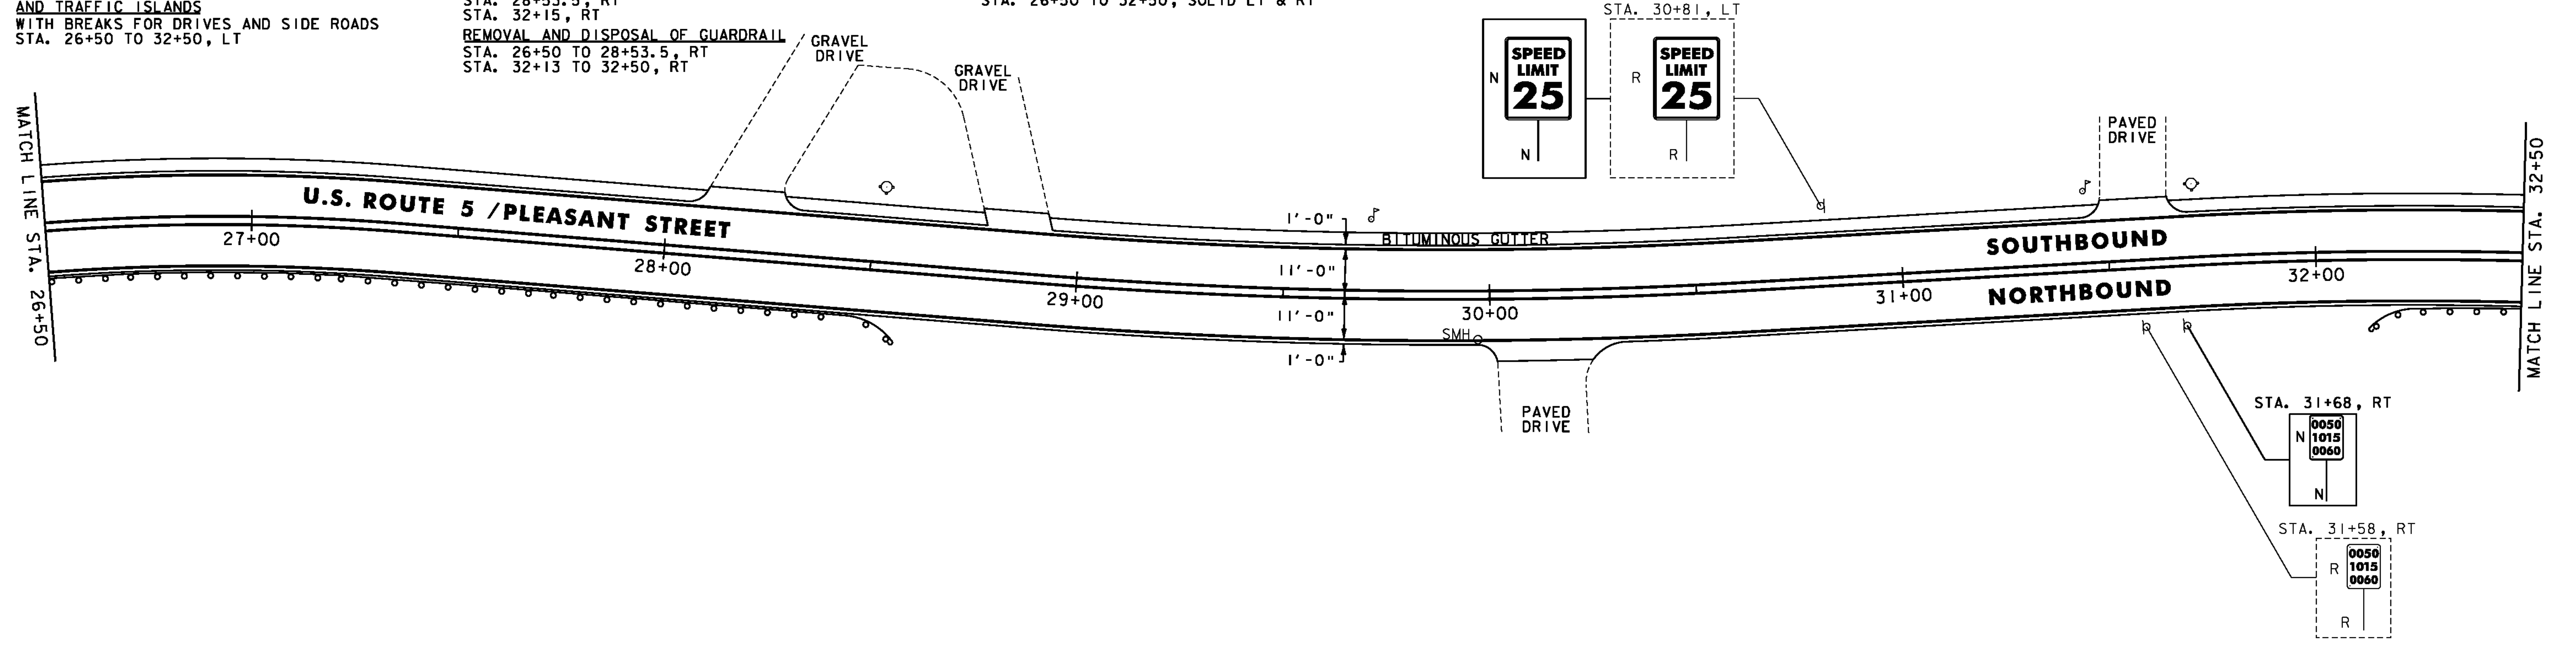

CHANGING ELEVATION OF SEWER MANHOLES
STA. 32+97, C

BITUMINOUS CONCRETE GUTTERS
AND TRAFFIC ISLANDS
WITH BREAKS FOR DRIVES AND SIDE ROADS
STA. 32+50 TO 38+50, LT

STEEL BEAM GUARDRAIL, GALVANIZED
STA. 32+50 TO 33+77.5, RT

ANCHOR FOR STEEL BEAM RAIL
STA. 33+77.5, RT

REMOVAL AND DISPOSAL OF GUARDRAIL
STA. 32+50 TO 33+72.5, RT

ADJUST ELEVATION OF VALVE BOX
STA. 36+00, RT

STA. 36+38, RT


DURABLE 4 INCH WHITE LINE
(ALL LINES WILL INCLUDE EDGE LINE BREAKS
AND RADII FOR SIDE ROADS)
STA. 32+50 TO 38+50, SOLID LT & RT

DURABLE 4 INCH YELLOW LINE
(ALL LINES WILL INCLUDE C BREAKS FOR SIDE ROADS)
STA. 32+50 TO 38+50, SOLID LT & RT

TEMPORARY 4 INCH WHITE LINE, PAINT
(ALL LINES WILL INCLUDE EDGE LINE BREAKS
AND RADII FOR SIDE ROADS)
STA. 32+50 TO 38+50, SOLID LT & RT

TEMPORARY 4 INCH YELLOW LINE, PAINT
(ALL LINES WILL INCLUDE C BREAKS FOR SIDE ROADS)
STA. 32+50 TO 38+50, SOLID LT & RT

REMOVING SIGNS
AS SHOWN - 1

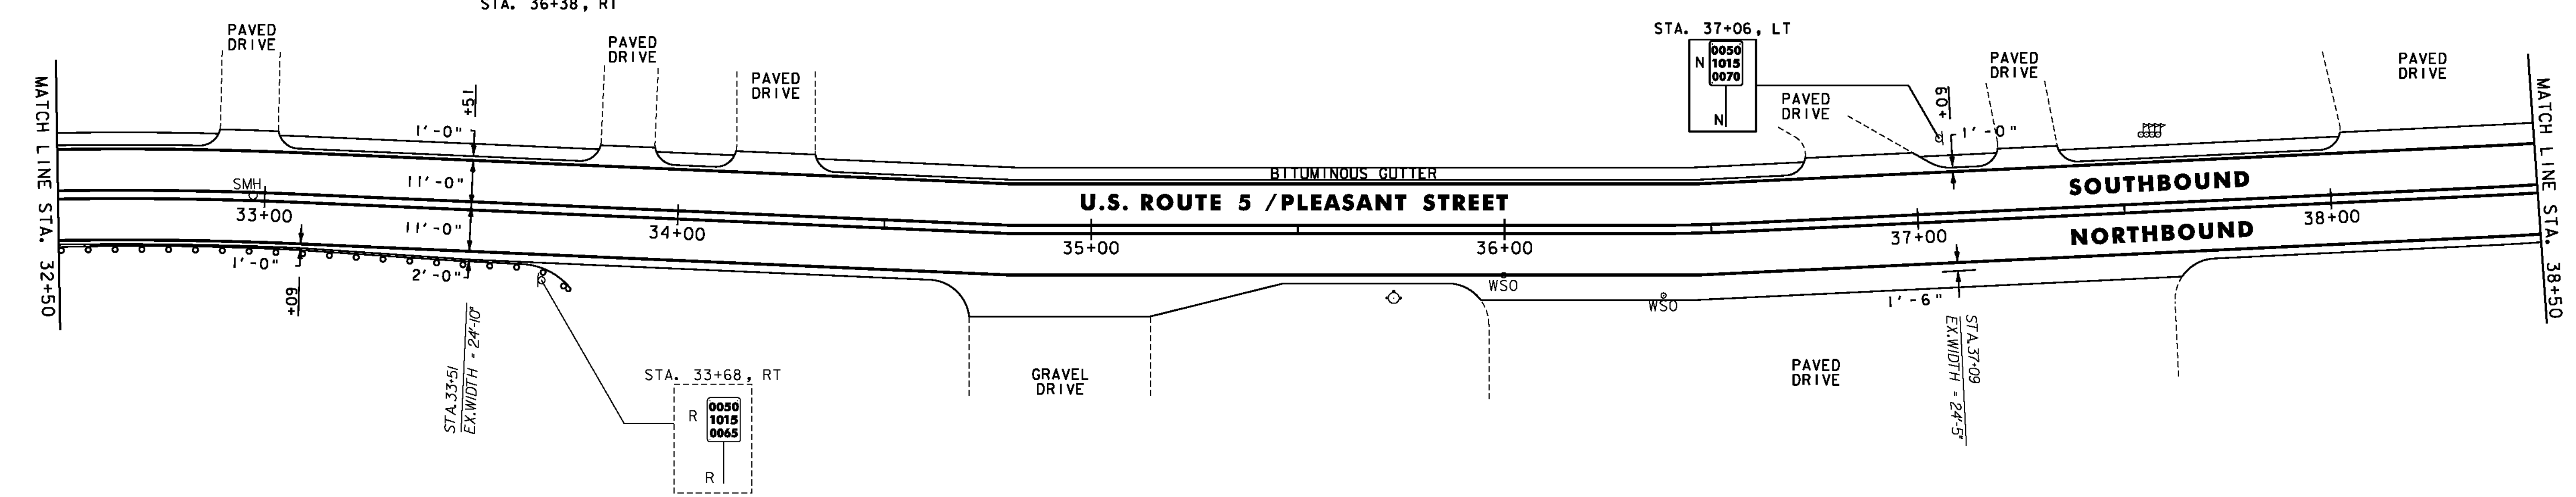

NOTES:

- FOR LEGEND, SEE SHEET #18.
- ALL EXISTING SIGNS NOT SHOWN SHALL BE RETAINED.



NOT TO SCALE

PROJECT LAYOUT SHEET #4

PROJECT NAME: NEWPORT CITY	PLOT DATE: 3/6/2012
PROJECT NUMBER: STP 2704(I)	DRAWN BY: STANTEC
FILE NAME: p07d196.dgn	CHECKED BY: STANTEC
PROJECT LEADER: JLL	SHEET 21 OF 91
DESIGNED BY: STANTEC	
IPARM FILE: p07d196104.i	