

REHAB Dis, CBs OR Mhs, CLASS I OR II  
 STA. 59+03, RT  
 STA. 59+08, LT

VERTICAL GRANITE CURB

STA. 56+50 TO 57+26, LT  
 STA. 57+44 TO 57+88, LT  
 STA. 58+04 TO 58+55, LT  
 STA. 58+70 TO 59+22, LT  
 STA. 59+41 TO 59+92, LT  
 STA. 60+09 TO 60+56, LT  
 STA. 60+82 TO 61+44, LT  
 STA. 61+67 TO 61+96, LT  
 STA. 62+22 TO 62+50, LT

REMOVAL OF EXISTING CURB

STA. 56+50 TO 57+26, LT  
 STA. 57+44 TO 57+88, LT  
 STA. 58+04 TO 58+55, LT  
 STA. 58+70 TO 59+22, LT  
 STA. 59+41 TO 59+92, LT  
 STA. 60+09 TO 60+56, LT  
 STA. 60+82 TO 61+44, LT  
 STA. 61+67 TO 61+96, LT  
 STA. 62+22 TO 62+50, LT

PORTLAND CEMENT CONCRETE SIDEWALK, 5 INCH

STA. 56+50 TO 57+26, LT  
 STA. 57+44 TO 57+88, LT  
 STA. 58+04 TO 58+55, LT  
 STA. 58+70 TO 59+22, LT  
 STA. 59+41 TO 59+92, LT  
 STA. 60+09 TO 60+56, LT  
 STA. 60+82 TO 61+44, LT  
 STA. 61+67 TO 61+96, LT  
 STA. 62+22 TO 62+50, LT

PORTLAND CEMENT CONCRETE SIDEWALK, 8 INCH

STA. 57+26 TO 57+44, LT  
 STA. 57+88 TO 58+04, LT  
 STA. 58+55 TO 58+70, LT  
 STA. 59+22 TO 59+41, LT  
 STA. 59+92 TO 60+09, LT  
 STA. 60+56 TO 60+82, LT  
 STA. 61+44 TO 61+67, LT  
 STA. 61+96 TO 62+22, LT

DURABLE 4 INCH WHITE LINE  
 (ALL LINES WILL INCLUDE EDGE LINE BREAKS AND RADII FOR SIDE ROADS)  
 STA. 56+50 TO 62+50, SOLID LT & RT

DURABLE 4 INCH YELLOW LINE  
 (ALL LINES WILL INCLUDE C BREAKS FOR SIDE ROADS)  
 STA. 56+50 TO 62+50, SOLID LT & RT


DURABLE LETTER OR SYMBOL  
 STA. 60+78, RT "STOP"  
 STA. 61+18, RT "AHEAD"

TEMPORARY 4 INCH WHITE LINE, PAINT  
 (ALL LINES WILL INCLUDE EDGE LINE BREAKS AND RADII FOR SIDE ROADS)  
 STA. 56+50 TO 62+50, SOLID LT & RT

TEMPORARY 4 INCH YELLOW LINE, PAINT  
 (ALL LINES WILL INCLUDE C BREAKS FOR SIDE ROADS)  
 STA. 56+50 TO 62+50, SOLID LT & RT

TEMPORARY LETTER OR SYMBOL, PAINT  
 STA. 60+78, RT "STOP"  
 STA. 61+18, RT "AHEAD"

REMOVING SIGNS  
 AS SHOWN - 2

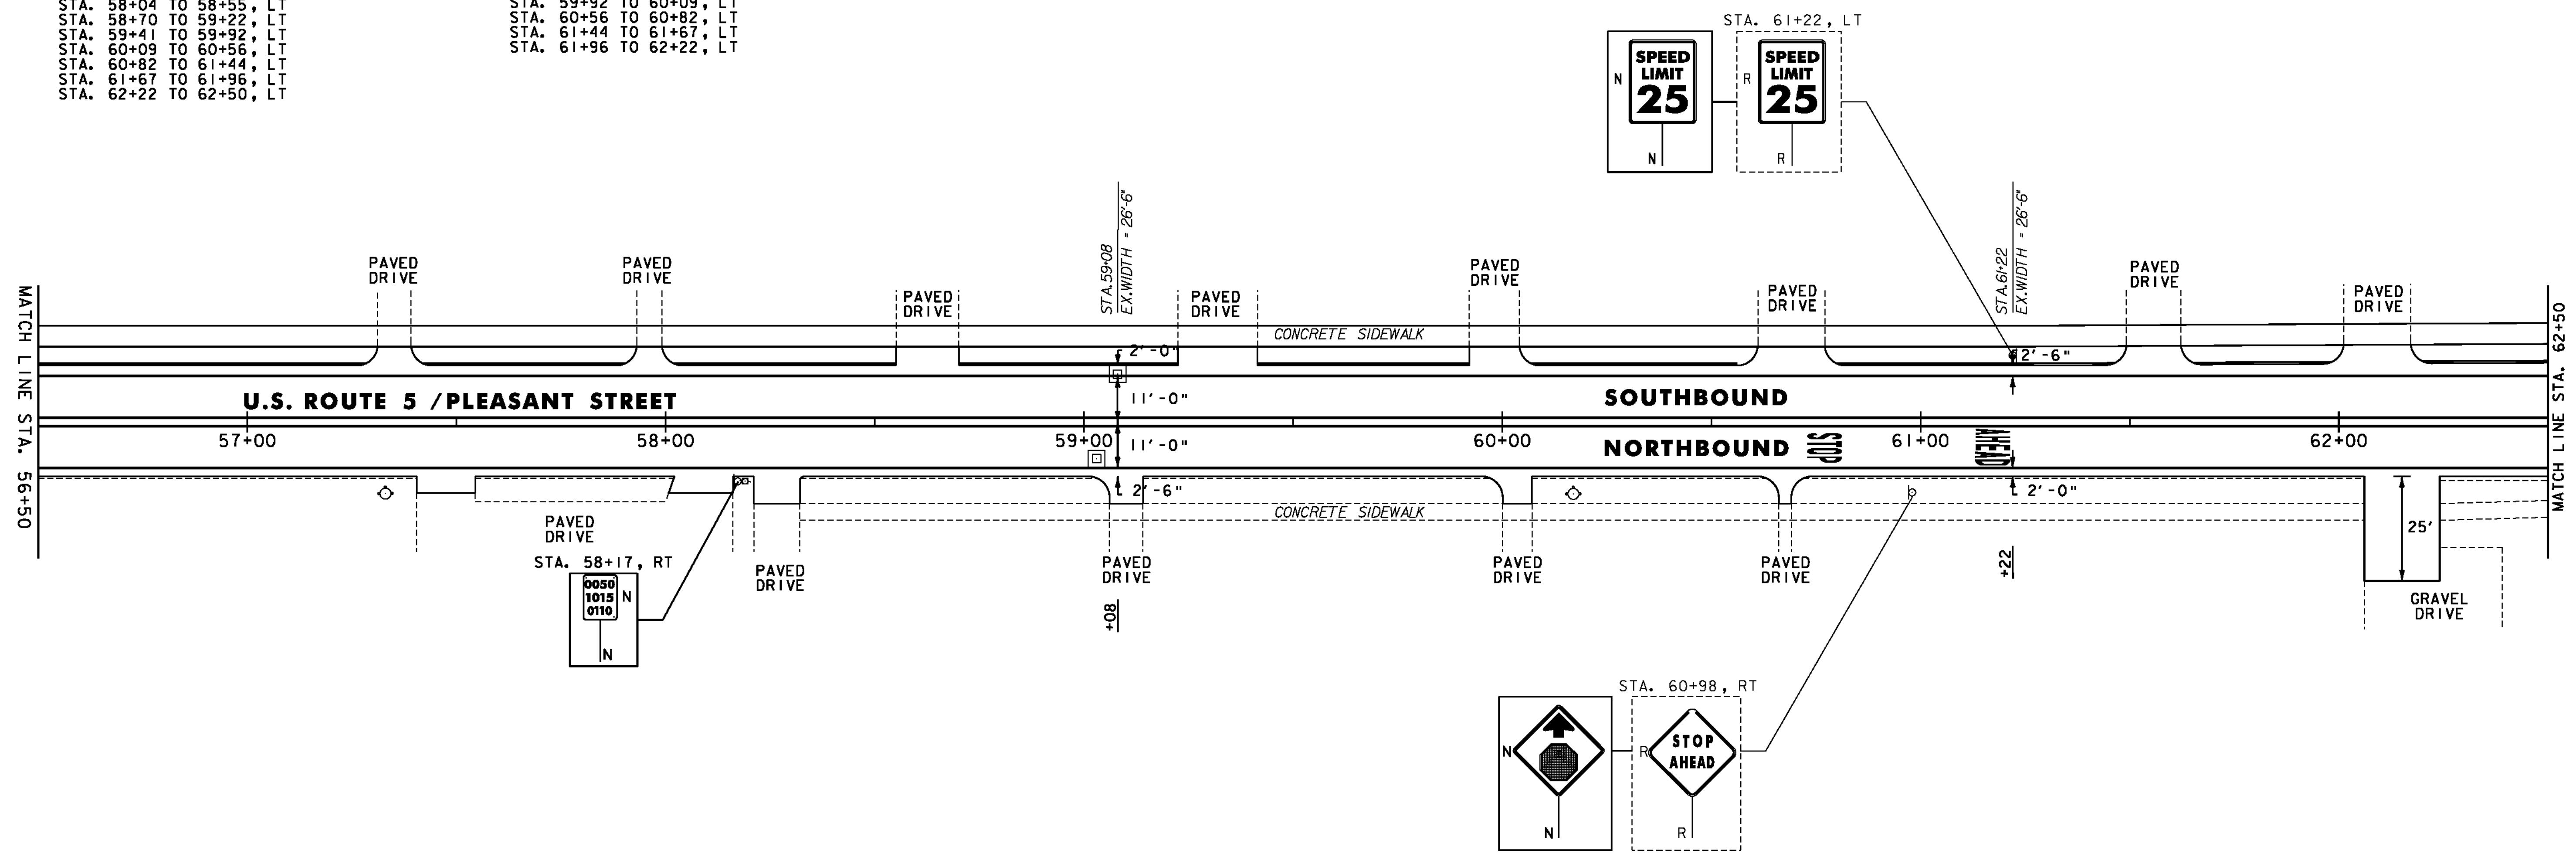

NOTES:  
 1. FOR LEGEND, SEE SHEET #18.  
 2. ALL EXISTING SIGNS NOT SHOWN SHALL BE RETAINED

NOT TO SCALE

**PROJECT LAYOUT SHEET #8**



PROJECT NAME: NEWPORT CITY	PLOT DATE: 3/6/2012
PROJECT NUMBER: STP 2704(I)	DRAWN BY: STANTEC
FILE NAME: p07d196.dgn	CHECKED BY: STANTEC
PROJECT LEADER: JLL	SHEET 25 OF 91
DESIGNED BY: STANTEC	
IPARM FILE: p07d196108.i	