

STEEL BEAM GUARDRAIL, GALVANIZED
STA. 152+07 TO 154+50, RT

ANCHOR FOR STEEL BEAM RAIL
STA. 152+07, RT

REMOVAL AND DISPOSAL OF GUARDRAIL
STA. 152+07 TO 154+50, RT


DURABLE 4 INCH WHITE LINE
(ALL LINES WILL INCLUDE EDGE LINE BREAKS
AND RADII FOR SIDE ROADS)
STA. 148+50 TO 154+50, SOLID LT & RT
STA. 148+50 TO 154+50, DASHED RT

DURABLE 4 INCH YELLOW LINE
(ALL LINES WILL INCLUDE C BREAKS FOR SIDE ROADS)
STA. 148+50 TO 154+50, SOLID LT & RT

TEMPORARY 4 INCH WHITE LINE, PAINT
(ALL LINES WILL INCLUDE EDGE LINE BREAKS
AND RADII FOR SIDE ROADS)
STA. 148+50 TO 154+50, SOLID LT & RT
STA. 148+50 TO 154+50, DASHED RT

TEMPORARY 4 INCH YELLOW LINE, PAINT
(ALL LINES WILL INCLUDE C BREAKS FOR SIDE ROADS)
STA. 148+50 TO 154+50, SOLID LT & RT

REMOVING SIGNS
AS SHOWN - 2

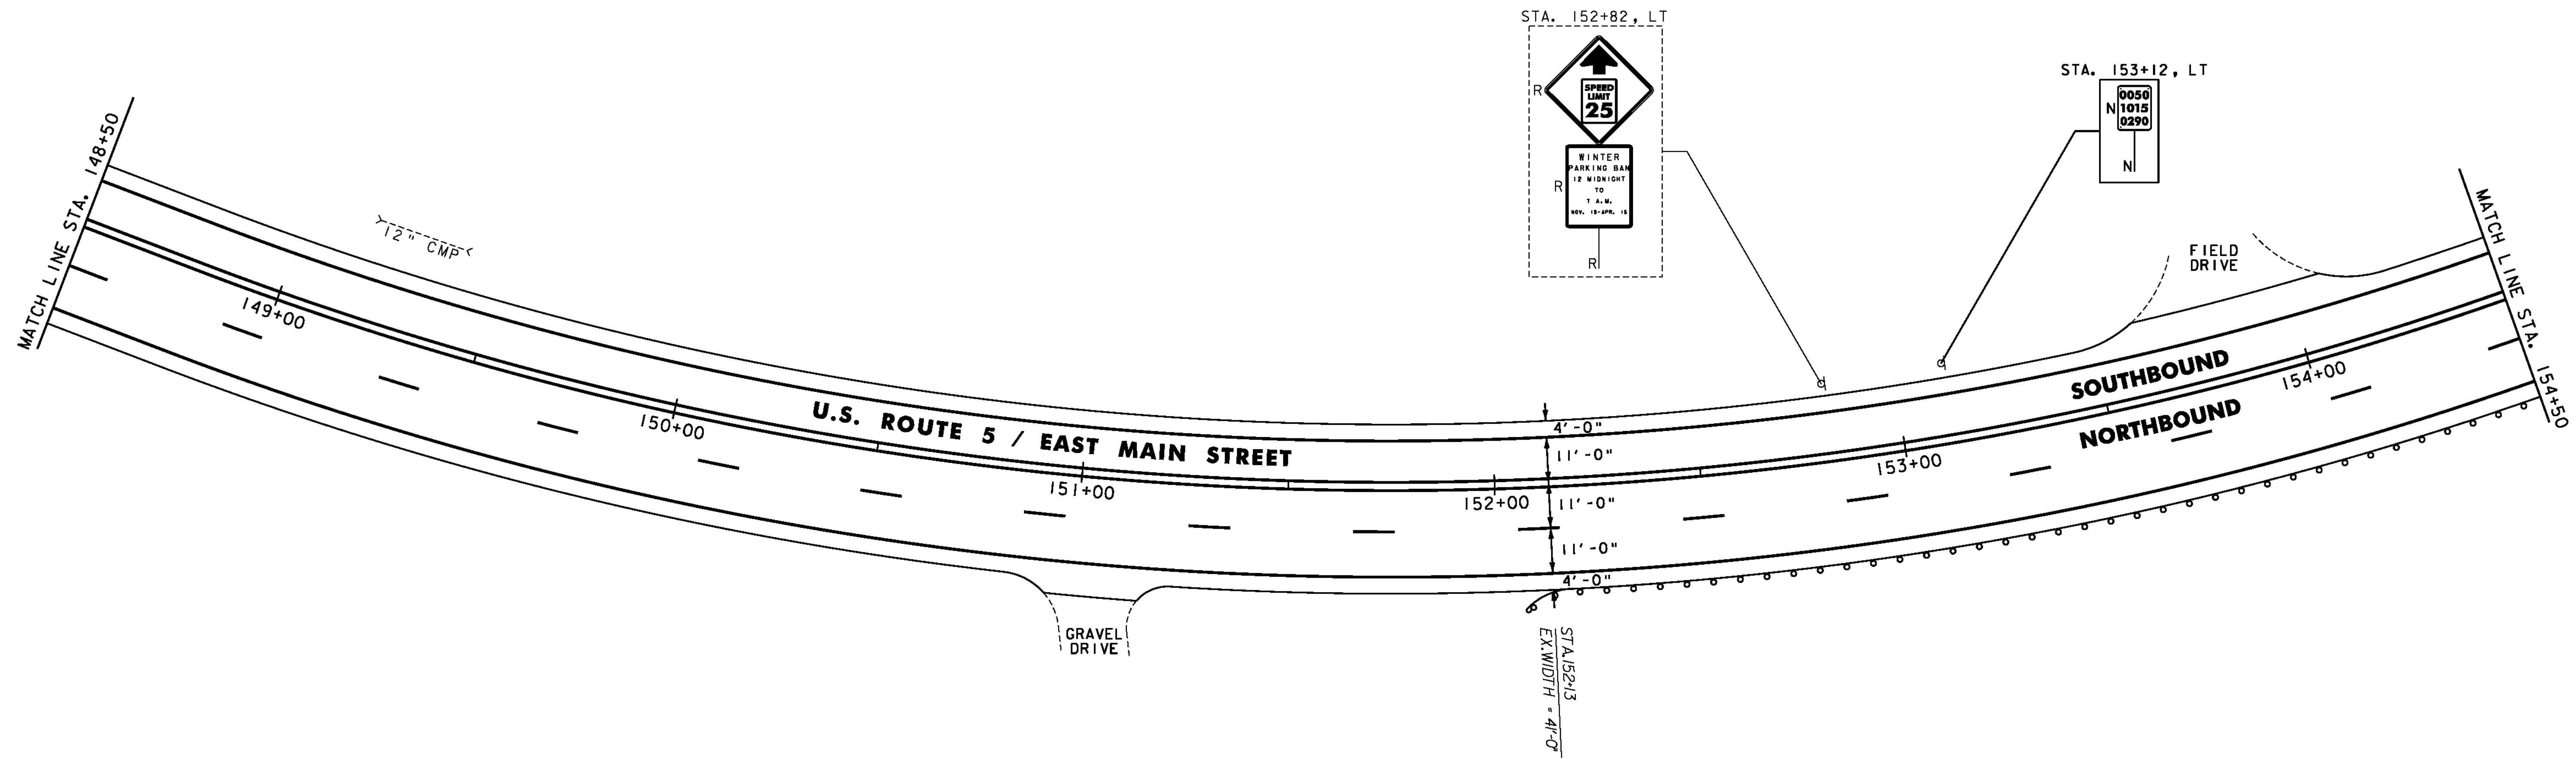

- NOTES:
1. FOR LEGEND, SEE SHEET #18.
 2. ALL EXISTING SIGNS NOT SHOWN SHALL BE RETAINED.

NOT TO SCALE



PROJECT LAYOUT SHEET #25

PROJECT NAME: NEWPORT CITY	PLOT DATE: 3/6/2012
PROJECT NUMBER: STP 2704(I)	DRAWN BY: STANTEC
FILE NAME: p07d196.dgn	CHECKED BY: STANTEC
PROJECT LEADER: JLL	SHEET 43 OF 91
DESIGNED BY: STANTEC	
IPARM FILE: p07d196125.i	