


DURABLE 4 INCH WHITE LINE
 (ALL LINES WILL INCLUDE EDGE LINE BREAKS
 AND RADII FOR SIDE ROADS)
 STA. 160+50 TO 166+50, SOLID LT & RT
 STA. 160+50 TO 166+50, DASHED RT

TEMPORARY 4 INCH WHITE LINE, PAINT
 (ALL LINES WILL INCLUDE EDGE LINE BREAKS
 AND RADII FOR SIDE ROADS)
 STA. 160+50 TO 166+50, SOLID LT & RT
 STA. 160+50 TO 166+50, DASHED RT

DURABLE 4 INCH YELLOW LINE
 (ALL LINES WILL INCLUDE G BREAKS FOR SIDE ROADS)
 STA. 160+50 TO 166+50, SOLID LT & RT

TEMPORARY 4 INCH YELLOW LINE, PAINT
 (ALL LINES WILL INCLUDE G BREAKS FOR SIDE ROADS)
 STA. 160+50 TO 166+50, SOLID LT & RT

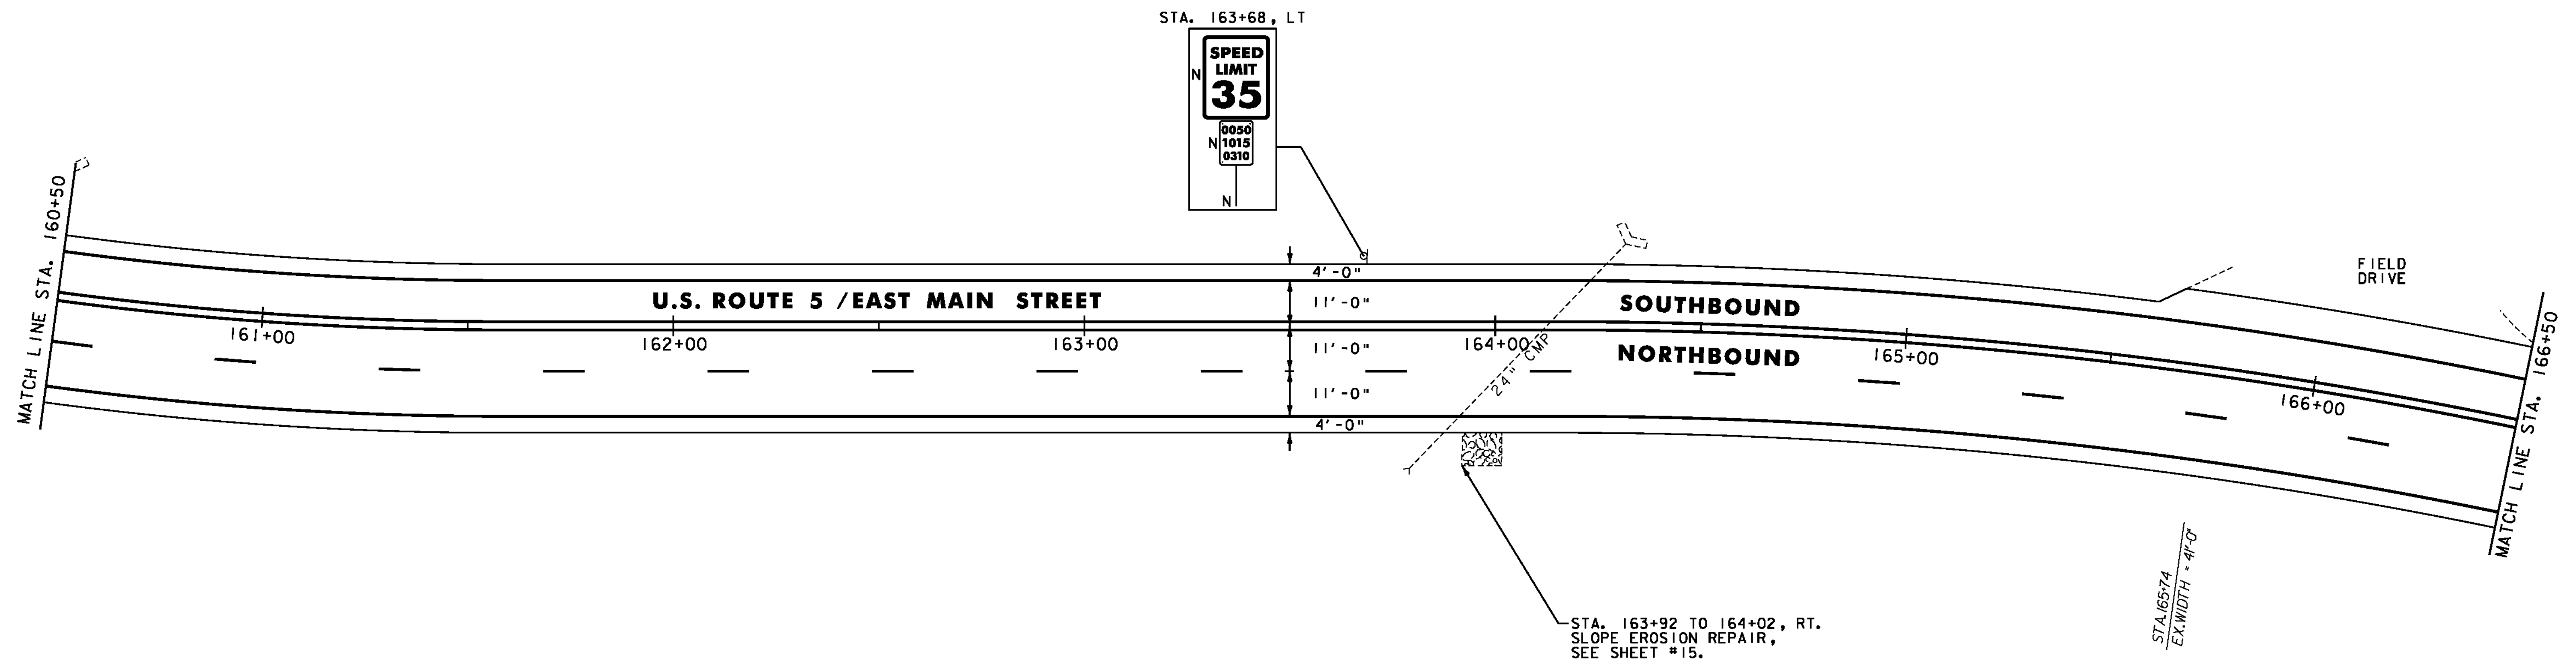

- NOTES:
- FOR LEGEND, SEE SHEET #18.
 - ALL EXISTING SIGNS NOT SHOWN SHALL BE RETAINED.

NOT TO SCALE



PROJECT LAYOUT SHEET #27

PROJECT NAME: NEWPORT CITY	PLOT DATE: 3/6/2012
PROJECT NUMBER: STP 2704(I)	DRAWN BY: STANTEC
FILE NAME: p07d196.dgn	CHECKED BY: STANTEC
PROJECT LEADER: JLL	SHEET 45 OF 91
DESIGNED BY: STANTEC	
IPARM FILE: p07d196127.i	