

CHANGING ELEVATION OF SEWER MANHOLES
 STA. 167+21, LT
 STA. 172+06, LT

DURABLE 4 INCH WHITE LINE
 (ALL LINES WILL INCLUDE EDGE LINE BREAKS AND RADIUS FOR SIDE ROADS)
 STA. 166+50 TO 172+50, SOLID LT & RT
 STA. 166+50 TO 169+87, DASHED RT

TEMPORARY 4 INCH WHITE LINE, PAINT
 (ALL LINES WILL INCLUDE EDGE LINE BREAKS AND RADIUS FOR SIDE ROADS)
 STA. 166+50 TO 172+50, SOLID LT & RT
 STA. 166+50 TO 169+87, DASHED RT


REMOVING SIGNS
 AS SHOWN - 3

DURABLE 4 INCH YELLOW LINE
 (ALL LINES WILL INCLUDE C BREAKS FOR SIDE ROADS)
 STA. 166+50 TO 172+50, SOLID LT & RT

TEMPORARY 4 INCH YELLOW LINE, PAINT
 (ALL LINES WILL INCLUDE C BREAKS FOR SIDE ROADS)
 STA. 166+50 TO 172+50, SOLID LT & RT

DURABLE LETTER OR SYMBOL
 STA. 169+87, RT (ARROW) (IN ACCORDANCE WITH THE 2009 MUTCD)

TEMPORARY LETTER OR SYMBOL, PAINT
 STA. 169+87, RT (ARROW) (IN ACCORDANCE WITH THE 2009 MUTCD)

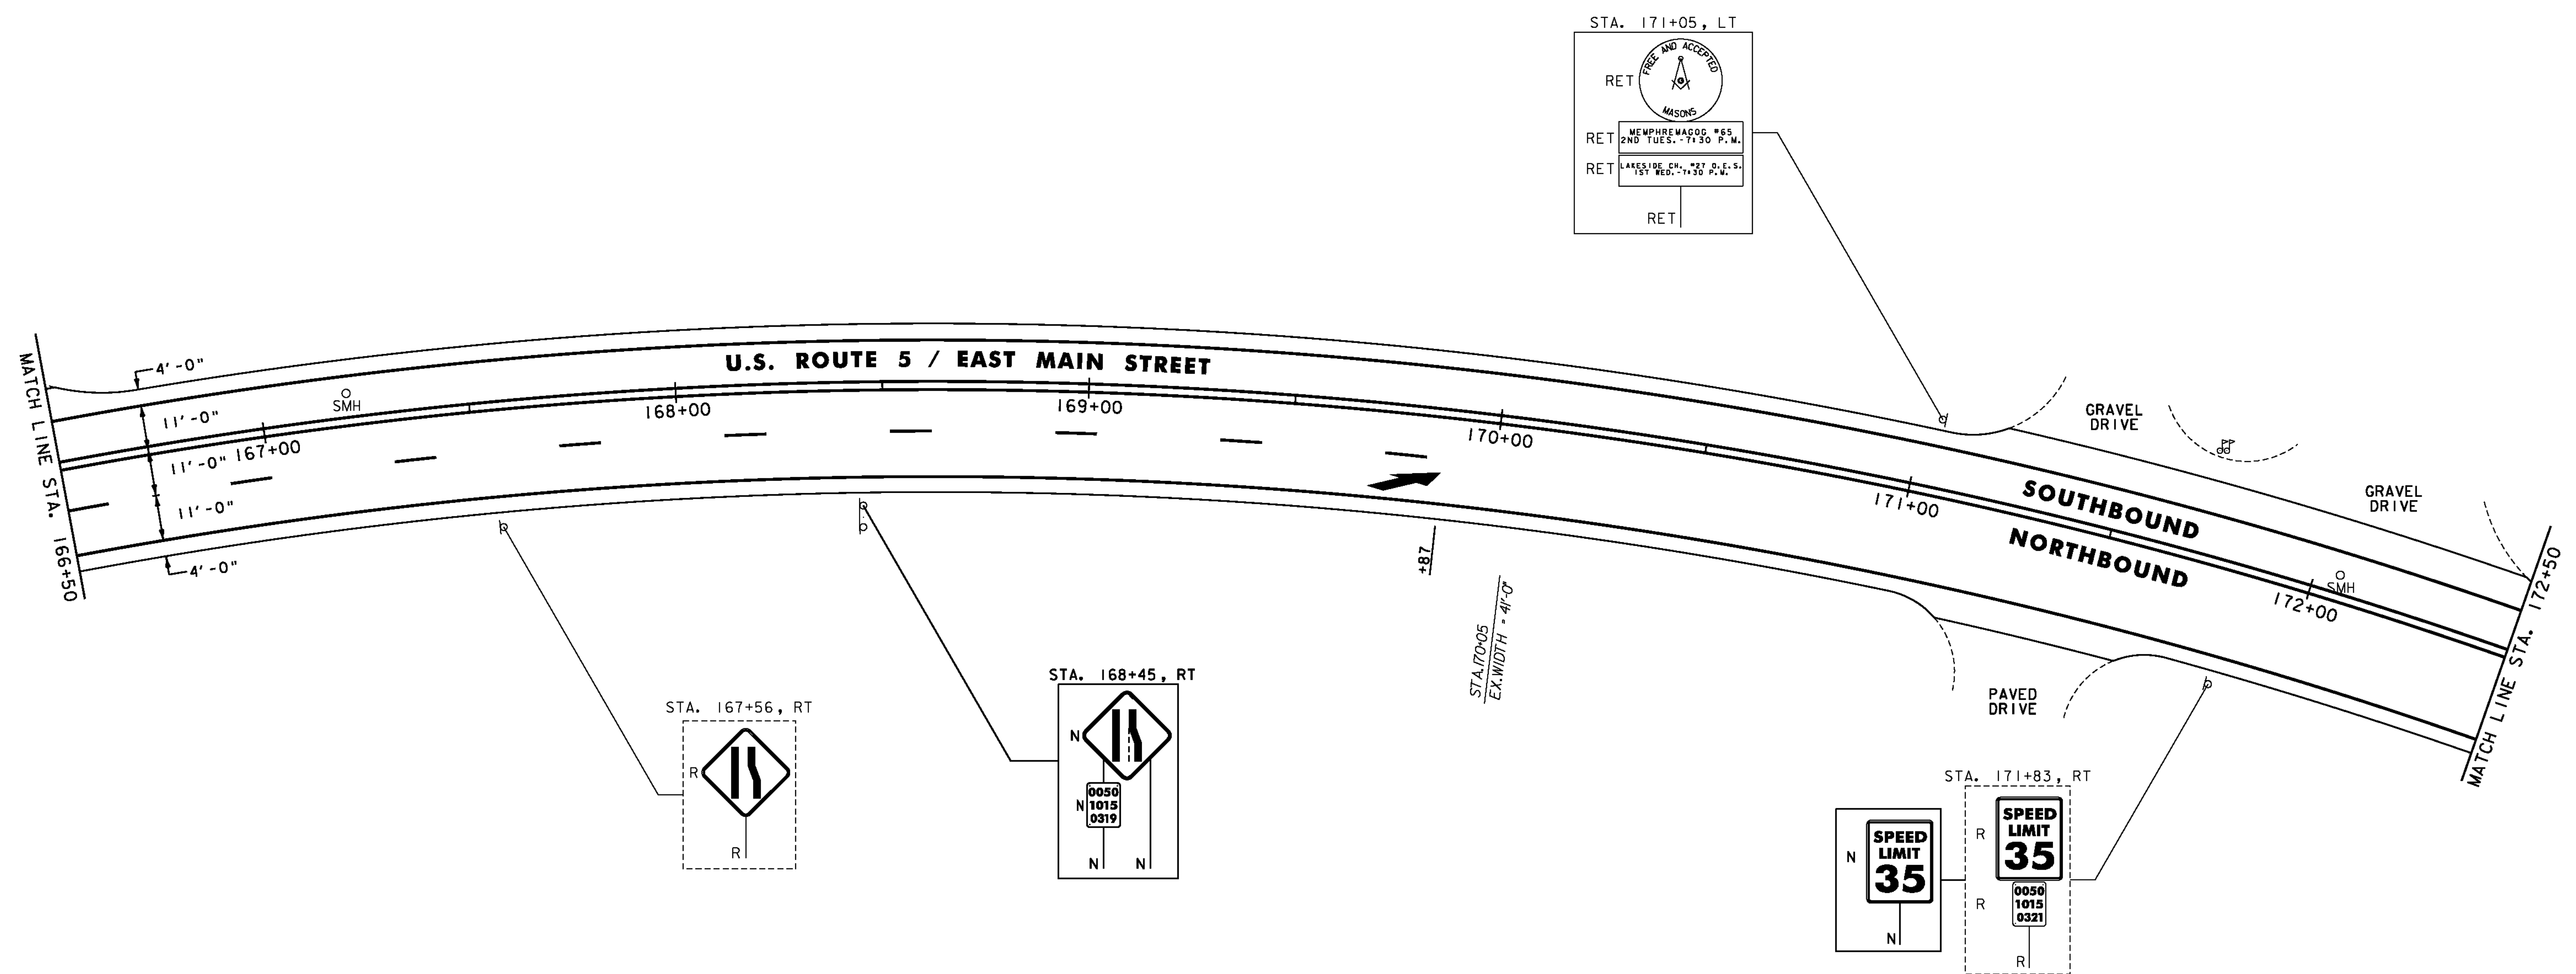

NOTES:
 1. FOR LEGEND, SEE SHEET #18.
 2. ALL EXISTING SIGNS NOT SHOWN SHALL BE RETAINED.

NOT TO SCALE



PROJECT LAYOUT SHEET #28

PROJECT NAME: NEWPORT CITY	PLOT DATE: 3/6/2012
PROJECT NUMBER: STP 2704(I)	DRAWN BY: STANTEC
FILE NAME: p07d196.dgn	CHECKED BY: STANTEC
PROJECT LEADER: JLL	SHEET 46 OF 91
DESIGNED BY: STANTEC	
IPARM FILE: p07d196128.i	