


STEEL BEAM GUARDRAIL, GALVANIZED
 STA. 173+10 TO 174+10, RT
ANCHOR FOR STEEL BEAM RAIL
 STA. 173+10, RT
 STA. 174+10, RT
REMOVAL AND DISPOSAL OF GUARDRAIL
 STA. 173+15 TO 174+11, RT

DURABLE 4 INCH WHITE LINE
 (ALL LINES WILL INCLUDE EDGE LINE BREAKS AND RADI1 FOR SIDE ROADS)
 STA. 172+50 TO 177+50, SOLID LT & RT
DURABLE 4 INCH YELLOW LINE
 (ALL LINES WILL INCLUDE C BREAKS FOR SIDE ROADS)
 STA. 172+50 TO 177+50, SOLID LT & RT

DURABLE 8 INCH WHITE LINE
 STA. 176+22 TO 176+42, LT (HYDRANT)
DURABLE LETTER OR SYMBOL
 STA. 174+00, RT (ARROW) (IN ACCORDANCE WITH THE 2009 MUTCD)
TEMPORARY 4 INCH WHITE LINE, PAINT
 (ALL LINES WILL INCLUDE EDGE LINE BREAKS AND RADI1 FOR SIDE ROADS)
 STA. 172+50 TO 177+50, SOLID LT & RT


TEMPORARY 4 INCH YELLOW LINE, PAINT
 (ALL LINES WILL INCLUDE C BREAKS FOR SIDE ROADS)
 STA. 172+50 TO 177+50, SOLID LT & RT
TEMPORARY 8 INCH WHITE LINE, PAINT
 STA. 176+22 TO 176+42, LT (HYDRANT)
TEMPORARY LETTER OR SYMBOL, PAINT
 STA. 174+00, RT (ARROW) (IN ACCORDANCE WITH THE 2009 MUTCD)

REMOVING SIGNS
 AS SHOWN - 6

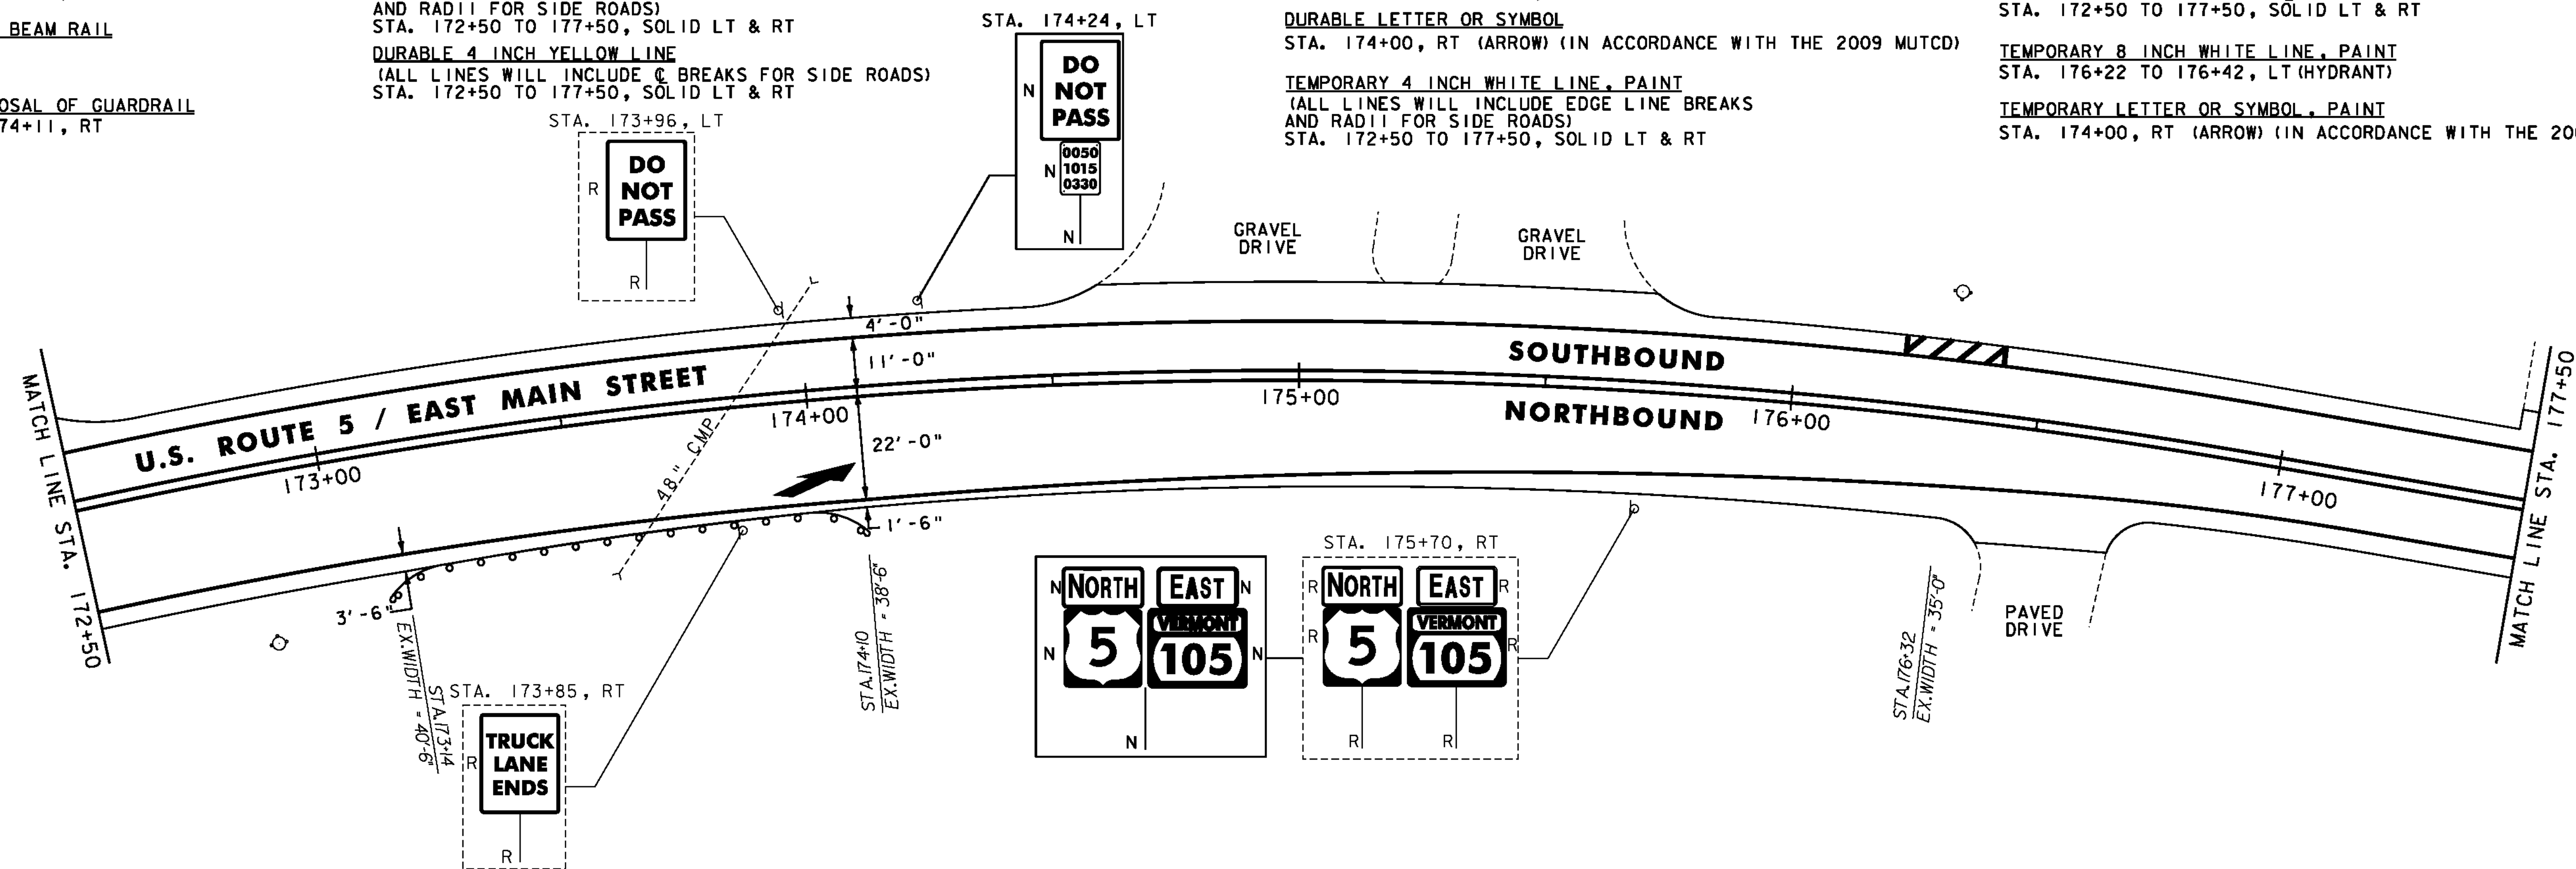

DURABLE 4 INCH WHITE LINE
 (ALL LINES WILL INCLUDE EDGE LINE BREAKS AND RADI1 FOR SIDE ROADS)
 STA. 177+50 TO 183+50, SOLID LT & RT
DURABLE 4 INCH YELLOW LINE
 (ALL LINES WILL INCLUDE C BREAKS FOR SIDE ROADS)
 STA. 177+50 TO 183+50, SOLID LT & RT
DURABLE 8 INCH WHITE LINE
 STA. 180+48 TO 180+68, LT (HYDRANT)

TEMPORARY 4 INCH WHITE LINE, PAINT
 (ALL LINES WILL INCLUDE EDGE LINE BREAKS AND RADI1 FOR SIDE ROADS)
 STA. 177+50 TO 183+50, SOLID LT & RT
TEMPORARY 4 INCH YELLOW LINE, PAINT
 (ALL LINES WILL INCLUDE C BREAKS FOR SIDE ROADS)
 STA. 177+50 TO 183+50, SOLID LT & RT
TEMPORARY 8 INCH WHITE LINE, PAINT
 STA. 180+48 TO 180+68, LT (HYDRANT)

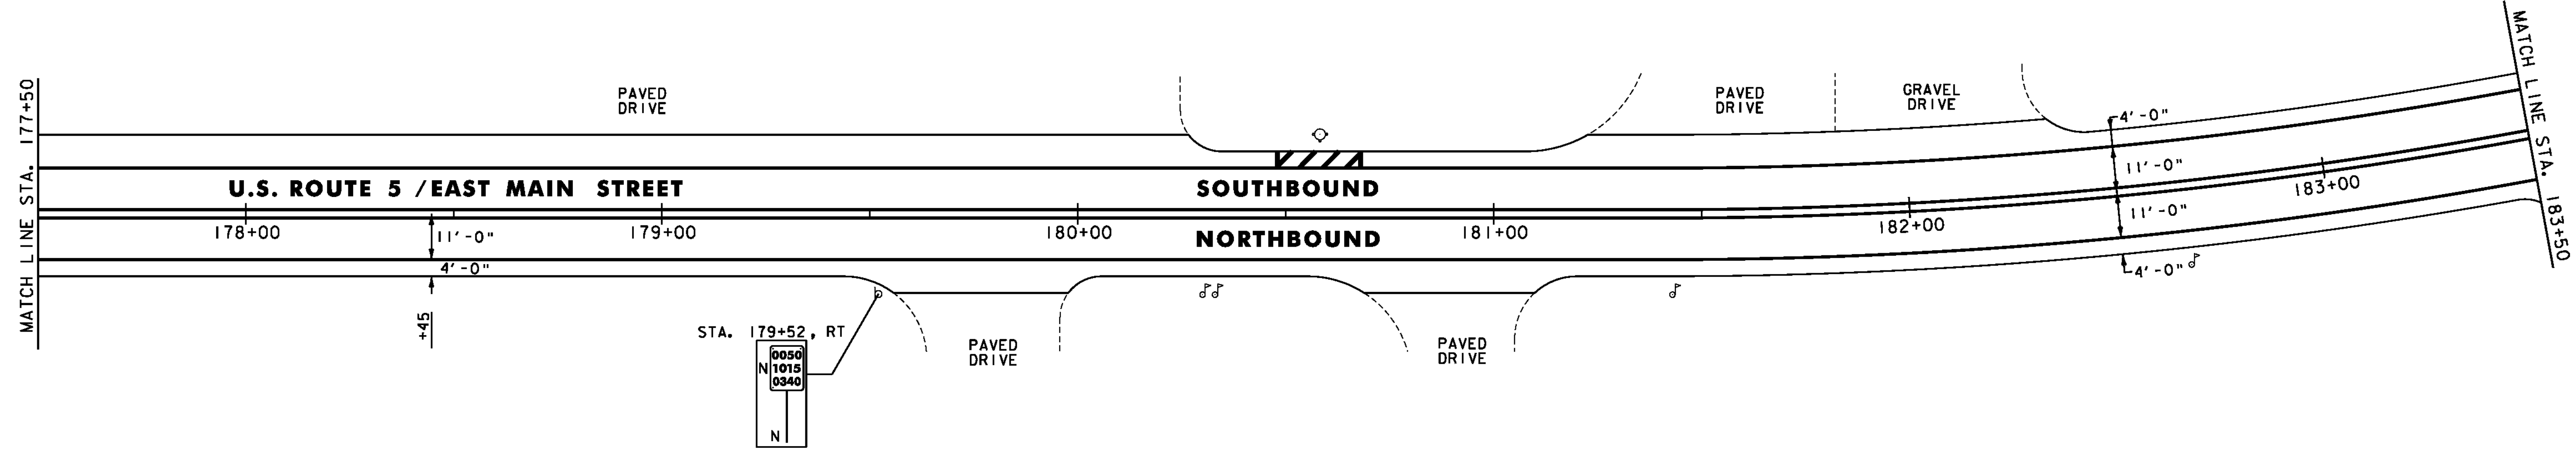

NOTES:
 1. FOR LEGEND, SEE SHEET #18.
 2. ALL EXISTING SIGNS NOT SHOWN SHALL BE RETAINED.

NOT TO SCALE

PROJECT LAYOUT SHEET #29	PROJECT NAME: NEWPORT CITY	PLOT DATE: 3/6/2012
	PROJECT NUMBER: STP 2704(I)	DRAWN BY: STANTEC
	FILE NAME: p07d196.dgn	CHECKED BY: STANTEC
	DESIGNED BY: STANTEC	SHEET 47 OF 91
	IPARM FILE: p07d196129.i	

