




LOCATION: STA. 63+39, RT
 STA. 65+01, RT
 STA. 68+36, RT
 COLOR: WHITE BORDER AND TEXT (RETROREFLECTIVE)
 GREEN BACKGROUND (RETROREFLECTIVE)
 MATERIAL: 0.08" FLAT SHEET ALUMINUM

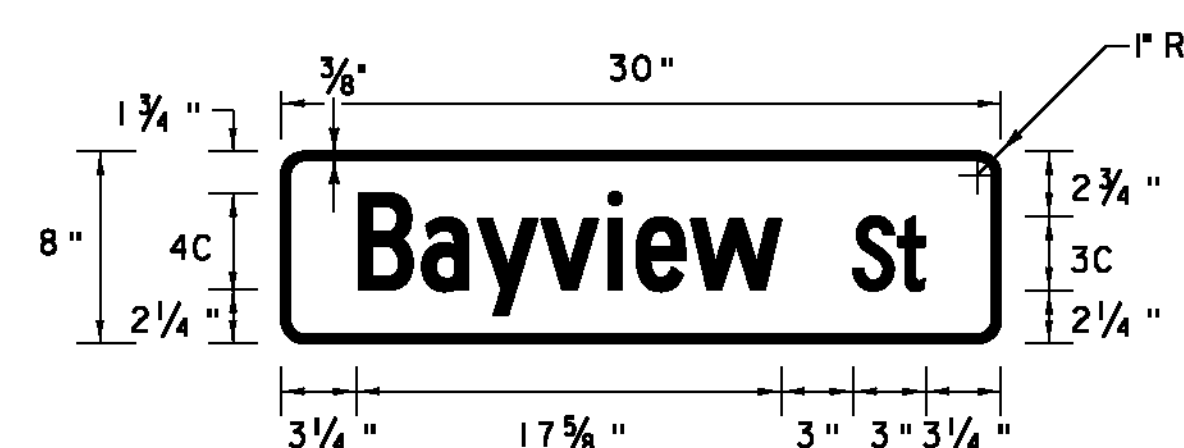


LOCATION: STA. 71+23, LT
 COLOR: WHITE BORDER AND TEXT (RETROREFLECTIVE)
 GREEN BACKGROUND (RETROREFLECTIVE)
 MATERIAL: 0.08" FLAT SHEET ALUMINUM

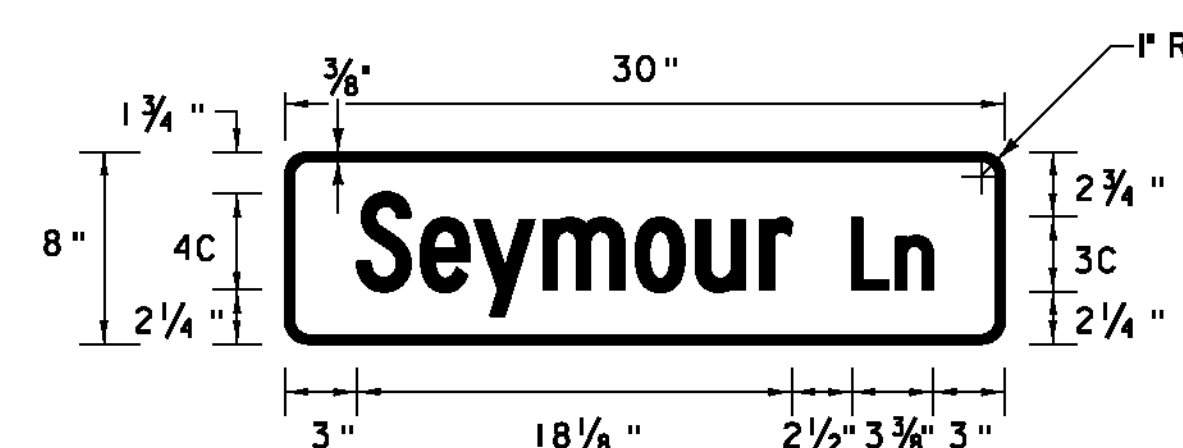


LOCATION: STA. 77+69, LT
 COLOR: WHITE BORDER AND TEXT (RETROREFLECTIVE)
 GREEN BACKGROUND (RETROREFLECTIVE)
 MATERIAL: 0.08" FLAT SHEET ALUMINUM

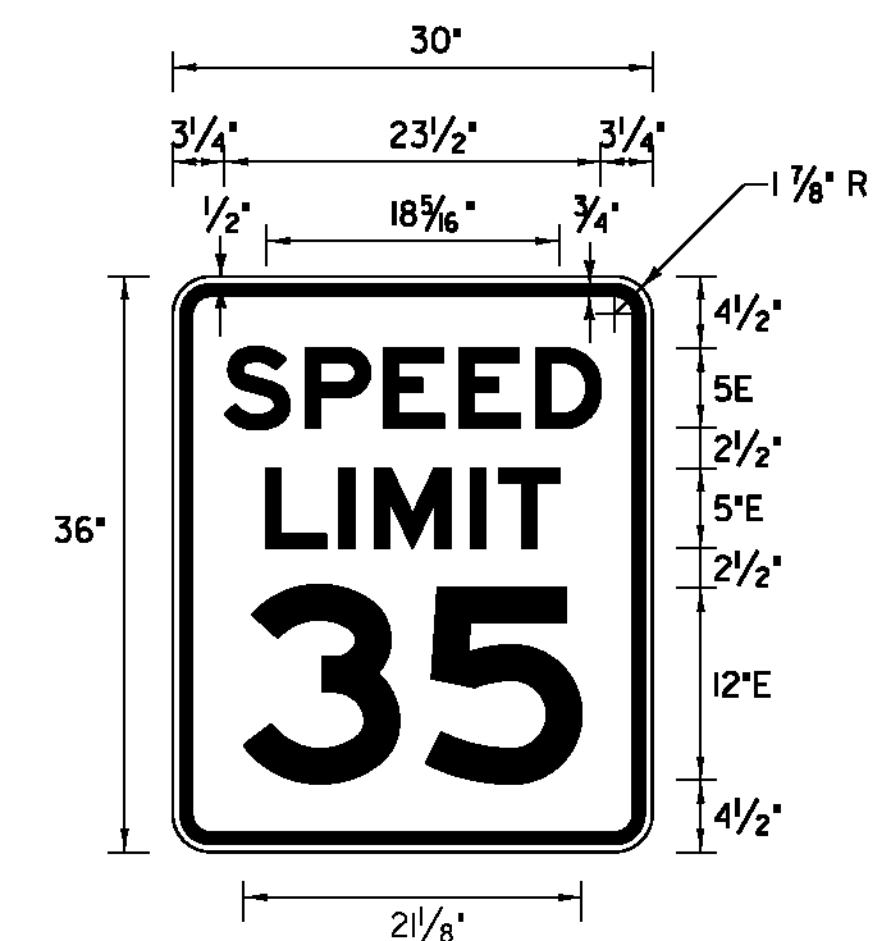


LOCATION: STA. 1+75, RT.
 COLOR: BLACK BORDER & TEXT
 WHITE BACKGROUND (RETROREFLECTIVE)
 MATERIAL: 0.08" FLAT SHEET ALUMINUM

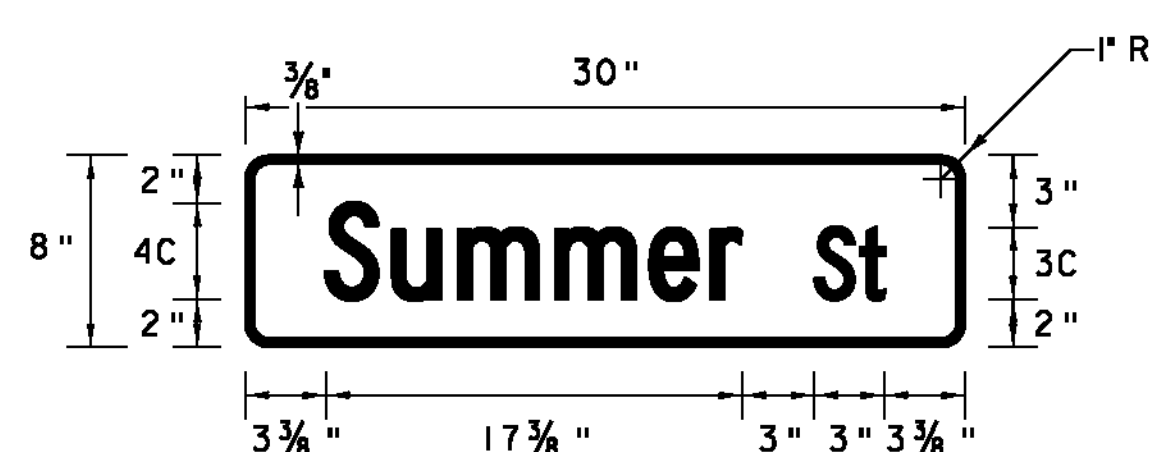


LOCATION: STA. 65+01, RT
 COLOR: WHITE BORDER AND TEXT (RETROREFLECTIVE)
 GREEN BACKGROUND (RETROREFLECTIVE)
 MATERIAL: 0.08" FLAT SHEET ALUMINUM

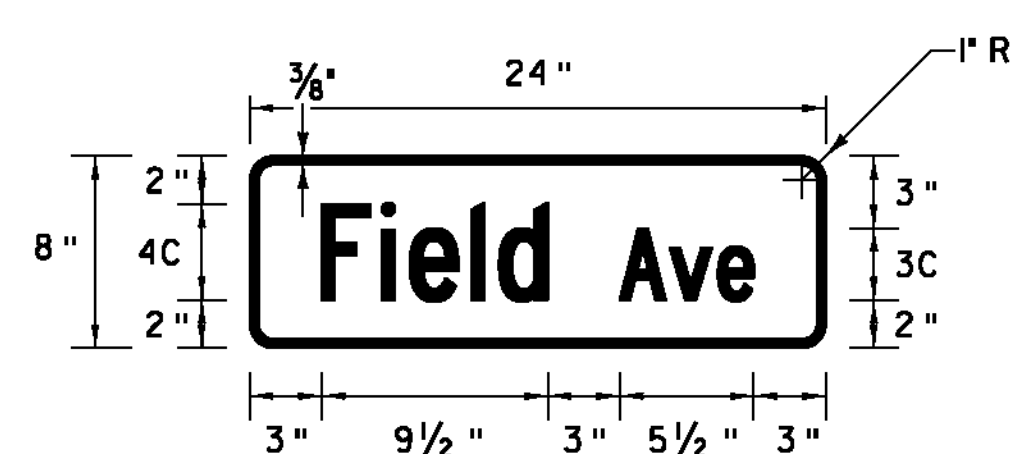


LOCATION: STA. 73+45, LT
 COLOR: WHITE BORDER AND TEXT (RETROREFLECTIVE)
 GREEN BACKGROUND (RETROREFLECTIVE)
 MATERIAL: 0.08" FLAT SHEET ALUMINUM

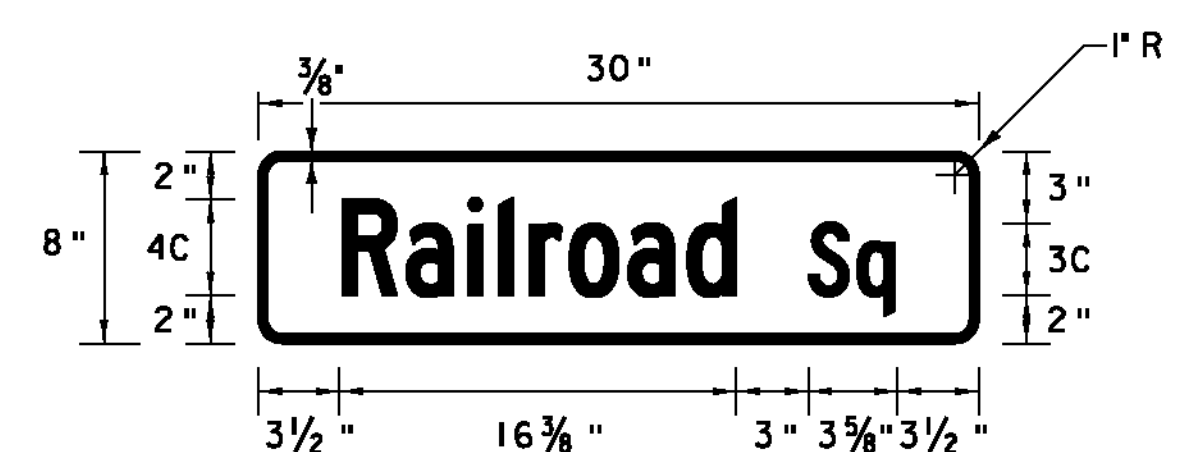


LOCATION: STA. 85+87, RT
 COLOR: WHITE BORDER AND TEXT (RETROREFLECTIVE)
 GREEN BACKGROUND (RETROREFLECTIVE)
 MATERIAL: 0.08" FLAT SHEET ALUMINUM

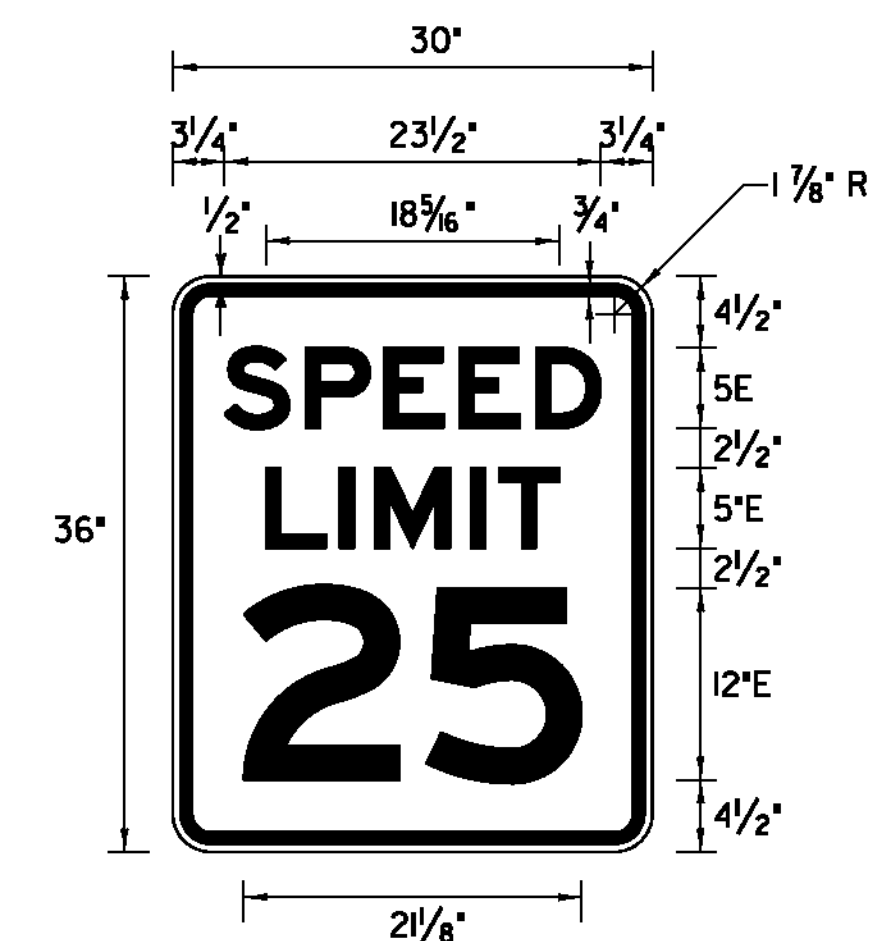


LOCATION: STA. 16+97, RT.
 COLOR: BLACK BORDER & TEXT
 WHITE BACKGROUND (RETROREFLECTIVE)
 MATERIAL: 0.08" FLAT SHEET ALUMINUM

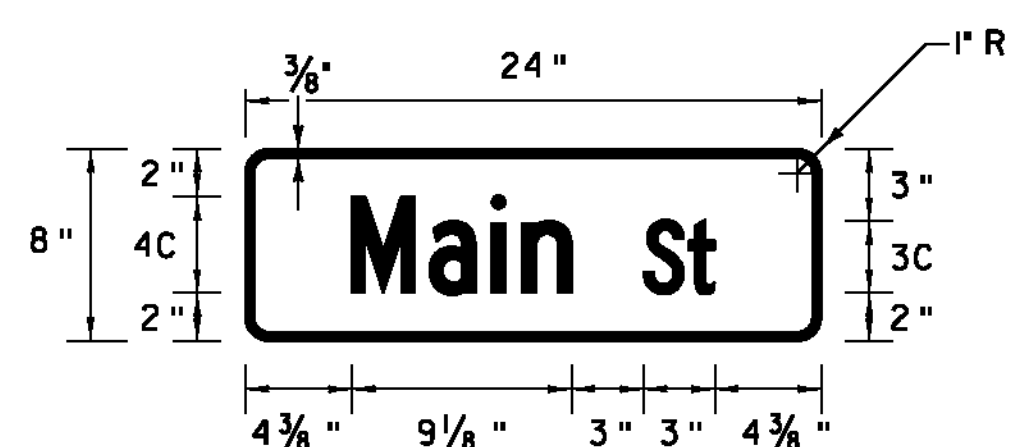


LOCATION: STA. 68+50, LT
 STA. 71+23, LT
 STA. 73+45, LT
 STA. 73+91, RT
 STA. 76+85, RT
 STA. 77+69, LT
 STA. 80+24, RT
 STA. 85+87, RT
 STA. 96+36, RT
 COLOR: WHITE BORDER AND TEXT (RETROREFLECTIVE)
 GREEN BACKGROUND (RETROREFLECTIVE)
 MATERIAL: 0.08" FLAT SHEET ALUMINUM

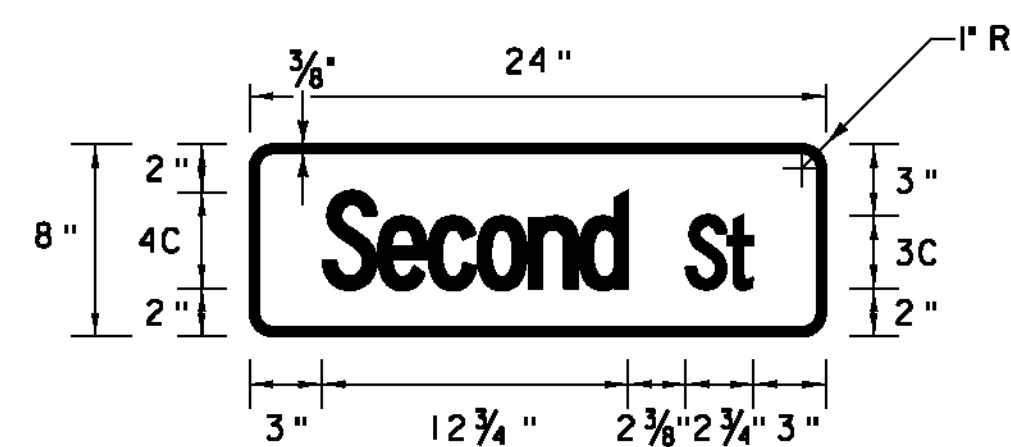


LOCATION: STA. 73+91, RT
 COLOR: WHITE BORDER AND TEXT (RETROREFLECTIVE)
 GREEN BACKGROUND (RETROREFLECTIVE)
 MATERIAL: 0.08" FLAT SHEET ALUMINUM

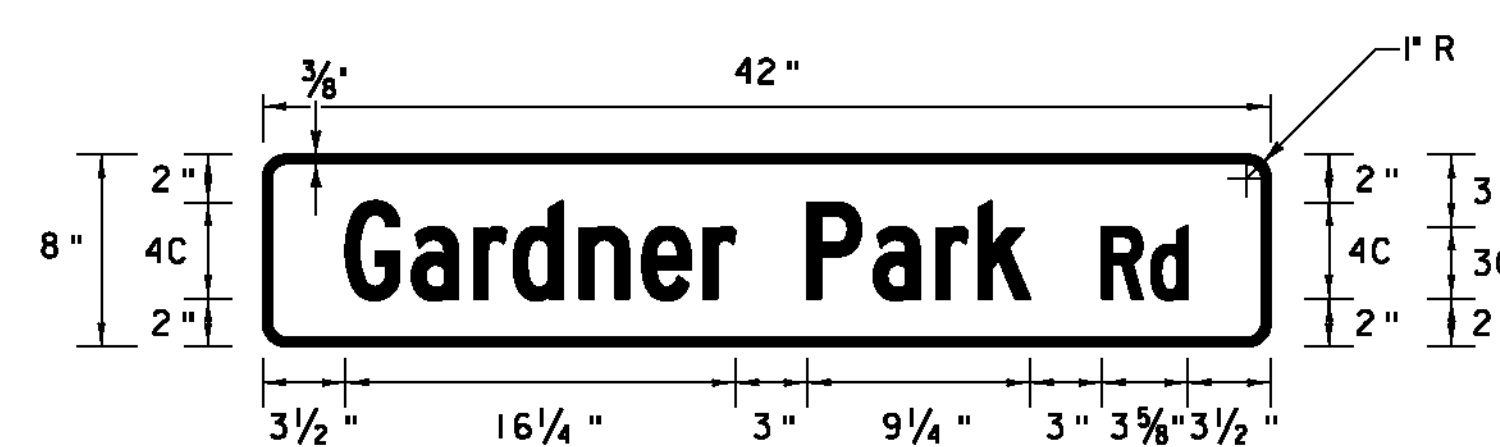


LOCATION: STA. 96+36, RT
 COLOR: WHITE BORDER AND TEXT (RETROREFLECTIVE)
 GREEN BACKGROUND (RETROREFLECTIVE)
 MATERIAL: 0.08" FLAT SHEET ALUMINUM

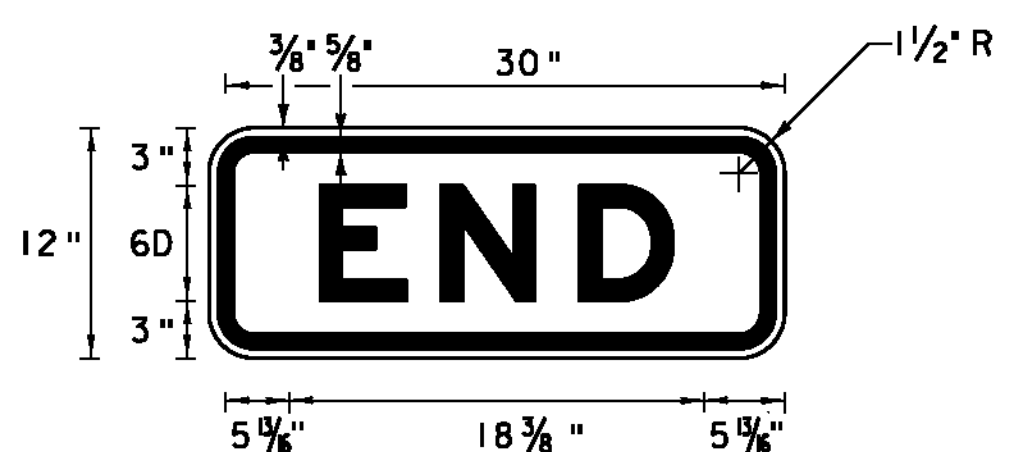


LOCATION: STA. 66+87, RT
 COLOR: BLACK BORDER AND TEXT (RETROREFLECTIVE)
 WHITE BACKGROUND (RETROREFLECTIVE)
 MATERIAL: 0.08" FLAT SHEET ALUMINUM

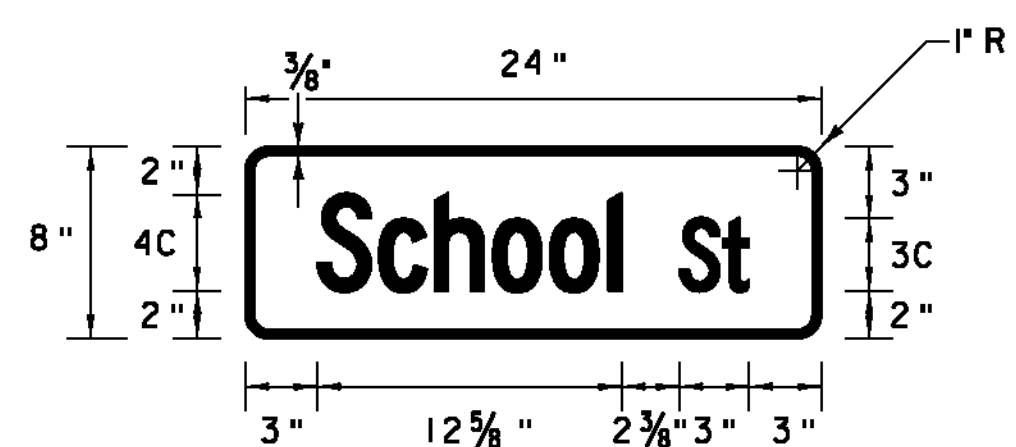

LOCATION: STA. 68+95, LT
 COLOR: WHITE BORDER AND TEXT (RETROREFLECTIVE)
 GREEN BACKGROUND (RETROREFLECTIVE)
 MATERIAL: 0.08" FLAT SHEET ALUMINUM

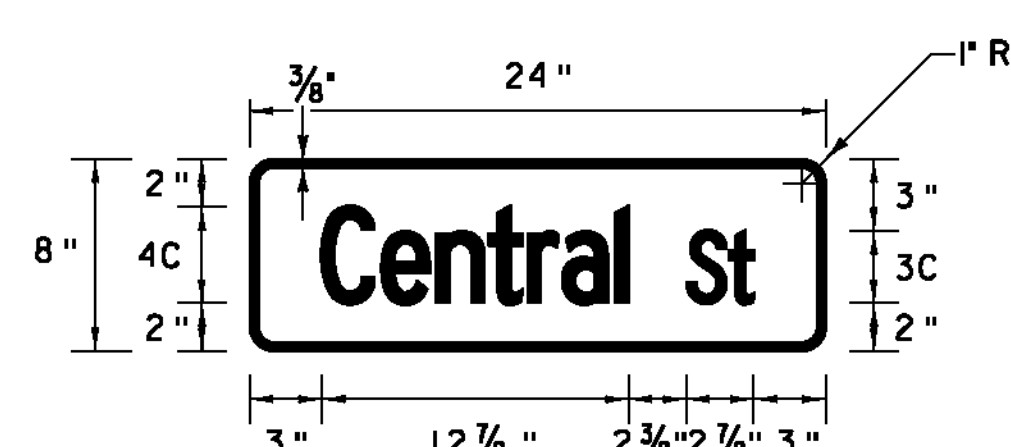

LOCATION: STA. 76+85, RT
 COLOR: WHITE BORDER AND TEXT (RETROREFLECTIVE)
 GREEN BACKGROUND (RETROREFLECTIVE)
 MATERIAL: 0.08" FLAT SHEET ALUMINUM

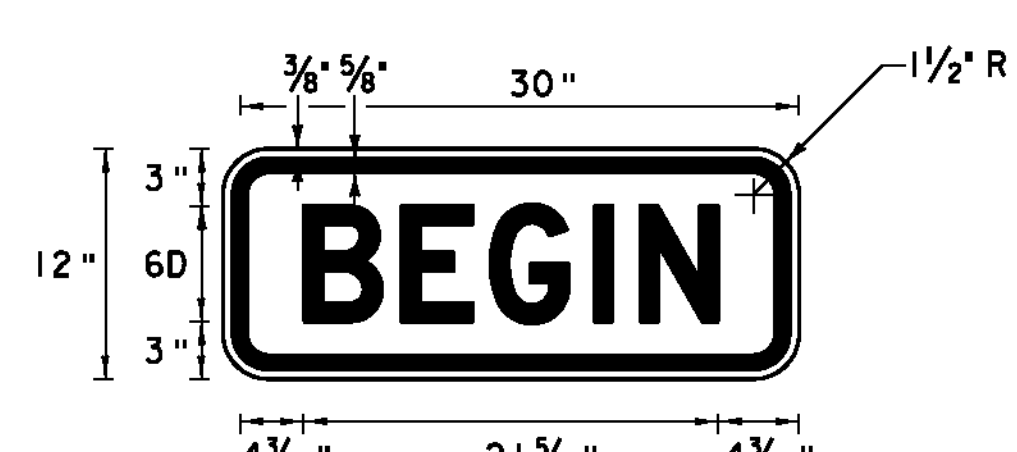

LOCATION: STA. 64+25, RT
 STA. 118+78, LT
 COLOR: BLACK BORDER AND TEXT (RETROREFLECTIVE)
 WHITE BACKGROUND (RETROREFLECTIVE)
 MATERIAL: 0.08" FLAT SHEET ALUMINUM

NOT TO SCALE

**TRAFFIC
 SIGN
 DETAIL
 SHEET #3**

PROJECT NAME: NEWPORT CITY
 PROJECT NUMBER: STP 2704(I)

FILE NAME: p07d196.dgn PLOT DATE: 3/6/2012
 PROJECT LEADER: JLL DRAWN BY: STANTEC
 DESIGNED BY: STANTEC CHECKED BY: STANTEC
 IPARM FILE: p07d196tsds03.i SHEET 84 OF 91

