


646.20 4 INCH WHITE LINE
STA. 27+50 TO 33+50, SOLID LT & RT

646.602 TEMPORARY 4 INCH WHITE LINE, PAINT
STA. 27+50 TO 33+50, SOLID LT & RT

646.21 4 INCH YELLOW LINE
STA. 27+50 TO 33+50, SOLID LT & RT

646.612 TEMPORARY 4 INCH YELLOW LINE, PAINT
STA. 27+50 TO 33+50, SOLID LT & RT

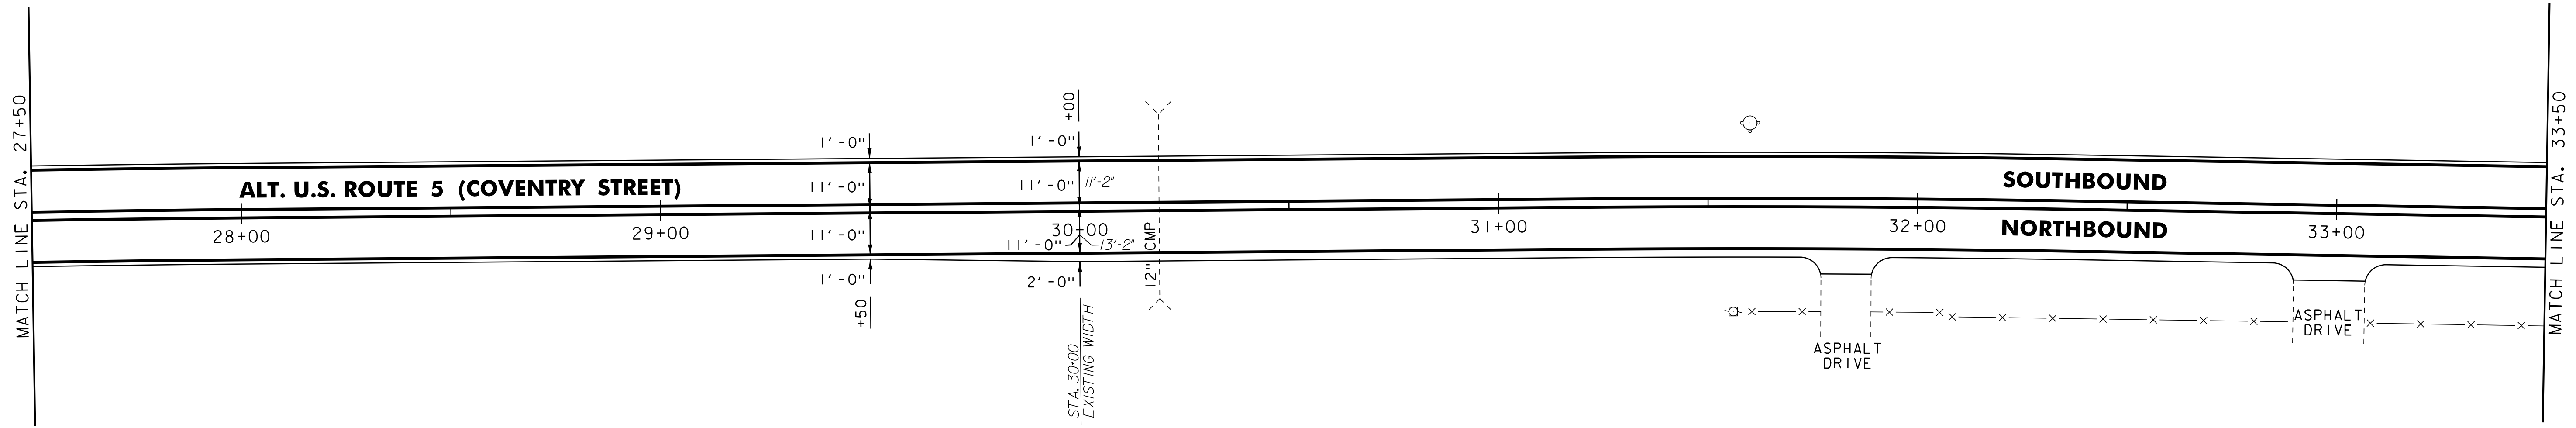


646.20 4 INCH WHITE LINE
STA. 33+50 TO 39+50, SOLID LT & RT

646.602 TEMPORARY 4 INCH WHITE LINE, PAINT
STA. 33+50 TO 39+50, SOLID LT & RT

646.21 4 INCH YELLOW LINE
STA. 33+50 TO 39+50, SOLID LT & RT

646.612 TEMPORARY 4 INCH YELLOW LINE, PAINT
STA. 33+50 TO 39+50, SOLID LT & RT

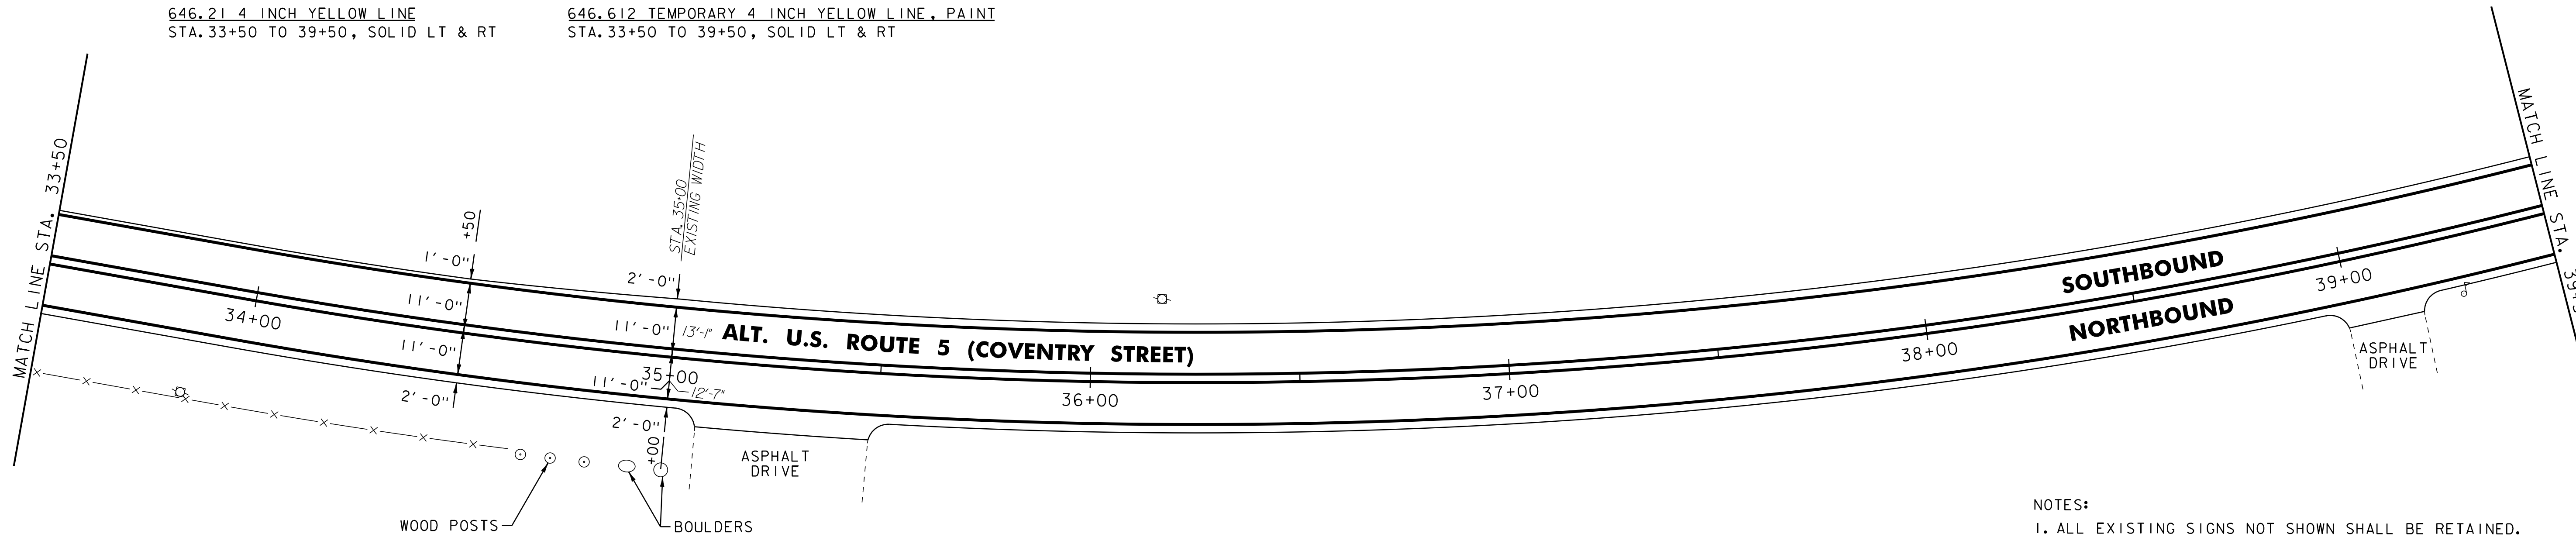

- NOTES:
1. ALL EXISTING SIGNS NOT SHOWN SHALL BE RETAINED.
 2. FOR LEGEND, SEE LAYOUT SHEET #1

NOT TO SCALE

PROJECT LAYOUT SHEET #4

PROJECT NAME: NEWPORT CITY
PROJECT NUMBER: STP 2719(1)

FILE NAME: 07D202.dgn
PROJECT LEADER: JLL
DESIGNED BY: STANTEC
IPARM FILE: 07D202_15.i

PLOT DATE: 29-JAN-2013 09:2
DRAWN BY: STANTEC
CHECKED BY: JLL
SHEET 15 OF 62