

604.42 CHANGING ELEVATION OF SEWER MANHOLES
STA. 41+10, RT

621.60 ANCHOR FOR STEEL BEAM RAIL
STA. 41+83.5, RT
91.5

646.20 4 INCH WHITE LINE
STA. 39+50 TO 45+50, SOLID LT & RT


646.602 TEMPORARY 4 INCH WHITE LINE, PAINT
STA. 39+50 TO 45+50, SOLID LT & RT

621.20 STEEL BEAM GUARDRAIL, GALVANIZED
STA. 41+83.5 TO 43+58.5, RT
91.5 56.0

621.80 REMOVAL AND DISPOSAL OF GUARDRAIL
STA. 41+8+ TO 43+58.5, RT
93.5 56.0

646.21 4 INCH YELLOW LINE
STA. 39+50 TO 45+50, SOLID LT & RT

646.612 TEMPORARY 4 INCH YELLOW LINE, PAINT
STA. 39+50 TO 45+50, SOLID LT & RT

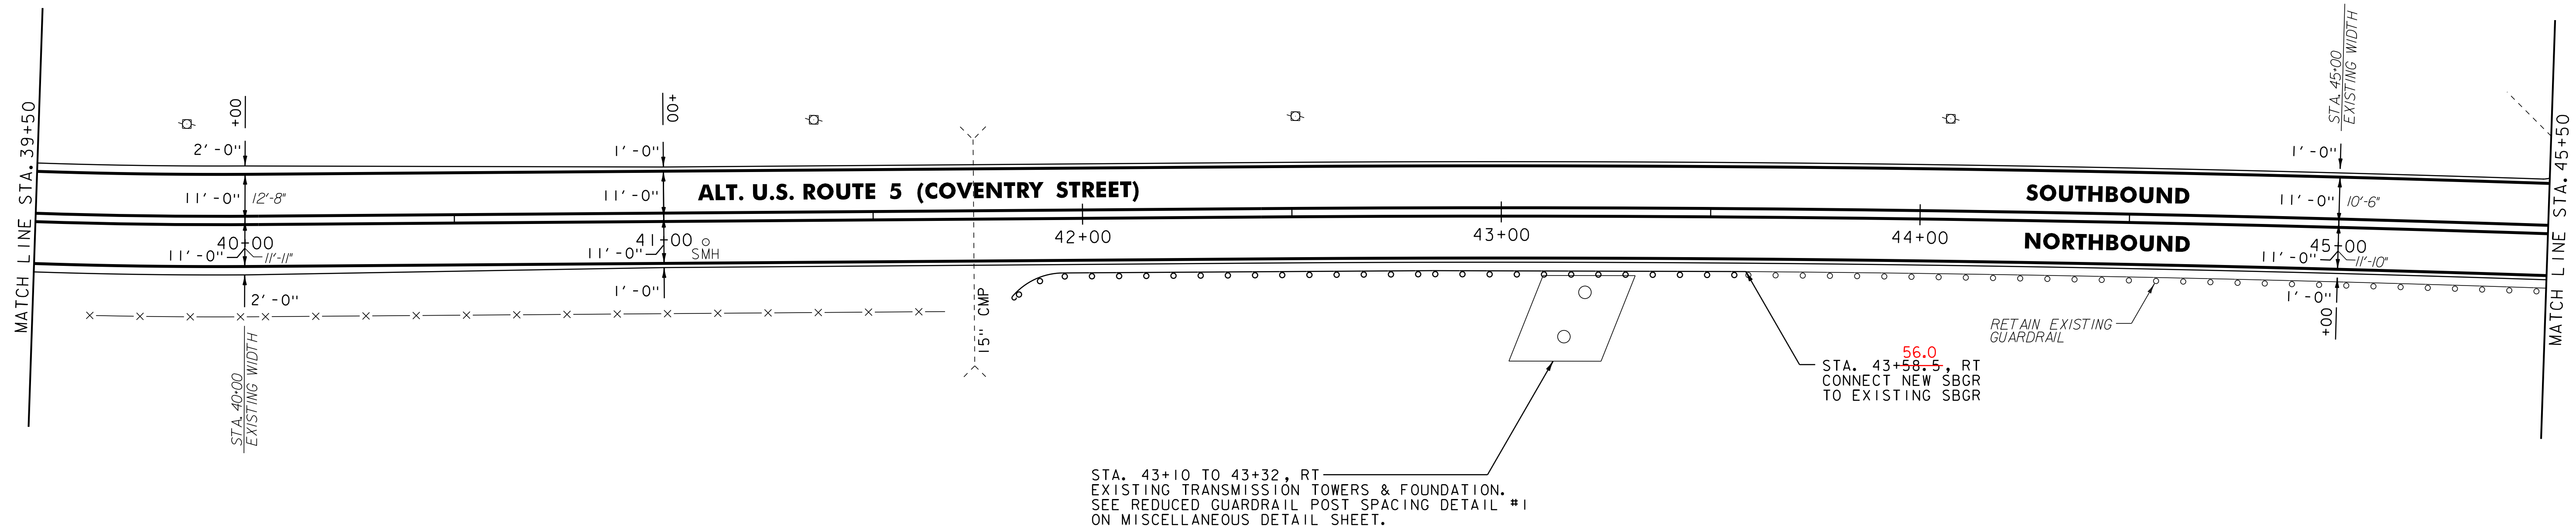

604.42 CHANGING ELEVATION OF SEWER MANHOLES
STA. 47+06, RT
STA. 48+24, RT
STA. 51+33, RT
STA. 51+48, RT

621.20 STEEL BEAM GUARDRAIL, GALVANIZED
STA. 50+19.5 TO 51+32, RT
15.0 40.5

646.20 4 INCH WHITE LINE
STA. 45+50 TO 51+50, SOLID LT & RT
(INCLUDING EDGE LINE BREAKS FOR TOWN HIGHWAYS)

646.602 TEMPORARY 4 INCH WHITE LINE, PAINT
STA. 45+50 TO 51+50, SOLID LT & RT
(INCLUDING EDGE LINE BREAKS FOR TOWN HIGHWAYS)

675.50 REMOVING SIGNS
AS SHOWN - 2


629.20 ADJUST ELEVATION OF VALVE BOX
STA. 51+23, LT

621.80 REMOVAL AND DISPOSAL OF GUARDRAIL
STA. 50+19.5 TO 51+32.0, RT
15.0 40.0

646.21 4 INCH YELLOW LINE
STA. 45+50 TO 51+50, SOLID LT & RT
(INCLUDING C BREAKS FOR TOWN HIGHWAYS)

646.612 TEMPORARY 4 INCH YELLOW LINE, PAINT
STA. 45+50 TO 51+50, SOLID LT & RT
(INCLUDING C BREAKS FOR TOWN HIGHWAYS)

675.60 ERECTING SALVAGED SIGNS
AS SHOWN - 1

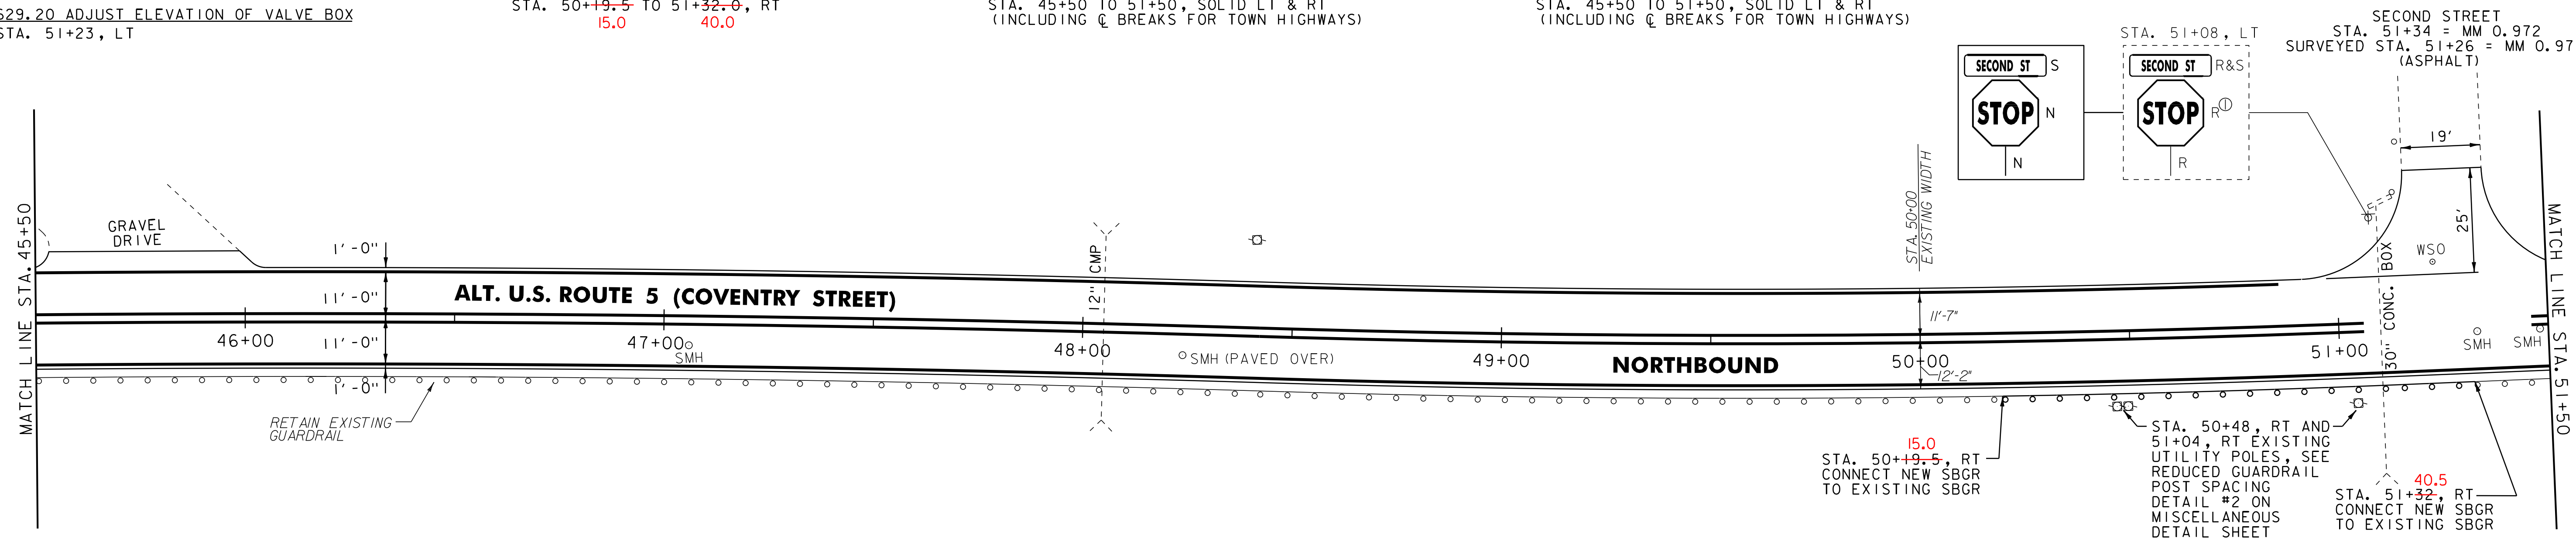

NOTES:

1. ALL EXISTING SIGNS NOT SHOWN SHALL BE RETAINED.
2. FOR LEGEND, SEE LAYOUT SHEET #1

NOT TO SCALE

PROJECT LAYOUT SHEET #5

PROJECT NAME: NEWPORT CITY
PROJECT NUMBER: STP 2719(I)

FILE NAME: 07D202.dgn
PROJECT LEADER: JLL
DESIGNED BY: STANTEC
IPARM FILE: 07D202_16.i

PLOT DATE: 29-JAN-2013 09:2
DRAWN BY: STANTEC
CHECKED BY: JLL
SHEET 16 OF 62