

604.412, 604.415 OR 604.418 REHAB.
Dis. Cbs OR MHS, CLASS I, II OR III
STA. 64+75, LT
STA. 64+95, LT

604.42 CHANGING ELEVATION OF SEWER MANHOLES
STA. 65+00, LT
STA. 65+00, RT
STA. 66+29, RT
STA. 66+96, LT

616.28 CAST-IN-PLACE CONCRETE CURB, TYPE B
STA. 63+95, LT
STA. 67+07, LT
STA. 67+07, RT

616.41 REMOVAL OF EXISTING CURB
STA. 63+95, LT
STA. 67+07, LT
STA. 67+07, RT

618.10 PORTLAND CEMENT CONCRETE SIDEWALK, 5 INCH
STA. 63+95, LT
STA. 64+00, RT
STA. 67+07, LT
STA. 67+07, RT

618.30 DETECTABLE WARNING SURFACE
STA. 63+95, LT
STA. 64+00, RT
STA. 67+07, LT
STA. 67+07, RT

646.20 4 INCH WHITE LINE
STA. 63+50 TO 67+18, SOLID RT
STA. 63+50 TO 67+23, SOLID LT
STA. 65+59 TO 66+32, DOTTED RT
STA. 66+32 TO 66+97, SOLID RT

646.21 4 INCH YELLOW LINE
STA. 63+50 TO 66+99, SOLID LT & RT

646.26 24 INCH STOP BAR
STA. 66+98, RT

646.30 LETTER OR SYMBOL
STA. 66+36, RT - ARROW
STA. 66+38.5, RT - ARROW (2)
STA. 66+89, RT - ARROW

646.31 CROSSWALK MARKING
STA. 63+91, LT TO 64+00, RT
STA. 67+07, LT & RT

646.602 TEMPORARY 4 INCH WHITE LINE, PAINT
STA. 63+50 TO 67+18, SOLID RT
STA. 63+50 TO 67+23, SOLID LT
STA. 65+59 TO 66+32, DOTTED RT
STA. 66+32 TO 66+97, SOLID RT

646.612 TEMPORARY 4 INCH YELLOW LINE, PAINT
STA. 63+50 TO 66+99, SOLID LT & RT

646.682 TEMPORARY 24 INCH STOP BAR, PAINT
STA. 66+98, RT

646.692 TEMPORARY LETTER OR SYMBOL, PAINT
STA. 66+36, RT - ARROW
STA. 66+38.5, RT - ARROW (2)
STA. 66+89, RT - ARROW


646.702 TEMPORARY CROSSWALK MARKING, PAINT
STA. 63+91, LT TO 64+00, RT
STA. 67+07, LT & RT

675.50 REMOVING SIGNS
AS SHOWN - 3

675.60 ERECTING SALVAGED SIGNS
AS SHOWN - 2

~~678.22 VEHICLE LOOP DETECTOR
STA. 66+85, RT
(SEE VEHICLE DETECTOR LOOP SHEET FOR
DETAILS, LOCATIONS AND CALCULATIONS)~~
THIS ITEM ELIMINATED BY THE CITY OF NEWPORT
AS PER K. LOCKE. (SEE CORRESPONDENCE FILE)

**END STP 2719(1) ALT. U.S. ROUTE 5
NEWPORT CITY STA. 67+21.39 = MM 1.273**

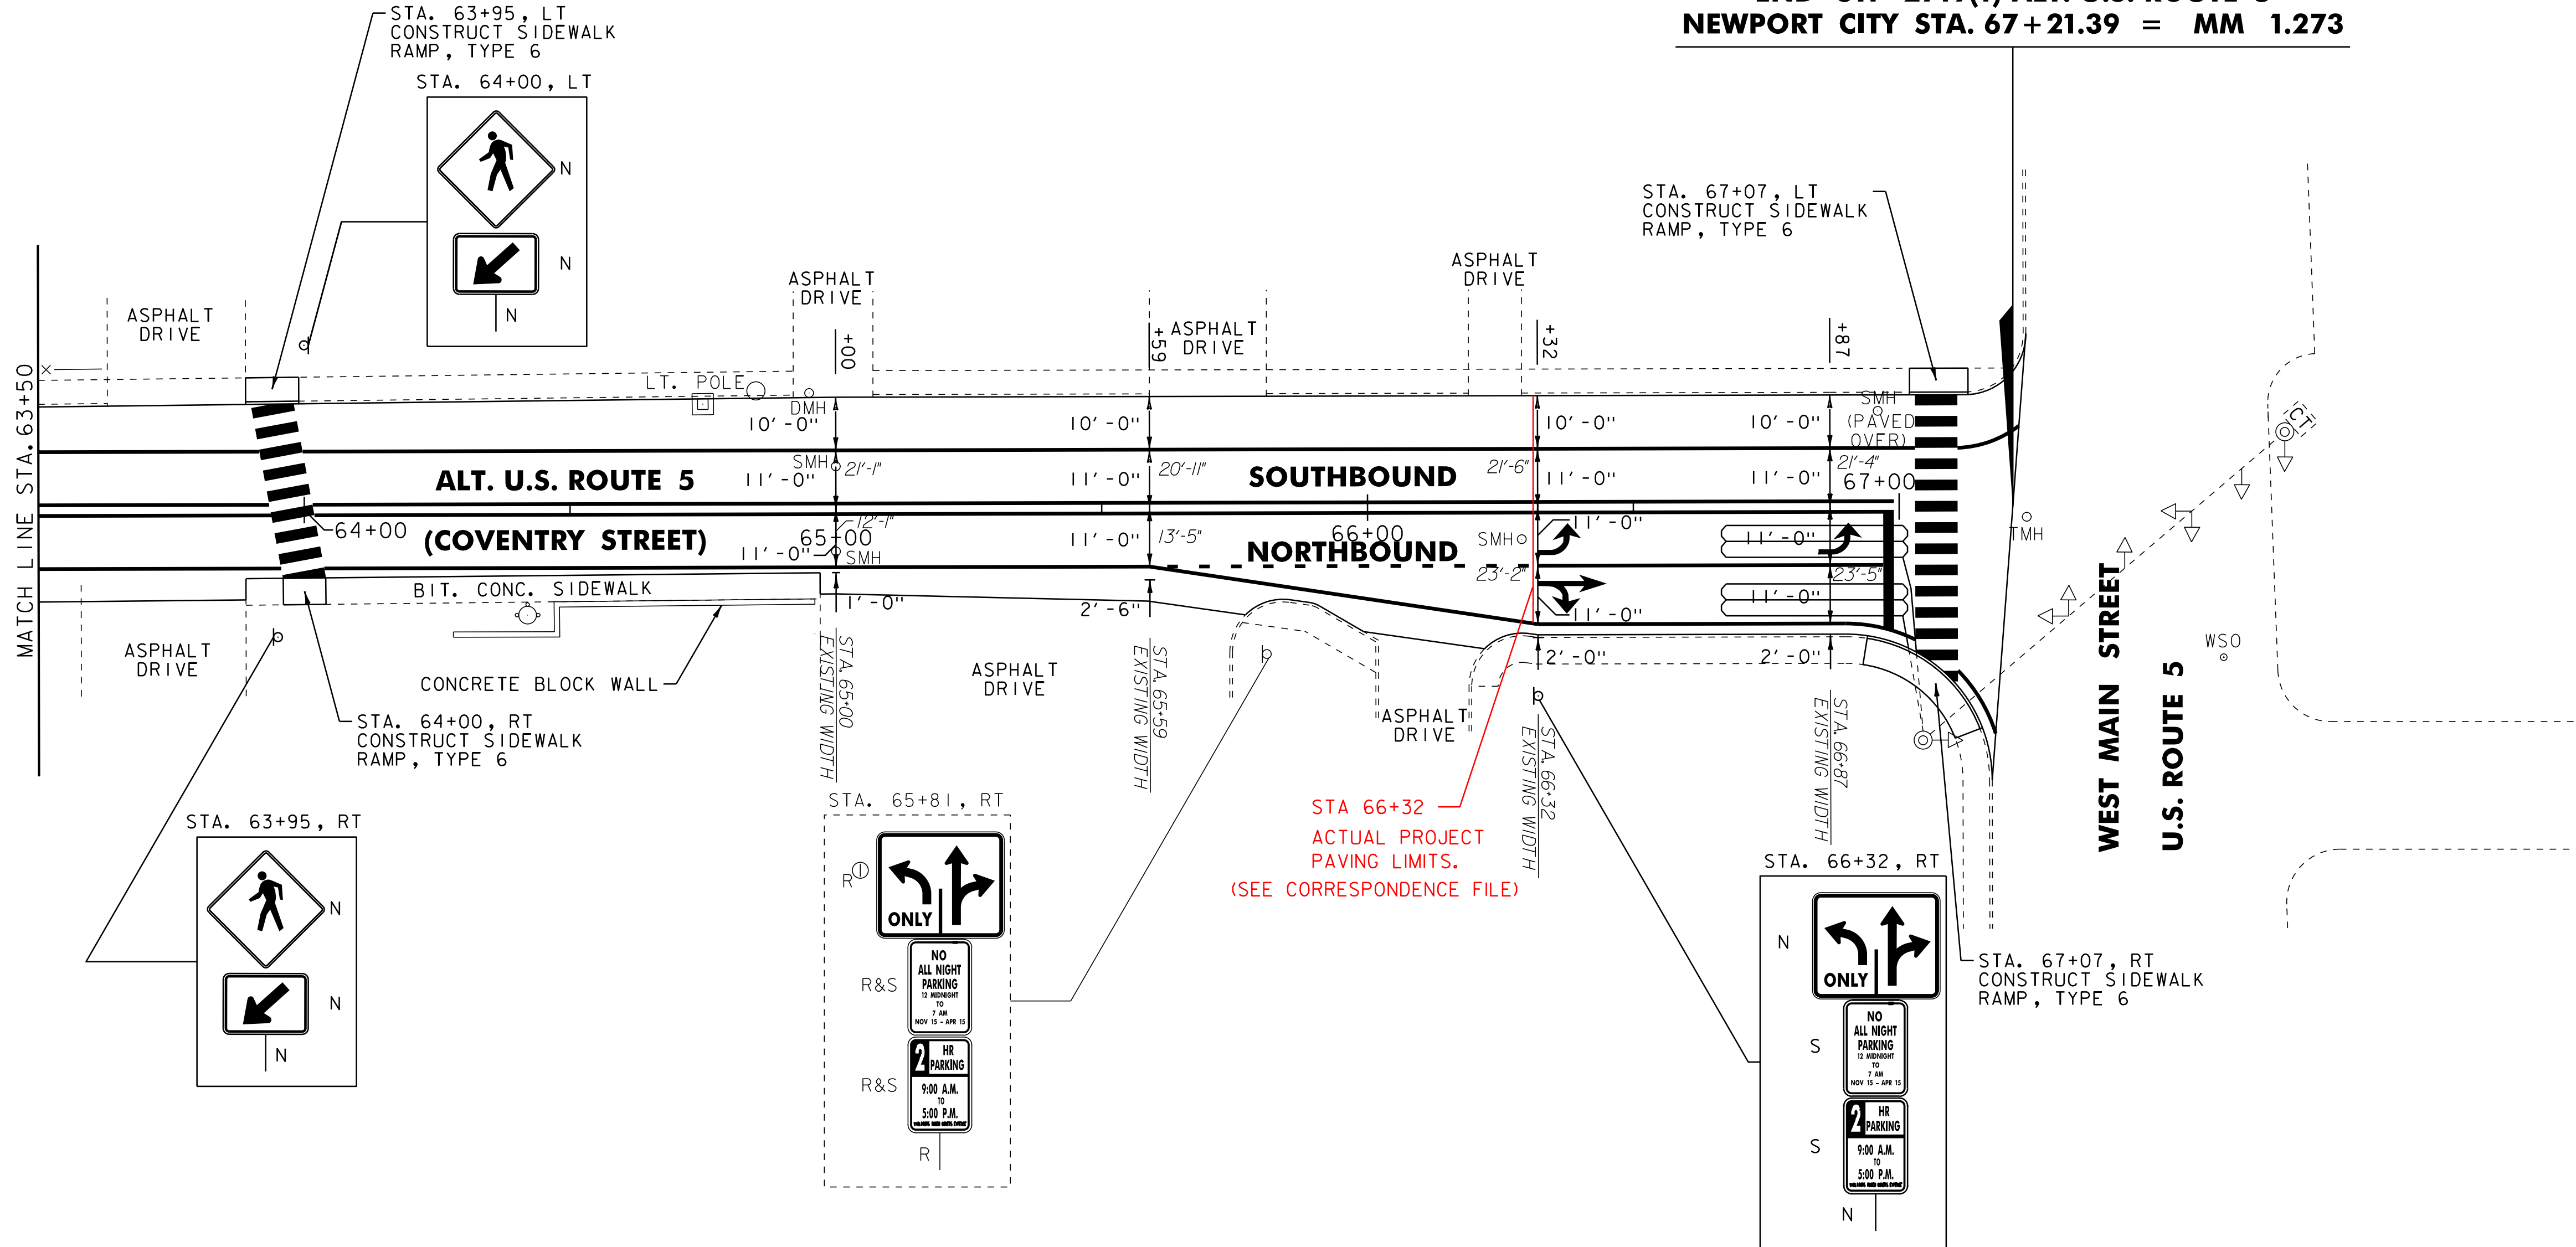

- NOTES:
1. ALL EXISTING SIGNS NOT SHOWN SHALL BE RETAINED.
2. FOR LEGEND, SEE LAYOUT SHEET #1

NOT TO SCALE

**PROJECT
LAYOUT
SHEET #8**

PROJECT NAME: NEWPORT CITY
PROJECT NUMBER: STP 2719(1)

FILE NAME: 07D202.dgn
PROJECT LEADER: JLL
DESIGNED BY: STANTEC
IPARM FILE: 07D202_I9.i

PLOT DATE: 29-JAN-2013 09:2
DRAWN BY: STANTEC
CHECKED BY: JLL
SHEET 19 OF 62