

604.412, 604.415 OR 604.418 REHAB,
DIS, CBS OR MHS, CLASS I, II OR III
STA. 290+70, RT


604.42 CHANGING ELEVATION OF SEWER MANHOLES
STA. 289+46, LT

646.402 DURABLE 4 INCH WHITE LINE, THERMOPLASTIC
STA. 285+50 TO 291+50, SOLID LT & RT

646.412 DURABLE 4 INCH YELLOW LINE, THERMOPLASTIC
STA. 285+50 TO 291+50, SOLID LT & RT

646.602 TEMPORARY 4 INCH WHITE LINE, PAINT
STA. 285+50 TO 291+50, SOLID LT & RT

646.612 TEMPORARY 4 INCH YELLOW LINE, PAINT
STA. 285+50 TO 291+50, SOLID LT & RT

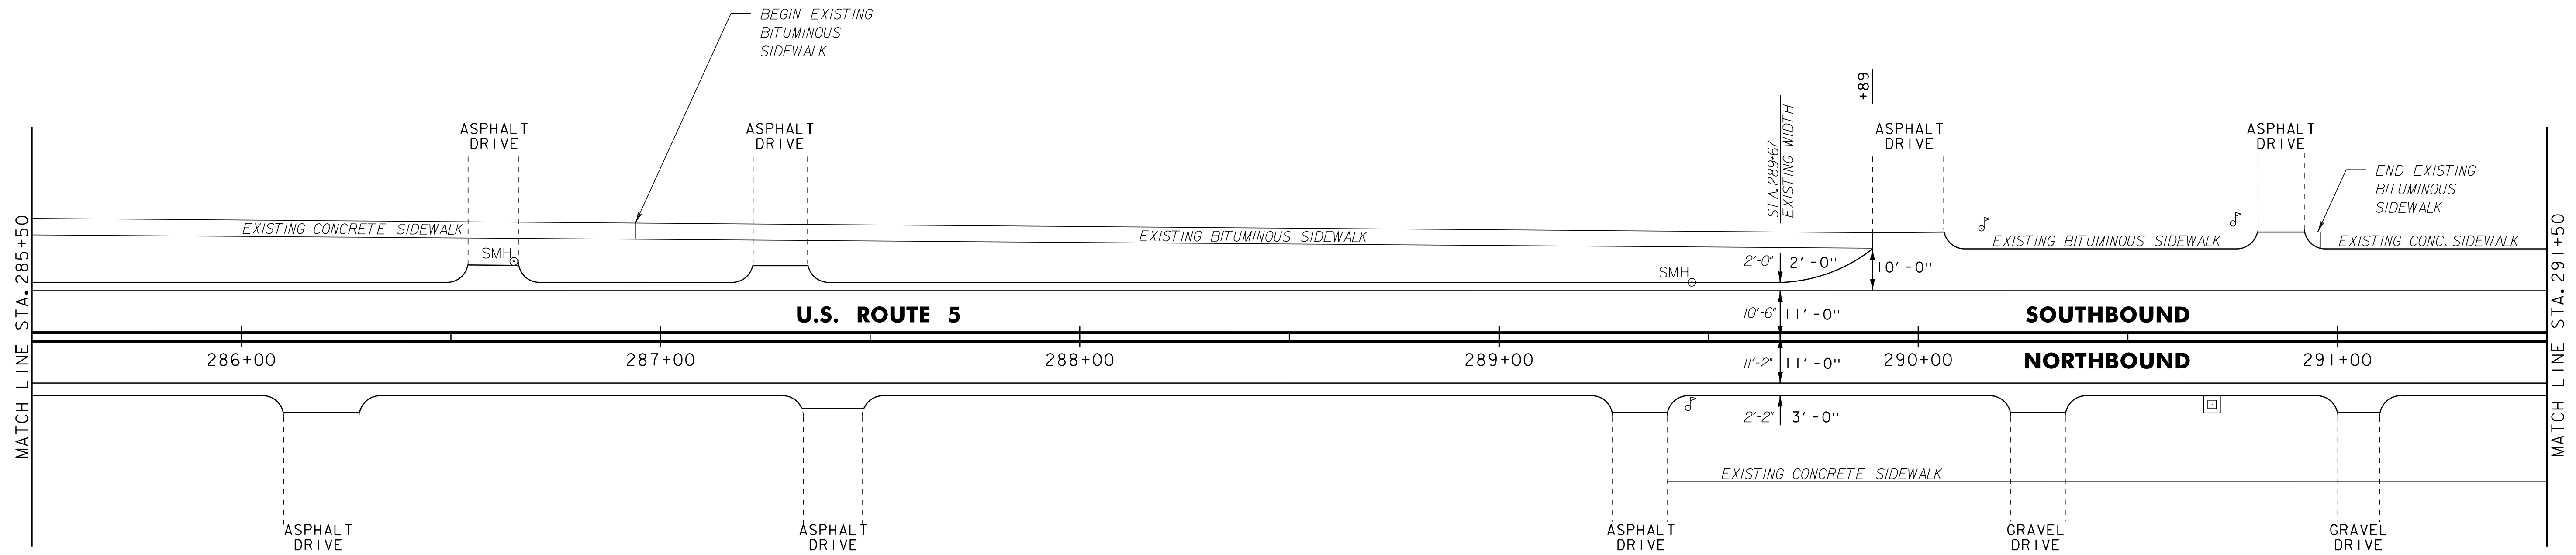

- NOTE:
- FOR LEGENDS, SEE LAYOUT SHEET #1.
 - ALL EXISTING SIGNS NOT SHOWN SHALL BE RETAINED.

NOT TO SCALE

**PROJECT
LAYOUT
SHEET #4**

PROJECT NAME: DERBY
PROJECT NUMBER: STP 2703(I)

FILE NAME: 07D202.dgn
PROJECT LEADER: JLL
DESIGNED BY: STANTEC
IPARM FILE: 07C194_37.i

PLOT DATE: 29-JAN-2013 09:2
DRAWN BY: STANTEC
CHECKED BY: JLL
SHEET 37 OF 62