

604.412, 604.415 OR 604.418 REHAB.
 DIS, CBS OR MHS, CLASS I, II OR III
 STA. 292+59, LT
 STA. 293+25, RT
~~STA. 295+09, LT~~ ELIMINATED - FILLED WITH FLOWABLE FILL

604.42 CHANGING ELEVATION OF SEWER MANHOLES
 STA. 292+37, LT
 STA. 295+03, RT
 STA. 295+33, LT

618.10 PORTLAND CEMENT CONCRETE SIDEWALK, 5 INCH
 STA. 294+92, RT
 STA. 295+18, RT
 STA. 295+19, LT
 STA. 295+64, LT

618.30 DETECTABLE WARNING SURFACE
 STA. 294+92, RT
 STA. 295+18, RT
 STA. 295+19, LT
 STA. 295+21, RT
 STA. 295+64, LT

629.20 ADJUST ELEVATION OF VALVE BOX
 STA. 295+04, RT
 STA. 295+09, RT
 STA. 295+11, RT
~~STA. 296+40, LT~~ ELIMINATED BY TOWN OF DERBY LINE

646.402 DURABLE 4 INCH WHITE LINE, THERMOPLASTIC
 STA. 291+50 TO 297+50, SOLID LT & RT
 STA. 295+34, LT (BEACH STREET EDGELINES)
 646.412 DURABLE 4 INCH YELLOW LINE, THERMOPLASTIC
 (ALL LINES WILL INCLUDE C BREAKS FOR SIDE ROADS)
 STA. 291+50 TO 297+50, SOLID LT & RT
 STA. 295+34, DOUBLE SOLID LT (BEACH ST. CENTERLINE)

646.482 DURABLE 24 INCH STOP BAR, THERMOPLASTIC
 STA. 295+28, LT (BEACH ST.)

646.492 DURABLE LETTER OR SYMBOL, THERMOPLASTIC
 STA. 295+28, LT - "STOP"

646.502 DURABLE CROSSWALK MARKING, THERMOPLASTIC
 STA. 294+95 TO 295+15, RT
 STA. 295+19 LT - RT
 STA. 295+20 TO 295+56, LT

646.602 TEMPORARY 4 INCH WHITE LINE, PAINT
 STA. 291+50 TO 297+50, SOLID LT & RT
 STA. 295+34, LT (BEACH STREET EDGELINES)


646.612 TEMPORARY 4 INCH YELLOW LINE, PAINT
 (ALL LINES WILL INCLUDE C BREAKS FOR SIDE ROADS)
 STA. 291+50 TO 297+50, SOLID LT & RT
 STA. 295+34, DOUBLE SOLID LT (BEACH ST CENTERLINE.)

646.682 TEMPORARY 24 INCH STOP BAR, PAINT
 STA. 295+28, LT (BEACH ST.)

646.692 TEMPORARY LETTER OR SYMBOL, PAINT
 STA. 295+28, LT - "STOP"

646.702 TEMPORARY CROSSWALK MARKING, PAINT
 STA. 294+95 TO 295+15, RT
 STA. 295+19 LT - RT
 STA. 295+20 TO 295+56, LT

675.50 REMOVING SIGNS
 AS SHOWN - I

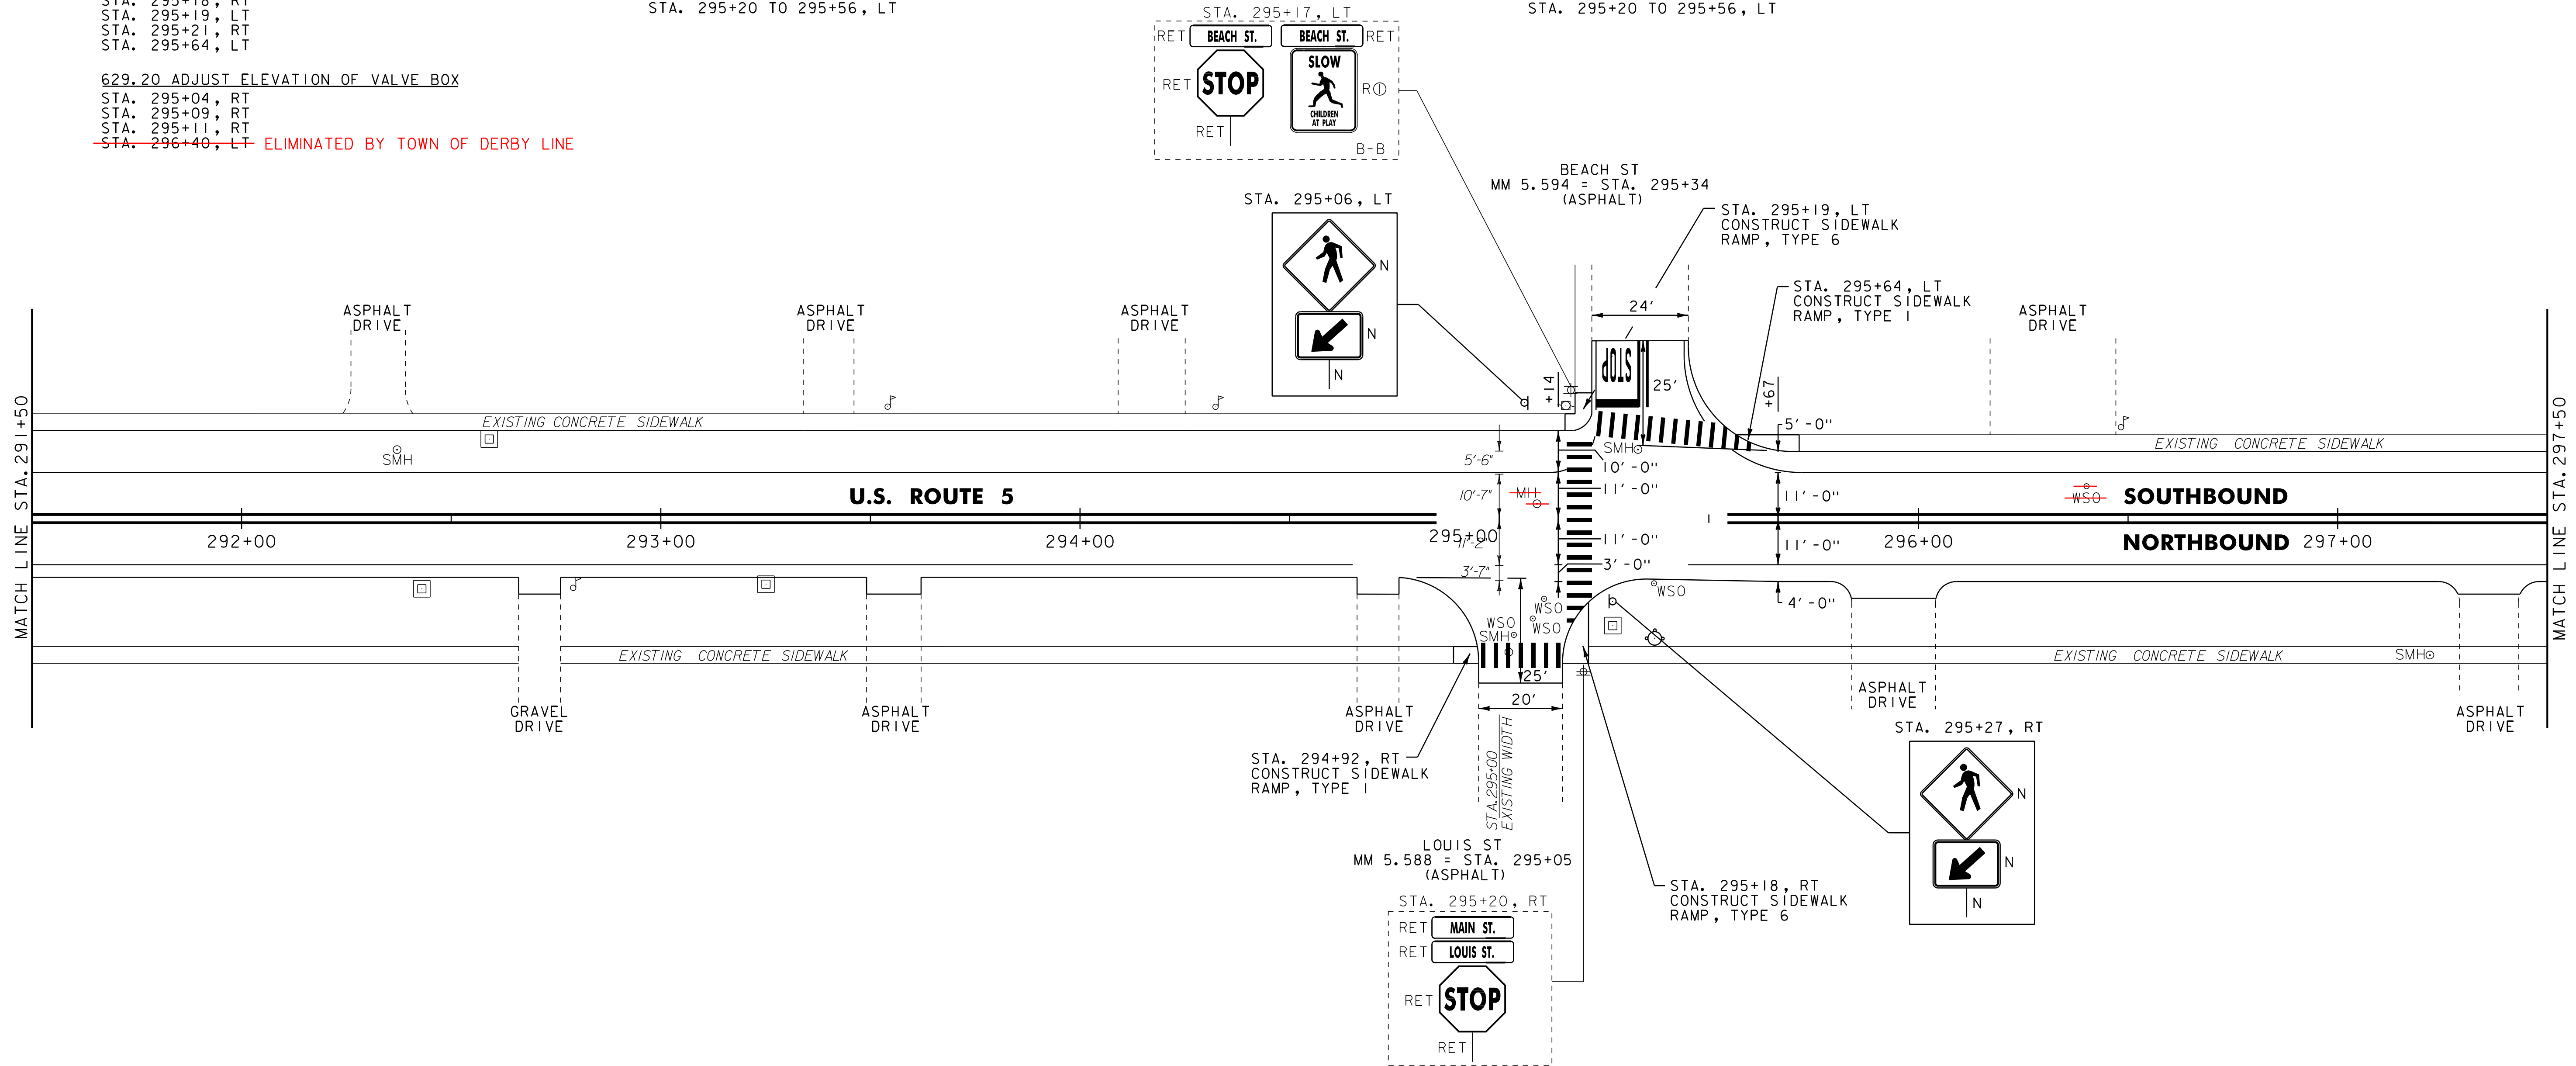

NOTE:
 1. FOR LEGENDS, SEE LAYOUT SHEET #1.
 2. ALL EXISTING SIGNS NOT SHOWN SHALL BE RETAINED.

NOT TO SCALE

PROJECT LAYOUT SHEET #5

PROJECT NAME: DERBY
 PROJECT NUMBER: STP 2703(I)

FILE NAME: 07D202.dgn
 PROJECT LEADER: JLL
 DESIGNED BY: STANTEC
 IPARM FILE: 07C194_38.i

PLOT DATE: 29-JAN-2013 09:2
 DRAWN BY: STANTEC
 CHECKED BY: JLL
 SHEET 38 OF 62