

604.412, 604.415 OR 604.418 REHAB.
DIS, CBS OR MHS, CLASS I, II OR III
STA. 306+26, LT
STA. 306+54, RT
STA. 307+17, LT
STA. 307+63, RT
STA. 308+67, LT
STA. 308+91, RT
STA. 309+41, LT

616.41 REMOVAL OF EXISTING CURB
STA. 305+95, RT
STA. 307+78, RT

646.402 DURABLE 4 INCH WHITE LINE, THERMOPLASTIC
(ALL LINES WILL INCLUDE EDGE LINE BREAKS AND RADIi FOR SIDE ROADS)
STA. 303+50 TO 305+43, SOLID LT
STA. 303+50 TO 306+67, SOLID RT
STA. 305+30, LT (BAXTER AVE. EDGELINES)
STA. 305+55 TO 309+50, SOLID LT & RT
(PARKING SPACES & DIAGONALS WITH EDGELINE BREAKS FOR CROSSWALK)

646.602 TEMPORARY 4 INCH WHITE LINE, PAINT
(ALL LINES WILL INCLUDE EDGE LINE BREAKS AND RADIi FOR SIDE ROADS)
STA. 303+50 TO 305+43, SOLID LT
STA. 303+50 TO 306+67, SOLID RT
STA. 305+30, LT (BAXTER AVE. EDGELINES)
STA. 305+55 TO 309+50, SOLID LT & RT
(PARKING SPACES & DIAGONALS WITH EDGELINE BREAKS FOR CROSSWALK)

675.50 REMOVING SIGNS
AS SHOWN - 2

604.42 CHANGING ELEVATION OF SEWER MANHOLES

STA. 305+87, LT
STA. 306+06, RT
STA. 307+96, LT
STA. 307+97, RT
STA. 306+15, LT
616.28 CAST-IN-PLACE CONCRETE CURB, TYPE B
STA. 305+95, RT
STA. 307+78, RT

618.30 DETECTABLE WARNING SURFACE

STA. 304+72, LT
STA. 305+50, LT
STA. 305+95, RT
STA. 307+74, LT
STA. 307+78, RT

646.412 DURABLE 4 INCH YELLOW LINE, THERMOPLASTIC
(ALL LINES WILL INCLUDE Q BREAKS FOR SIDE ROADS)
STA. 303+50 TO 309+50, SOLID LT & RT
STA. 305+30, DOUBLE SOLID LT (BAXTER AVE. CENTERLINE)

646.612 TEMPORARY 4 INCH YELLOW LINE, PAINT
(ALL LINES WILL INCLUDE Q BREAKS FOR SIDE ROADS)
STA. 303+50 TO 309+50, SOLID LT & RT
STA. 305+30, DOUBLE SOLID LT (BAXTER AVE. CENTERLINE)

646.482 DURABLE 24 INCH STOP BAR, THERMOPLASTIC
STA. 304+95, LT (BAXTER AVE.)

646.682 TEMPORARY 24 INCH STOP BAR, PAINT
STA. 304+95, LT (BAXTER AVE.)

646.492 DURABLE LETTER OR SYMBOL, THERMOPLASTIC
STA. 304+97, LT - "STOP"



646.692 TEMPORARY LETTER OR SYMBOL, PAINT
STA. 304+97, LT - "STOP"

646.502 DURABLE CROSSWALK MARKING, THERMOPLASTIC
STA. 304+72 TO 305+45, LT
STA. 305+50, LT TO 305+89, RT
STA. 307+71, LT TO 307+78, RT
STA. 307+81 TO 309+50, LT

646.702 TEMPORARY CROSSWALK MARKING, PAINT
STA. 304+72 TO 305+45, LT
STA. 305+50, LT TO 305+89, RT
STA. 307+71, LT TO 307+78, RT
STA. 307+81 TO 309+50, LT

629.20 ADJUST ELEVATION OF VALVE BOX

STA. 307+54, RT
STA. 307+67, RT
STA. 307+69, RT
STA. 308+68, RT ELIMINATED BY THE TOWN OF DERBY LINE
STA. 308+96, RT

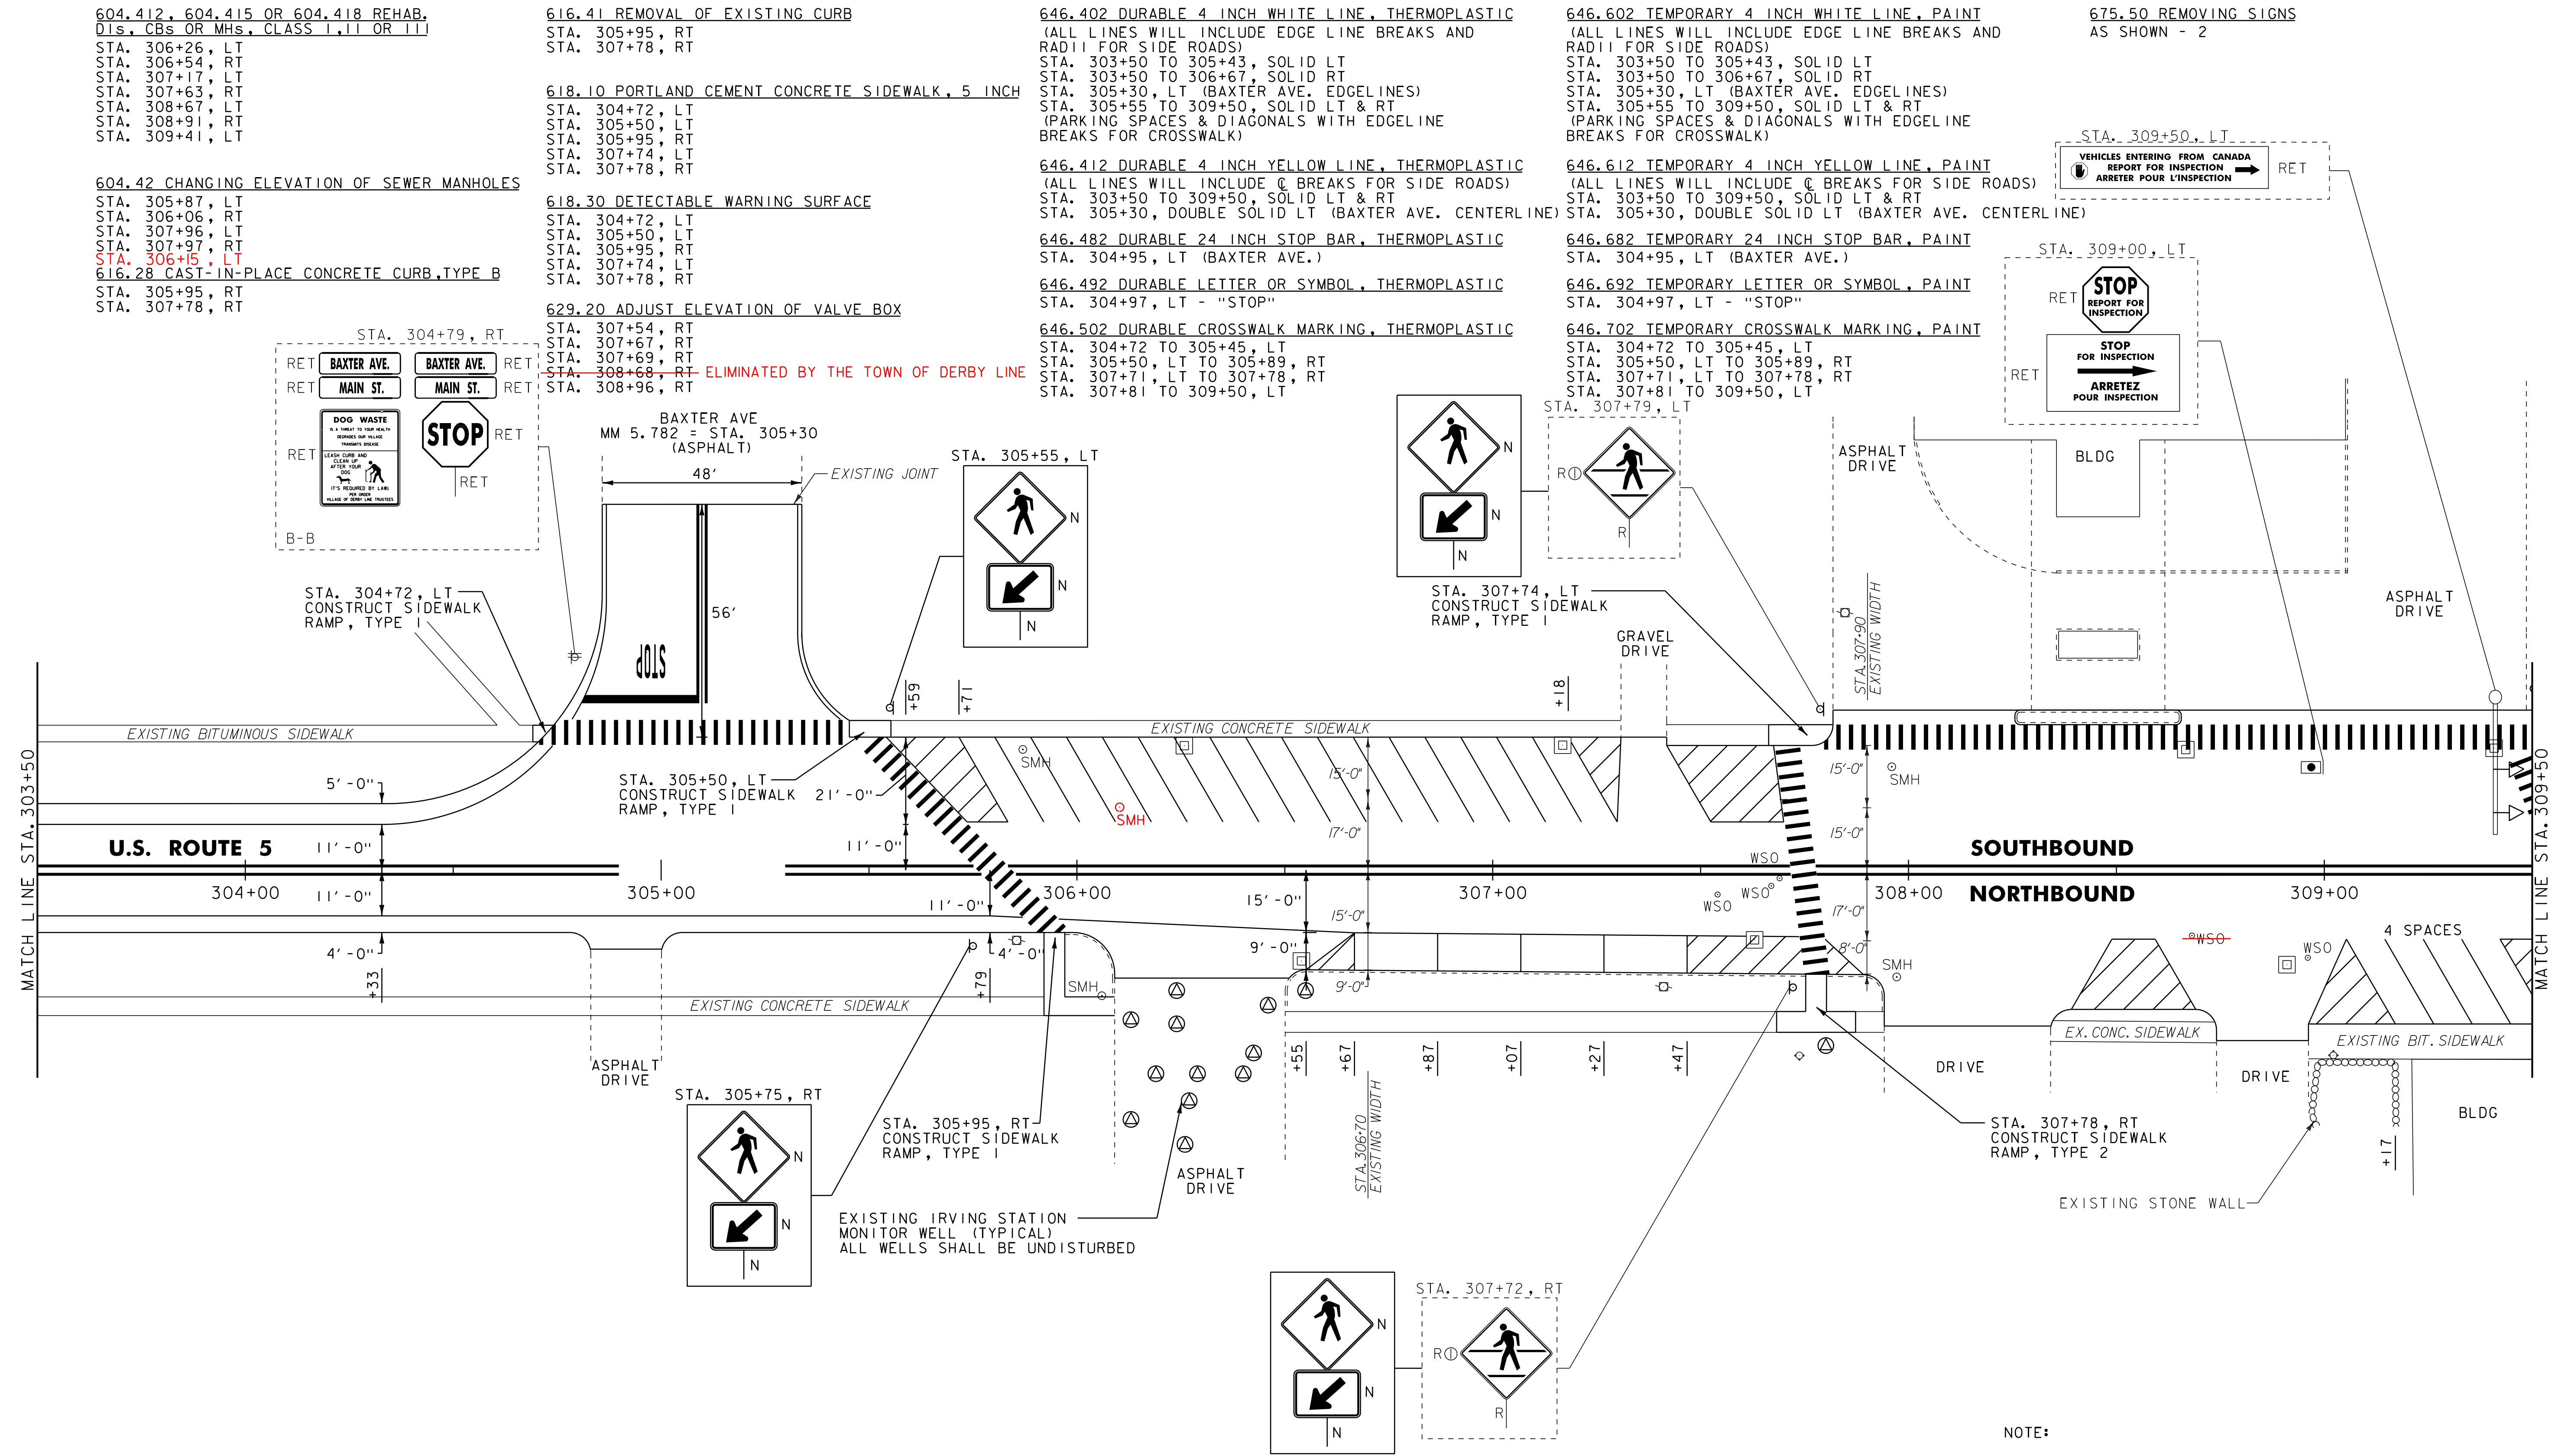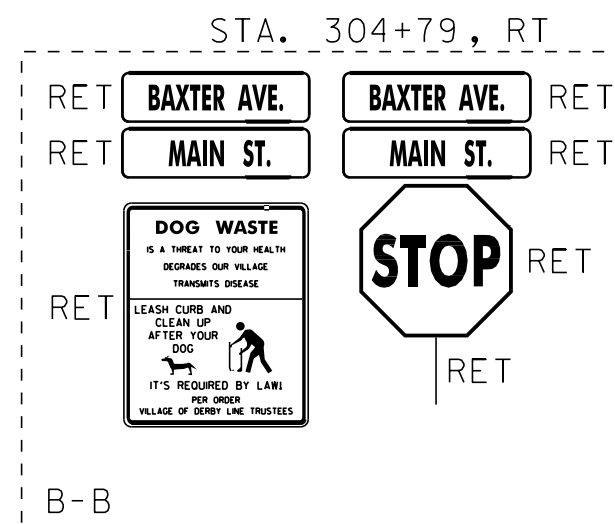

- NOTE:
1. FOR LEGENDS, SEE LAYOUT SHEET #1.
 2. ALL EXISTING SIGNS NOT SHOWN SHALL BE RETAINED.
 3. SEE THE PAVEMENT MARKING DETAIL SHEET FOR THE ANGLED PARKING STALL DETAILS.

NOT TO SCALE

PROJECT LAYOUT SHEET #7

PROJECT NAME: DERBY	FILE NAME: 07C194.dgn	PLOT DATE: 29-JAN-2013 09:2
PROJECT NUMBER: STP 2703(I)	PROJECT LEADER: JLL	DRAWN BY: STANTEC
	DESIGNED BY: STANTEC	CHECKED BY: JLL
	IPARM FILE: 07C194_40.i	SHEET 40 OF 62