

604.412, 604.415 OR 604.418 REHAB.
DIS, CBS OR MHS, CLASS 1, II OR III

STA. 3+64, LT
STA. 3+83, RT
STA. 4+86, LT
STA. 7+02, RT
STA. 7+11, LT

604.42 CHANGING ELEVATION OF SEWER MANHOLES

STA. 1+54, CL
STA. 2+15, CL
STA. 3+69, RT
STA. 3+78, LT
STA. 4+01, RT

~~STA. 5+42, RT ELIMINATED BY TOWN OF DERBY LINE~~

618.10 PORTLAND CEMENT CONCRETE SIDEWALK, 5 INCH

STA. 1+88, LT
STA. 1+89, RT
STA. 2+47, RT
STA. 2+91, RT
STA. 5+67, LT & RT

618.30 DETECTABLE WARNING SURFACE

STA. 1+88, LT
STA. 1+89, RT
STA. 2+47, RT
STA. 2+91, RT
STA. 5+67, LT & RT

629.20 ADJUST ELEVATION OF VALVE BOX

~~STA. 5+55, RT ELIMINATED BY TOWN OF DERBY LINE~~

646.402 DURABLE 4 INCH WHITE LINE, THERMOPLASTIC

(ALL LINES WILL INCLUDE EDGE LINE BREAKS AND
RADIUS FOR SIDE ROADS)
STA. 1+50 TO 7+50, SOLID LT & RT
STA. 4+17, LT (CHURCH STREET EDGELINES)

646.412 DURABLE 4 INCH YELLOW LINE, THERMOPLASTIC

(ALL LINES WILL INCLUDE @ BREAKS FOR SIDE ROADS)
STA. 1+50 TO 7+50, SOLID LT & RT
STA. 4+17, DOUBLE SOLID LT (CHURCH ST. CENTERLINE)

646.482 DURABLE 24 INCH STOP BAR, THERMOPLASTIC

STA. 4+18, LT (CHURCH ST.)
STA. 5+11, LT (CHURCH ST.)
STA. 5+23, LT (CHURCH ST.)

646.492 DURABLE LETTER OR SYMBOL, THERMOPLASTIC

STA. 4+25, LT - "STOP"
STA. 5+11, LT - "STOP"
STA. 5+26, LT - "STOP"

646.502 DURABLE CROSSWALK MARKING, THERMOPLASTIC

STA. 1+89, LT - RT
STA. 2+49 TO 2+88, RT
STA. 4+52 TO 5+34, LT
STA. 5+67, LT - RT

646.602 TEMPORARY 4 INCH WHITE LINE, PAINT

(ALL LINES WILL INCLUDE EDGE LINE BREAKS AND
RADIUS FOR SIDE ROADS)
STA. 1+50 TO 7+50, SOLID LT & RT
STA. 4+17, LT (CHURCH STREET EDGELINES)

646.612 TEMPORARY 4 INCH YELLOW LINE, PAINT

(ALL LINES WILL INCLUDE @ BREAKS FOR SIDE ROADS)
STA. 1+50 TO 7+50, SOLID LT & RT
STA. 4+17, DOUBLE SOLID LT (CHURCH ST. CENTERLINE)

646.682 TEMPORARY 24 INCH STOP BAR, PAINT

STA. 4+18, LT (CHURCH ST.)
STA. 5+11, LT (CHURCH ST.)
STA. 5+23, LT (CHURCH ST.)

646.692 TEMPORARY LETTER OR SYMBOL, PAINT

STA. 4+25, LT - "STOP"
STA. 5+11, LT - "STOP"
STA. 5+26, LT - "STOP"

646.702 TEMPORARY CROSSWALK MARKING, PAINT


STA. 1+89, LT - RT
STA. 2+49 TO 2+88, RT
STA. 4+52 TO 5+34, LT
STA. 5+67, LT - RT

675.50 REMOVING SIGNS

AS SHOWN - 6

675.60 ERECTING SALVAGED SIGNS

AS SHOWN - 1

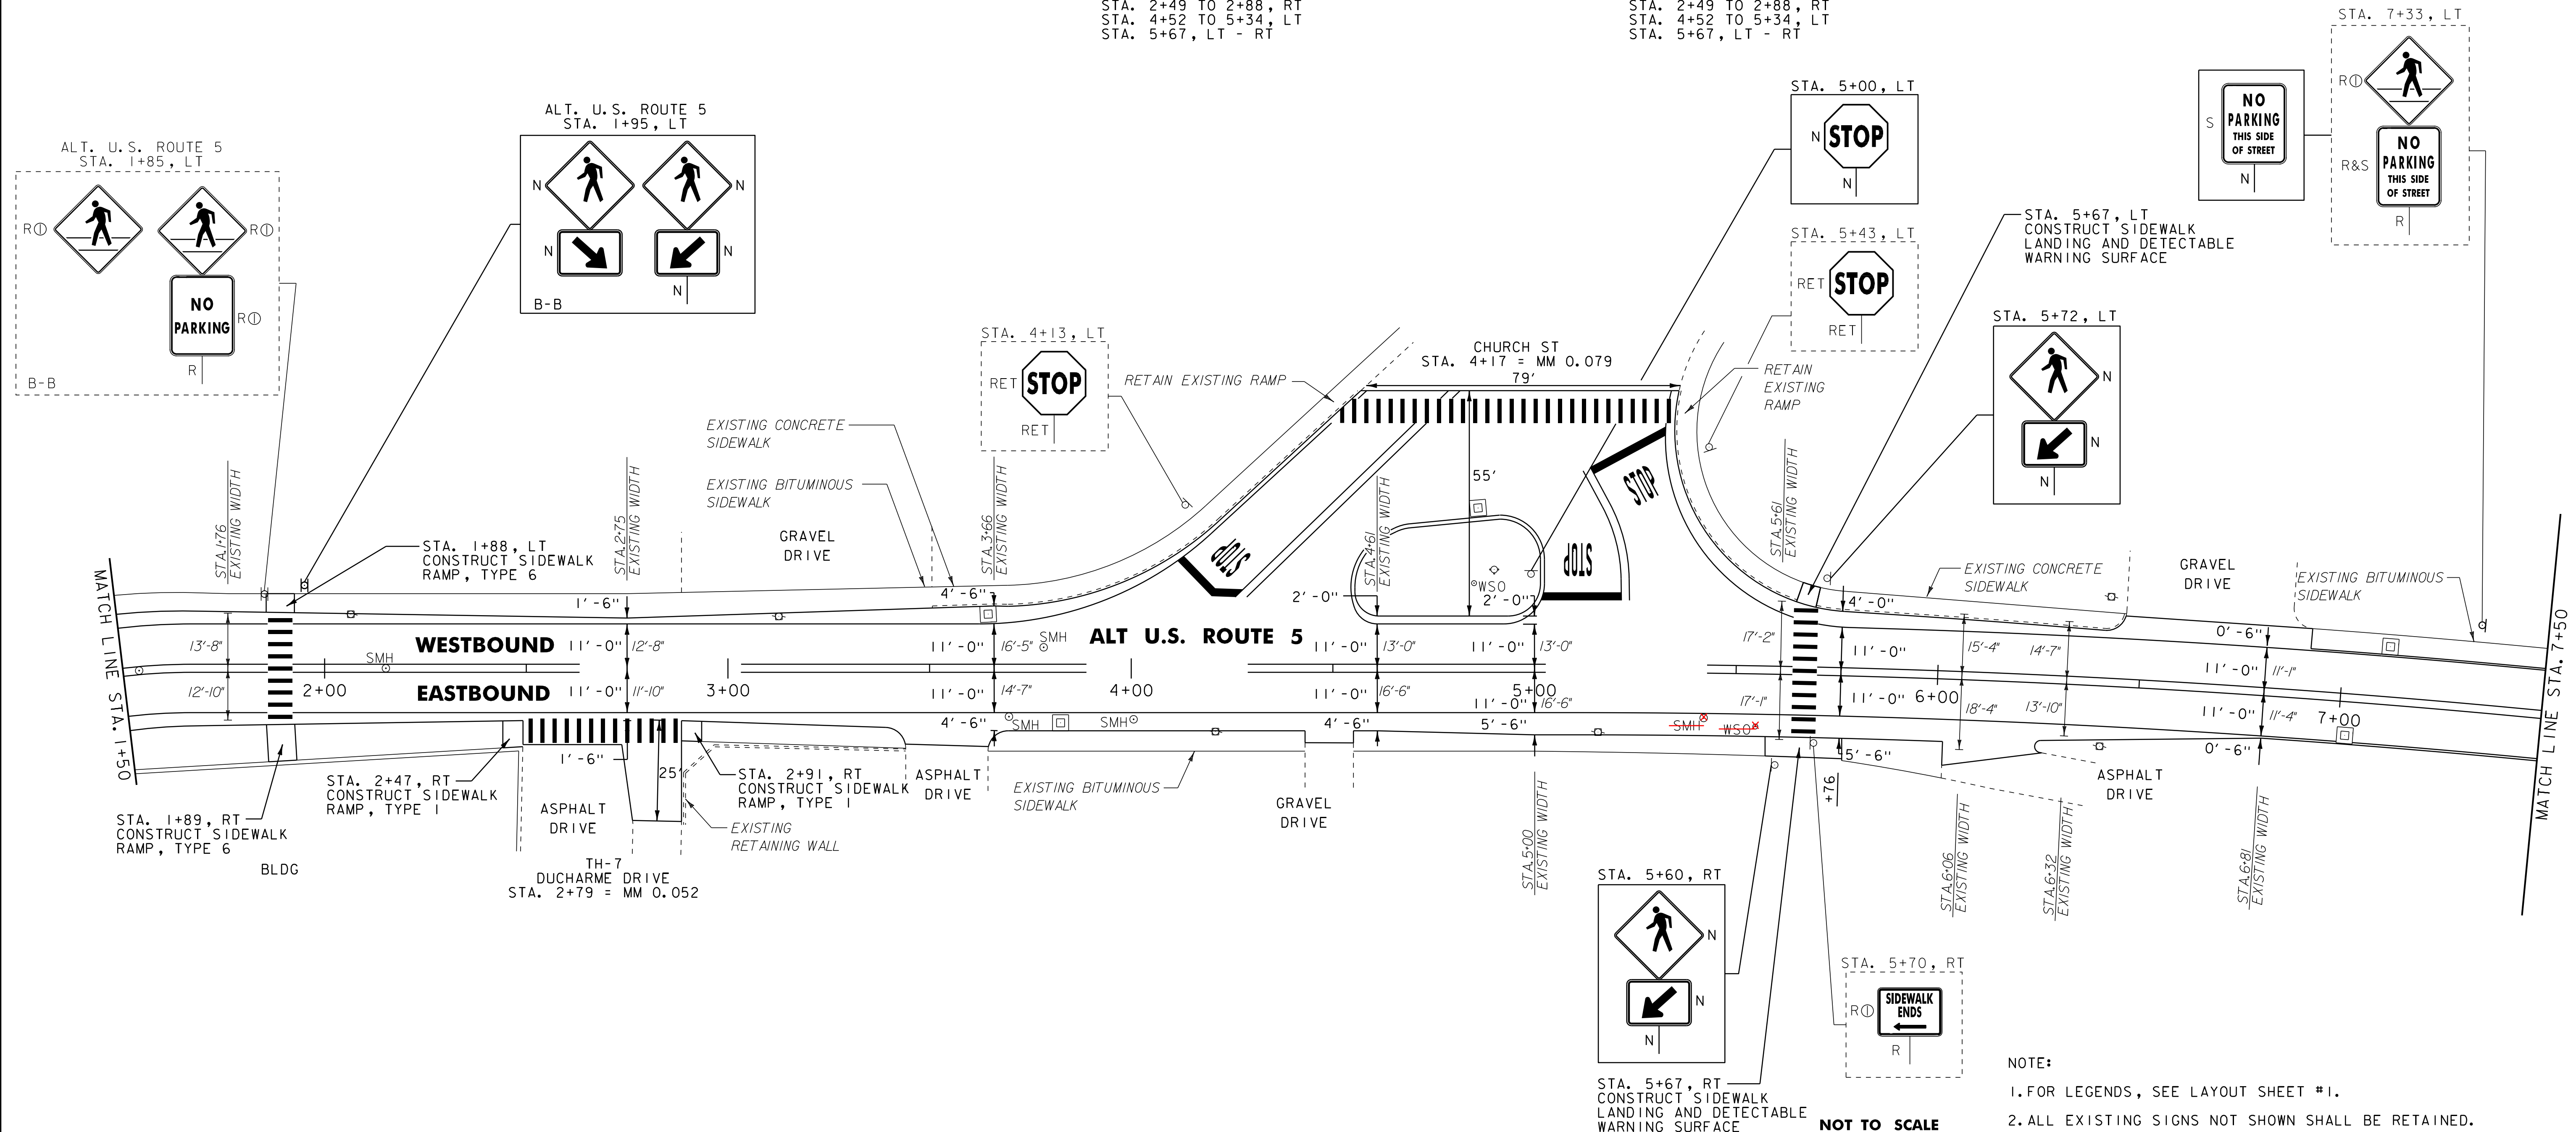

NOTE:
 1. FOR LEGENDS, SEE LAYOUT SHEET #1.
 2. ALL EXISTING SIGNS NOT SHOWN SHALL BE RETAINED.

PROJECT LAYOUT SHEET #9

PROJECT NAME: DERBY
 PROJECT NUMBER: STP 2703(I)

FILE NAME: 07D202.dgn
 PROJECT LEADER: JLL
 DESIGNED BY: STANTEC
 IPARM FILE: 07C194_42.i

PLOT DATE: 29-JAN-2013 09:2
 DRAWN BY: STANTEC
 CHECKED BY: JLL
 SHEET 42 OF 62