

~~620.75 SNOW BARRIER, GALVANIZED  
 STA. 29+26 TO 29+98, RT  
 STA. 29+74 TO 30+42, LT  
 STA. 30+69 TO 31+41, RT  
 STA. 31+18 TO 31+50, LT~~

THIS ITEM ELIMINATED  
 FROM THE CONTRACT

621.20 STEEL BEAM GUARDRAIL, GALVANIZED  
~~STA. 25+70.5 TO 28+33, RT STA. 25+95.5 TO 28+58, RT  
 STA. 26+04 TO 28+54, LT STA. 25+91.5 TO 28+79, LT~~

621.60 ANCHOR FOR STEEL BEAM RAIL  
~~STA. 25+70.5, RT STA. 25+95.5, RT  
 STA. 26+04, LT STA. 25+91.5, LT~~

621.74 ALUMINUM APPROACH RAILING  
~~STA. 28+33 TO 28+58, RT STA. 28+58 TO 28+83, RT  
 STA. 28+54 TO 28+79, LT STA. 28+79 TO 29+04, LT~~


621.80 REMOVAL AND DISPOSAL OF GUARDRAIL  
~~STA. 25+69 TO 28+58, RT STA. 25+95.5 TO 28+83, RT  
 STA. 26+13 TO 28+79, LT STA. 25+91.5 TO 29+04, LT~~

646.402 DURABLE 4 INCH WHITE LINE, THERMOPLASTIC  
 STA. 25+50 TO 31+50, SOLID LT & RT

646.412 DURABLE 4 INCH YELLOW LINE, THERMOPLASTIC  
 (ALL LINES WILL INCLUDE C BREAKS FOR SIDE ROADS)  
 STA. 25+50 TO 31+50, SOLID LT & RT

646.602 TEMPORARY 4 INCH WHITE LINE, PAINT  
 STA. 25+50 TO 31+50, SOLID LT & RT

646.612 TEMPORARY 4 INCH YELLOW LINE, PAINT  
 (ALL LINES WILL INCLUDE C BREAKS FOR SIDE ROADS)  
 STA. 25+50 TO 31+50, SOLID LT & RT

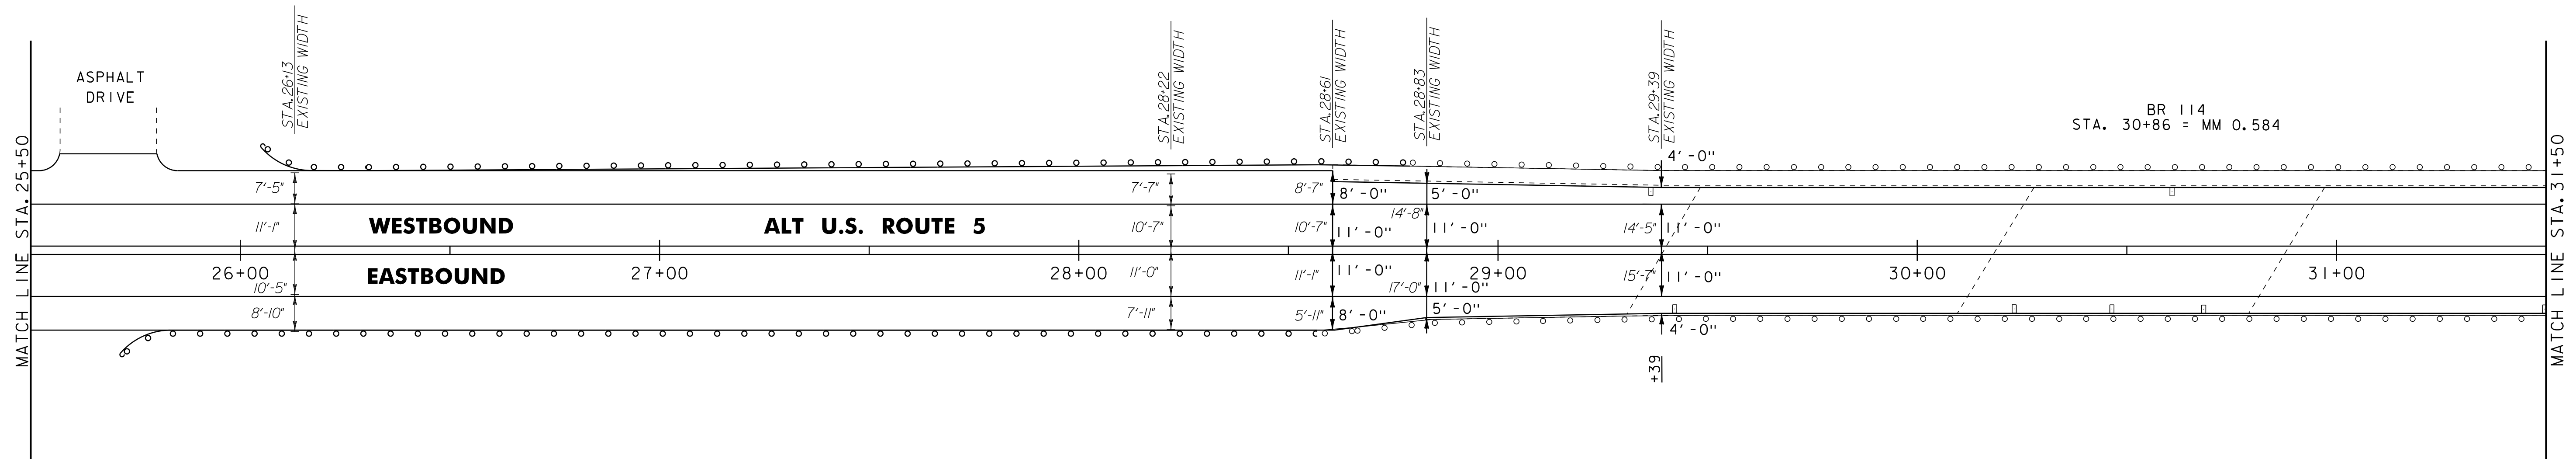

NOTE:  
 1. FOR LEGENDS, SEE LAYOUT SHEET #1.  
 2. ALL EXISTING SIGNS NOT SHOWN SHALL BE RETAINED.

**NOT TO SCALE**

<b>PROJECT LAYOUT SHEET #13</b>	PROJECT NAME: DERBY	PLOT DATE: 29-JAN-2013 09:2
	PROJECT NUMBER: STP 2703(I)	DRAWN BY: STANTEC
	FILE NAME: 07D202.dgn	CHECKED BY: JLL
	DESIGNED BY: STANTEC	SHEET 46 OF 62
	IPARM FILE: 07C194_46.i	