

646.402 DURABLE 4 INCH WHITE LINE, THERMOPLASTIC OR  
 646.403 DURABLE 4 INCH WHITE LINE, EPOXY PAINT  
 (ALL LINES WILL INCLUDE EDGE LINE BREAKS AND  
 RADIUS FOR SIDE ROADS)  
 STA. 0+00 TO 3+50, SOLID LT & RT  
 STA. 1+48, SOLID LT (LOGAN DRIVE)  
 STA. 0+32 RT MOUNTAIN VIEW DR.


646.412 DURABLE 4 INCH YELLOW LINE, THERMOPLASTIC OR  
 646.413 DURABLE 4 INCH YELLOW LINE, EPOXY PAINT  
 (ALL LINES WILL INCLUDE @ BREAKS FOR SIDE ROADS)  
 STA. 0+00 TO 3+50, SOLID LT & RT  
 STA. 1+48, DOUBLE SOLID LT (LOGAN DRIVE)  
 STA. 0+32 MOUNTAIN VIEW DR.

646.482 DURABLE 24 INCH STOP BAR, THERMOPLASTIC OR  
 646.483 DURABLE 24 INCH STOP BAR, EPOXY PAINT  
 STA. 1+48, LT (LOGAN DRIVE)  
 STA. 0+32 RT MOUNTAIN VIEW DR.  
 646.492 DURABLE LETTER OR SYMBOL, THERMOPLASTIC OR  
 646.493 DURABLE LETTER OR SYMBOL, EPOXY PAINT  
 STA. 1+48, LT (LOGAN DRIVE) - "STOP"  
 STA. 0+32 RT MOUNTAIN VIEW DR. "STOP"

646.602 TEMPORARY 4 INCH WHITE LINE, PAINT  
 (ALL LINES WILL INCLUDE EDGE LINE BREAKS AND  
 RADIUS FOR SIDE ROADS)  
 STA. 0+00 TO 3+50, SOLID LT & RT  
 STA. 1+48, SOLID LT (LOGAN DRIVE)  
 646.612 TEMPORARY 4 INCH YELLOW LINE, PAINT  
 (ALL LINES WILL INCLUDE @ BREAKS FOR SIDE ROADS)  
 STA. 0+00 TO 3+50, SOLID LT & RT  
 STA. 1+48, DOUBLE SOLID LT (LOGAN DRIVE)

646.682 TEMPORARY 24 INCH STOP BAR, PAINT  
 STA. 1+48, LT (LOGAN DRIVE)  
 646.692 TEMPORARY LETTER OR SYMBOL, PAINT  
 STA. 1+48, LT (LOGAN DRIVE) - "STOP"  
 675.50 REMOVING SIGNS  
 AS SHOWN - 9-8  
 675.60 ERECTING SALVAGED SIGNS  
 AS SHOWN - 1  
 629.20 ADJUST ELEVATION OF VALVE BOX  
 MOUNTAIN VIEW DRIVE - 5  
 613.10 STONE FILL, TYPE 1  
 STA. 0+87 TO 3+50 RT

**BEGIN STP 2720(1) VT ROUTE 105  
 NEWPORT CITY STA. 0+00.00 = MM 0.000**

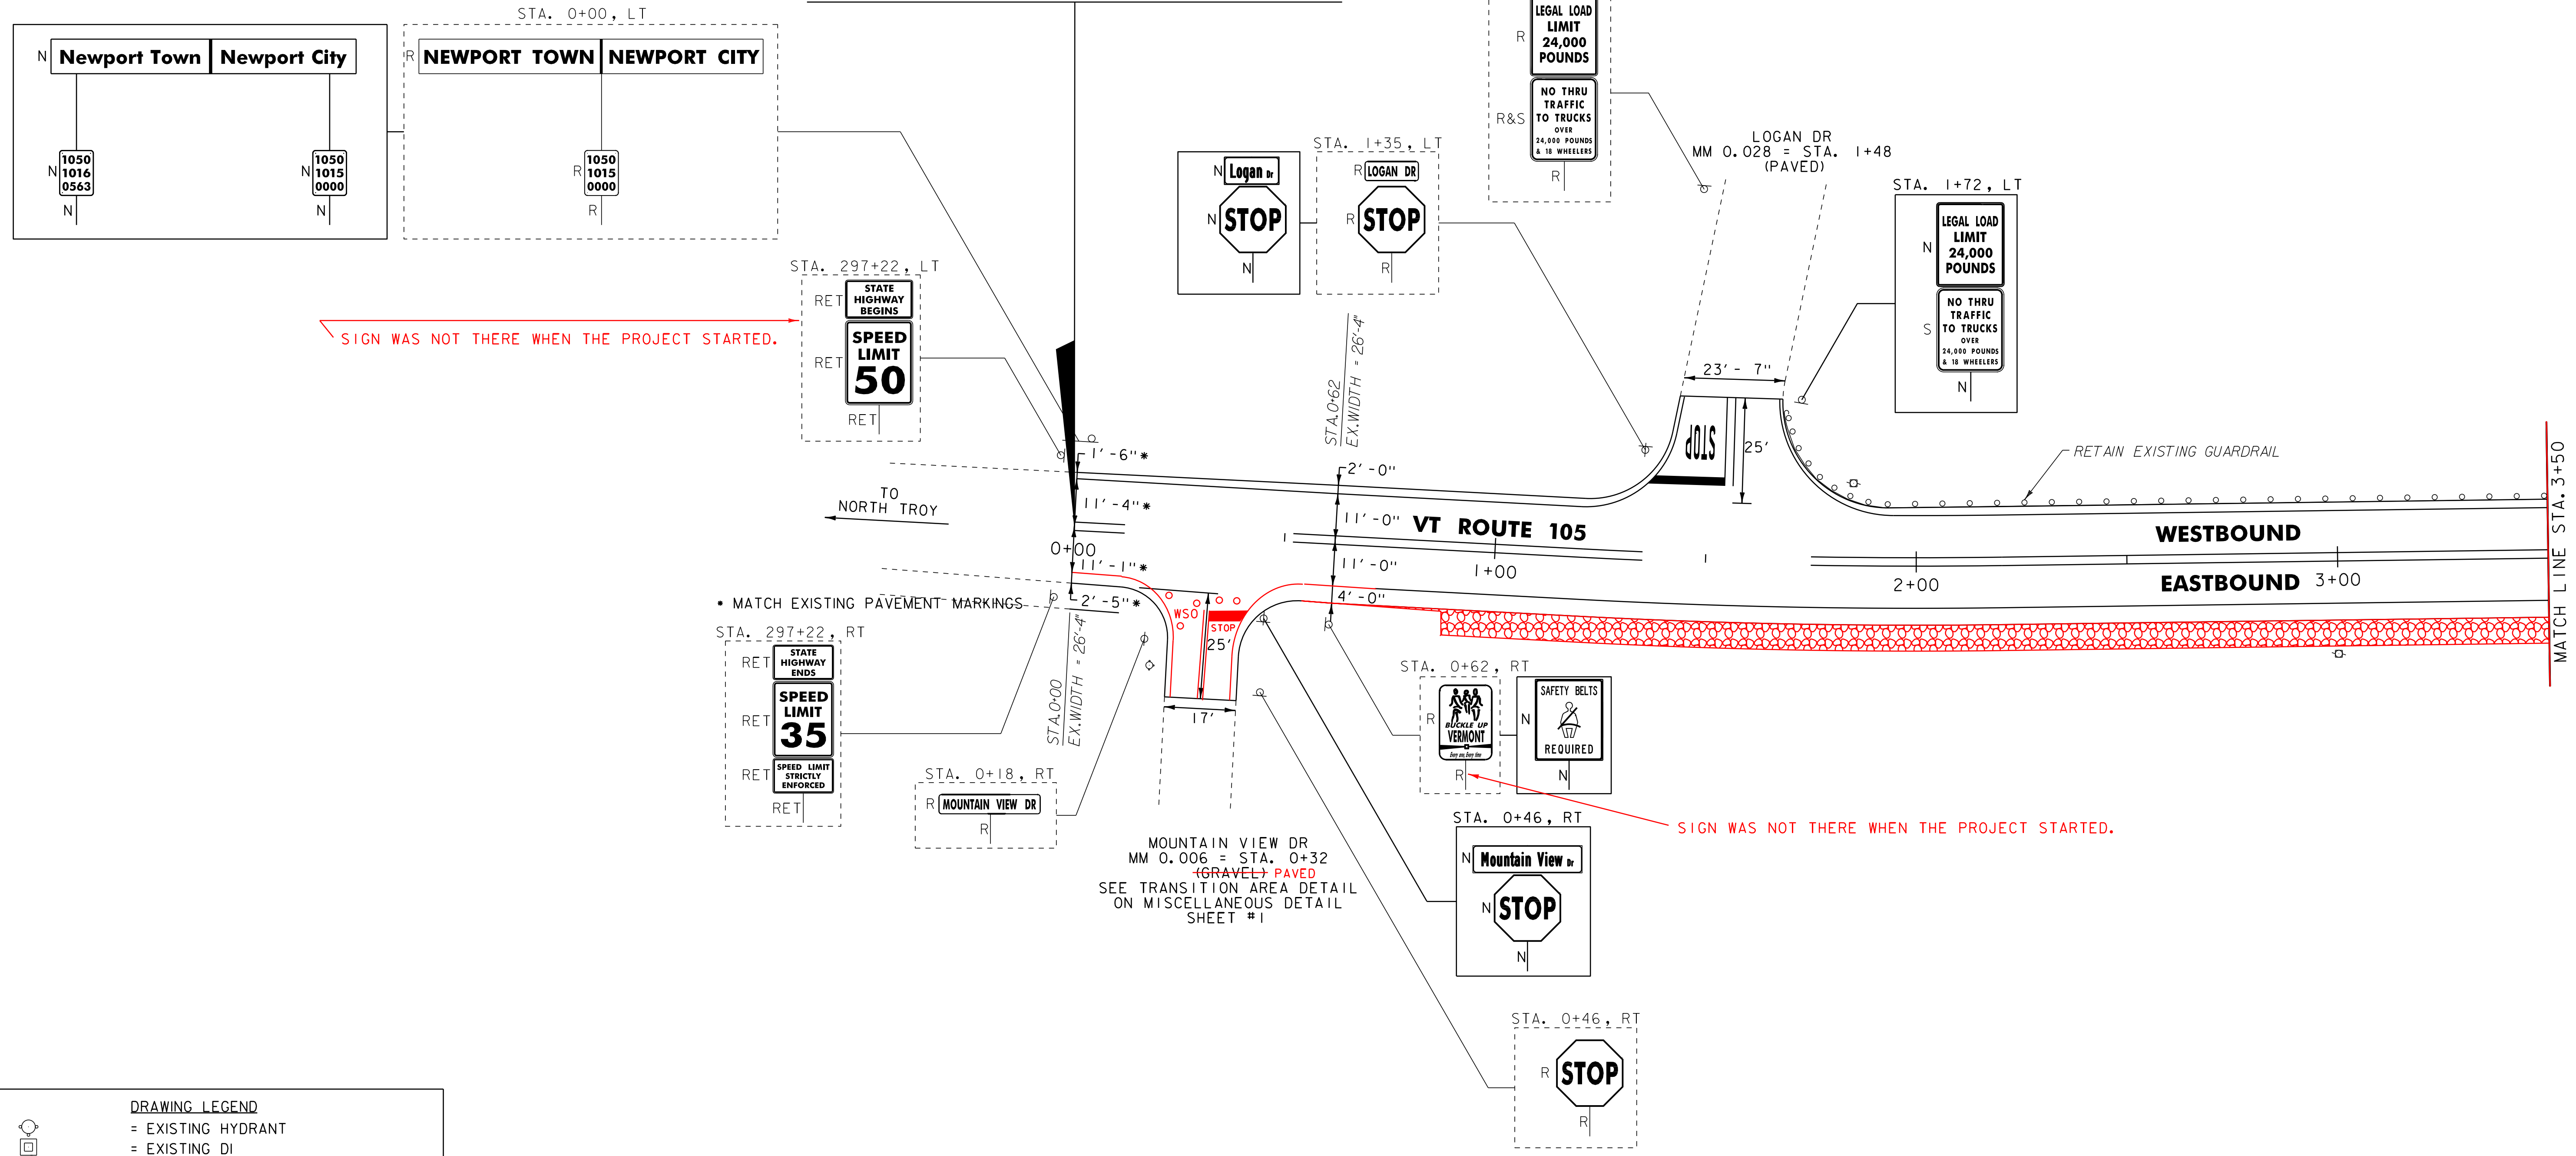

**DRAWING LEGEND**

	= EXISTING HYDRANT
	= EXISTING DI
	= EXISTING MANHOLE
	= EXISTING SIGN POSTS
	= EXISTING CONCRETE/STONE HEADWALL
	= EXISTING SEWER MANHOLE
	= EXISTING WATER SHUTOFF
	= EXISTING MAILBOX
	= EXISTING UTILITY POLE
	= EXISTING GUARDRAIL
	= EXISTING CULVERT

**SIGN LEGEND**

N	= NEW
R	= REMOVE
R&S	= REMOVE & SALVAGE
S	= SALVAGE SIGN
RET	= RETAIN
B-B	= BACK TO BACK

**NOT TO SCALE**

**PROJECT LAYOUT SHEET #1**

NOTE: ALL EXISTING SIGNS NOT SHOWN SHALL BE RETAINED.

PROJECT NAME: NEWPORT CITY	FILE NAME: p07d204.dgn	PLOT DATE: 28-NOV-2012 14:5
PROJECT NUMBER: STP 2720(1)	PROJECT LEADER: JLL	DRAWN BY: STANTEC
	DESIGNED BY: STANTEC	CHECKED BY: STANTEC
	IPARM FILE: p07d204101.i	SHEET 9 OF 30

