

646.402 DURABLE 4 INCH WHITE LINE, THERMOPLASTIC OR  
 646.403 DURABLE 4 INCH WHITE LINE, EPOXY PAINT  
 (ALL LINES WILL INCLUDE EDGE LINE BREAKS AND  
 RADII FOR SIDE ROADS)  
 STA. 26+50 TO 32+50, SOLID LT & RT

646.412 DURABLE 4 INCH YELLOW LINE, THERMOPLASTIC OR  
 646.413 DURABLE 4 INCH YELLOW LINE, EPOXY PAINT  
 (ALL LINES WILL INCLUDE C BREAKS FOR SIDE ROADS)  
 STA. 26+50 TO 32+50, SOLID LT & RT

646.442 DURABLE 8 INCH WHITE LINE, THERMOPLASTIC OR  
 646.443 DURABLE 8 INCH WHITE LINE, EPOXY PAINT  
 STA. 31+00 TO TO 31+12, RT


613.11 STONE FILL, TYPE 11  
 STA. 26+50 TO 27+50 LT  
 STA. 28+80 TO 29+31 LT

646.602 TEMPORARY 4 INCH WHITE LINE, PAINT  
 (ALL LINES WILL INCLUDE EDGE LINE BREAKS AND  
 RADII FOR SIDE ROADS)  
 STA. 26+50 TO 32+50, SOLID LT & RT

646.612 TEMPORARY 4 INCH YELLOW LINE, PAINT  
 (ALL LINES WILL INCLUDE C BREAKS FOR SIDE ROADS)  
 STA. 26+50 TO 32+50, SOLID LT & RT

646.642 TEMPORARY 8 INCH WHITE LINE, PAINT  
 STA. 31+00 TO TO 31+12, RT

675.50 REMOVING SIGNS  
 AS SHOWN - 3

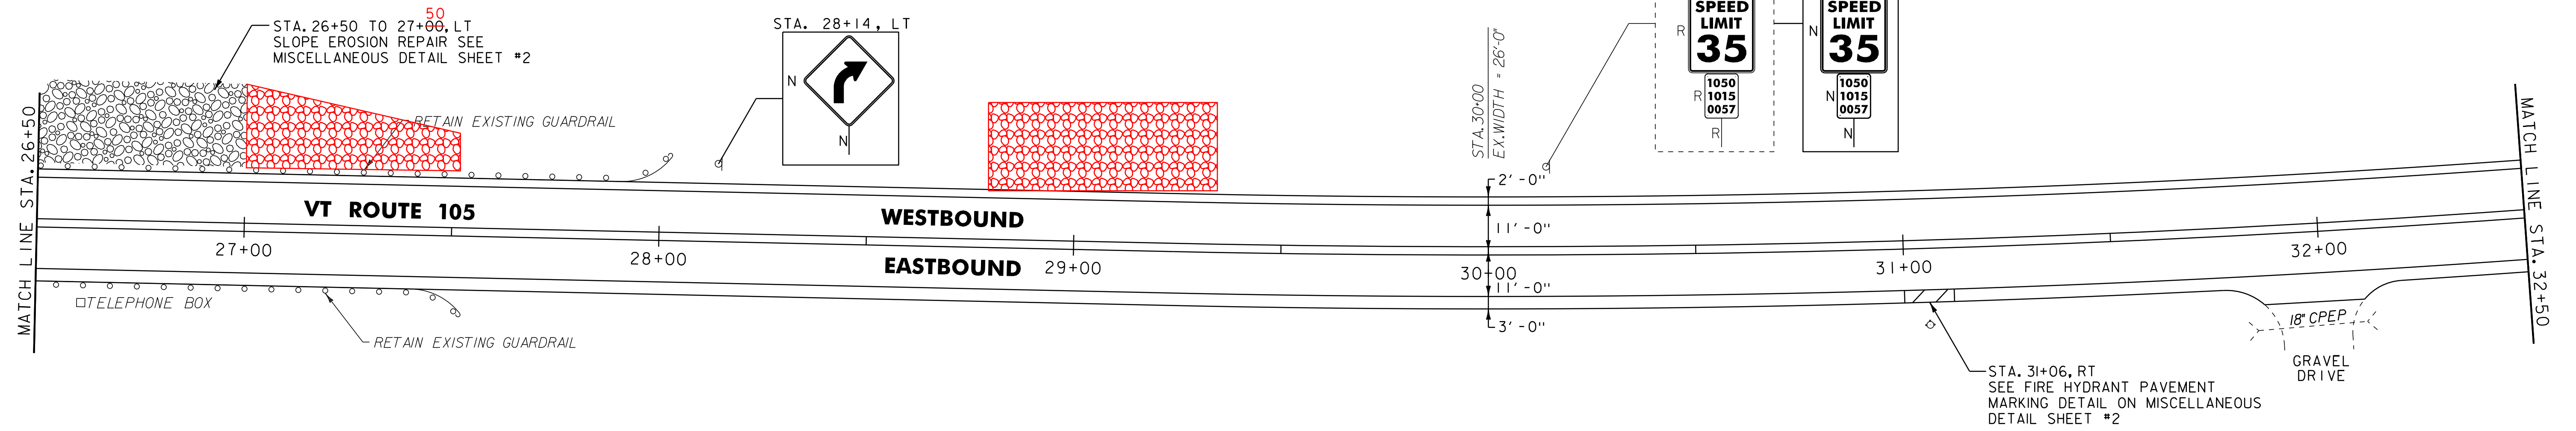

604.40 CHANGING ELEVATION OF DIs, CBs OR MHS  
 STA. 36+43, LT  
 REMOVED BY NEWPORT CITY IN 2010.

646.402 DURABLE 4 INCH WHITE LINE, THERMOPLASTIC OR  
 646.403 DURABLE 4 INCH WHITE LINE, EPOXY PAINT  
 (ALL LINES WILL INCLUDE EDGE LINE BREAKS AND  
 RADII FOR SIDE ROADS)  
 STA. 32+50 TO 38+50, SOLID LT & RT


646.412 DURABLE 4 INCH YELLOW LINE, THERMOPLASTIC OR  
 646.413 DURABLE 4 INCH YELLOW LINE, EPOXY PAINT  
 (ALL LINES WILL INCLUDE C BREAKS FOR SIDE ROADS)  
 STA. 32+50 TO 38+50, SOLID LT & RT

646.602 TEMPORARY 4 INCH WHITE LINE, PAINT  
 (ALL LINES WILL INCLUDE EDGE LINE BREAKS AND  
 RADII FOR SIDE ROADS)  
 STA. 32+50 TO 38+50, SOLID LT & RT

646.612 TEMPORARY 4 INCH YELLOW LINE, PAINT  
 (ALL LINES WILL INCLUDE C BREAKS FOR SIDE ROADS)  
 STA. 32+50 TO 38+50, SOLID LT & RT

613.10 STONE FILL, TYPE 1  
 STA. 36+58 TO 37+37 RT

613.11 STONE FILL, TYPE 11  
 STA. 35+60 TO 36+88 LT

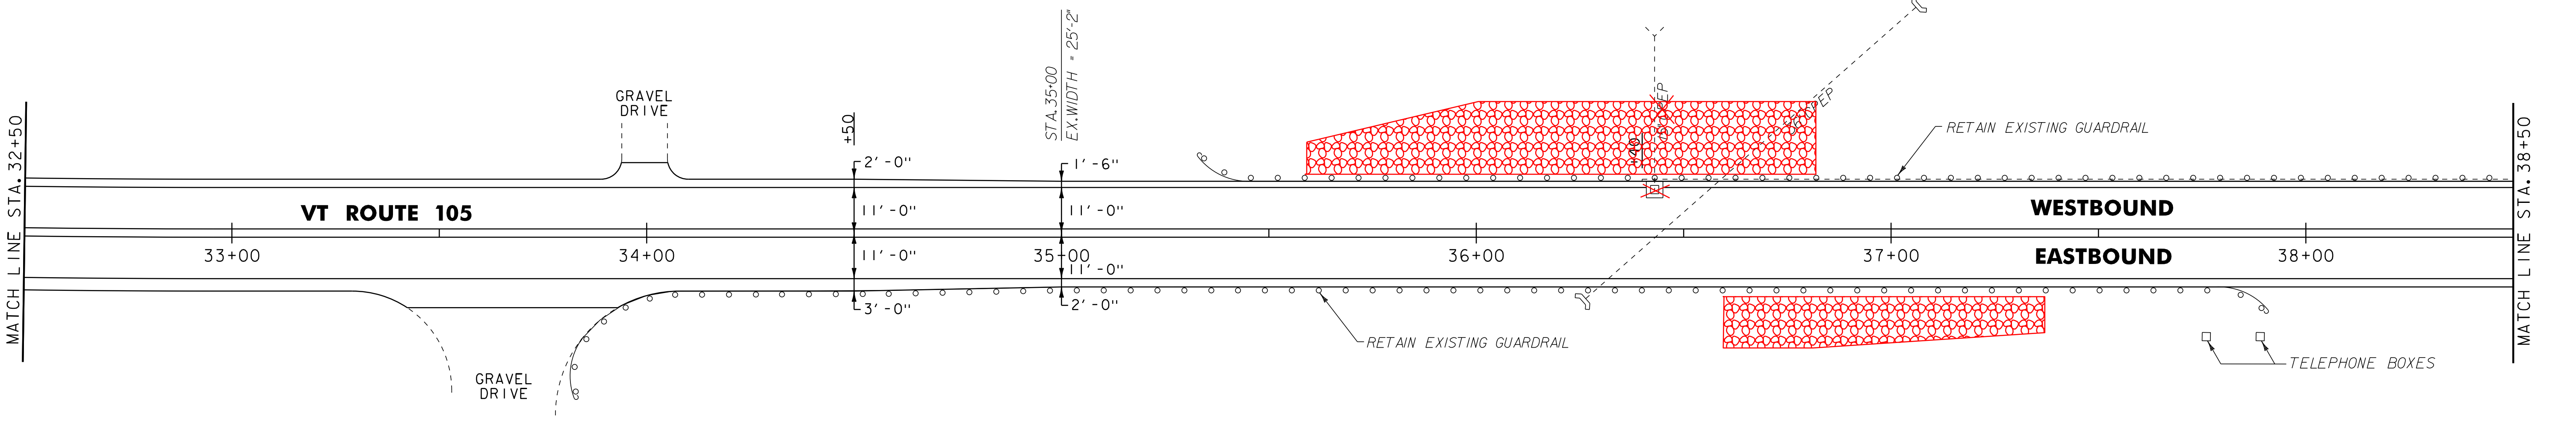

NOTE:  
 1. FOR LEGENDS, SEE LAYOUT SHEET #1.  
 2. ALL EXISTING SIGNS NOT SHOWN SHALL BE RETAINED.

NOT TO SCALE

**PROJECT LAYOUT SHEET #4**

PROJECT NAME: NEWPORT CITY	FILE NAME: p07d204.dgn	PLOT DATE: 28-NOV-2012 14:55
PROJECT NUMBER: STP 2720(1)	PROJECT LEADER: JLL	DRAWN BY: STANTEC
	DESIGNED BY: STANTEC	CHECKED BY: STANTEC
	IPARM FILE: p07d204i04.i	SHEET 12 OF 30

