


646.402 DURABLE 4 INCH WHITE LINE, THERMOPLASTIC OR  
 646.403 DURABLE 4 INCH WHITE LINE, EPOXY PAINT  
 (ALL LINES WILL INCLUDE EDGE LINE BREAKS AND  
 RADII FOR SIDE ROADS)  
 STA. 38+50 TO 44+50, SOLID LT & RT  
 646.412 DURABLE 4 INCH YELLOW LINE, THERMOPLASTIC OR  
 646.413 DURABLE 4 INCH YELLOW LINE, EPOXY PAINT  
 (ALL LINES WILL INCLUDE Q BREAKS FOR SIDE ROADS)  
 STA. 38+50 TO 44+50, SOLID LT & RT  
 646.442 DURABLE 8 INCH WHITE LINE, THERMOPLASTIC OR  
 646.443 DURABLE 8 INCH WHITE LINE, EPOXY PAINT  
 STA. 41+01 TO TO 41+13, LT

646.602 TEMPORARY 4 INCH WHITE LINE, PAINT  
 (ALL LINES WILL INCLUDE EDGE LINE BREAKS AND  
 RADII FOR SIDE ROADS)  
 STA. 38+50 TO 44+50, SOLID LT & RT  
 646.612 TEMPORARY 4 INCH YELLOW LINE, PAINT  
 (ALL LINES WILL INCLUDE Q BREAKS FOR SIDE ROADS)  
 STA. 38+50 TO 44+50, SOLID LT & RT  
 646.642 TEMPORARY 8 INCH WHITE LINE, PAINT  
 STA. 41+01 TO TO 41+13, LT

675.50 REMOVING SIGNS  
 AS SHOWN - 3  
 4

NOT INSTALLED AS HYDRANT WAS  
 CLOSER TO DRIVE THAN SHOWN.

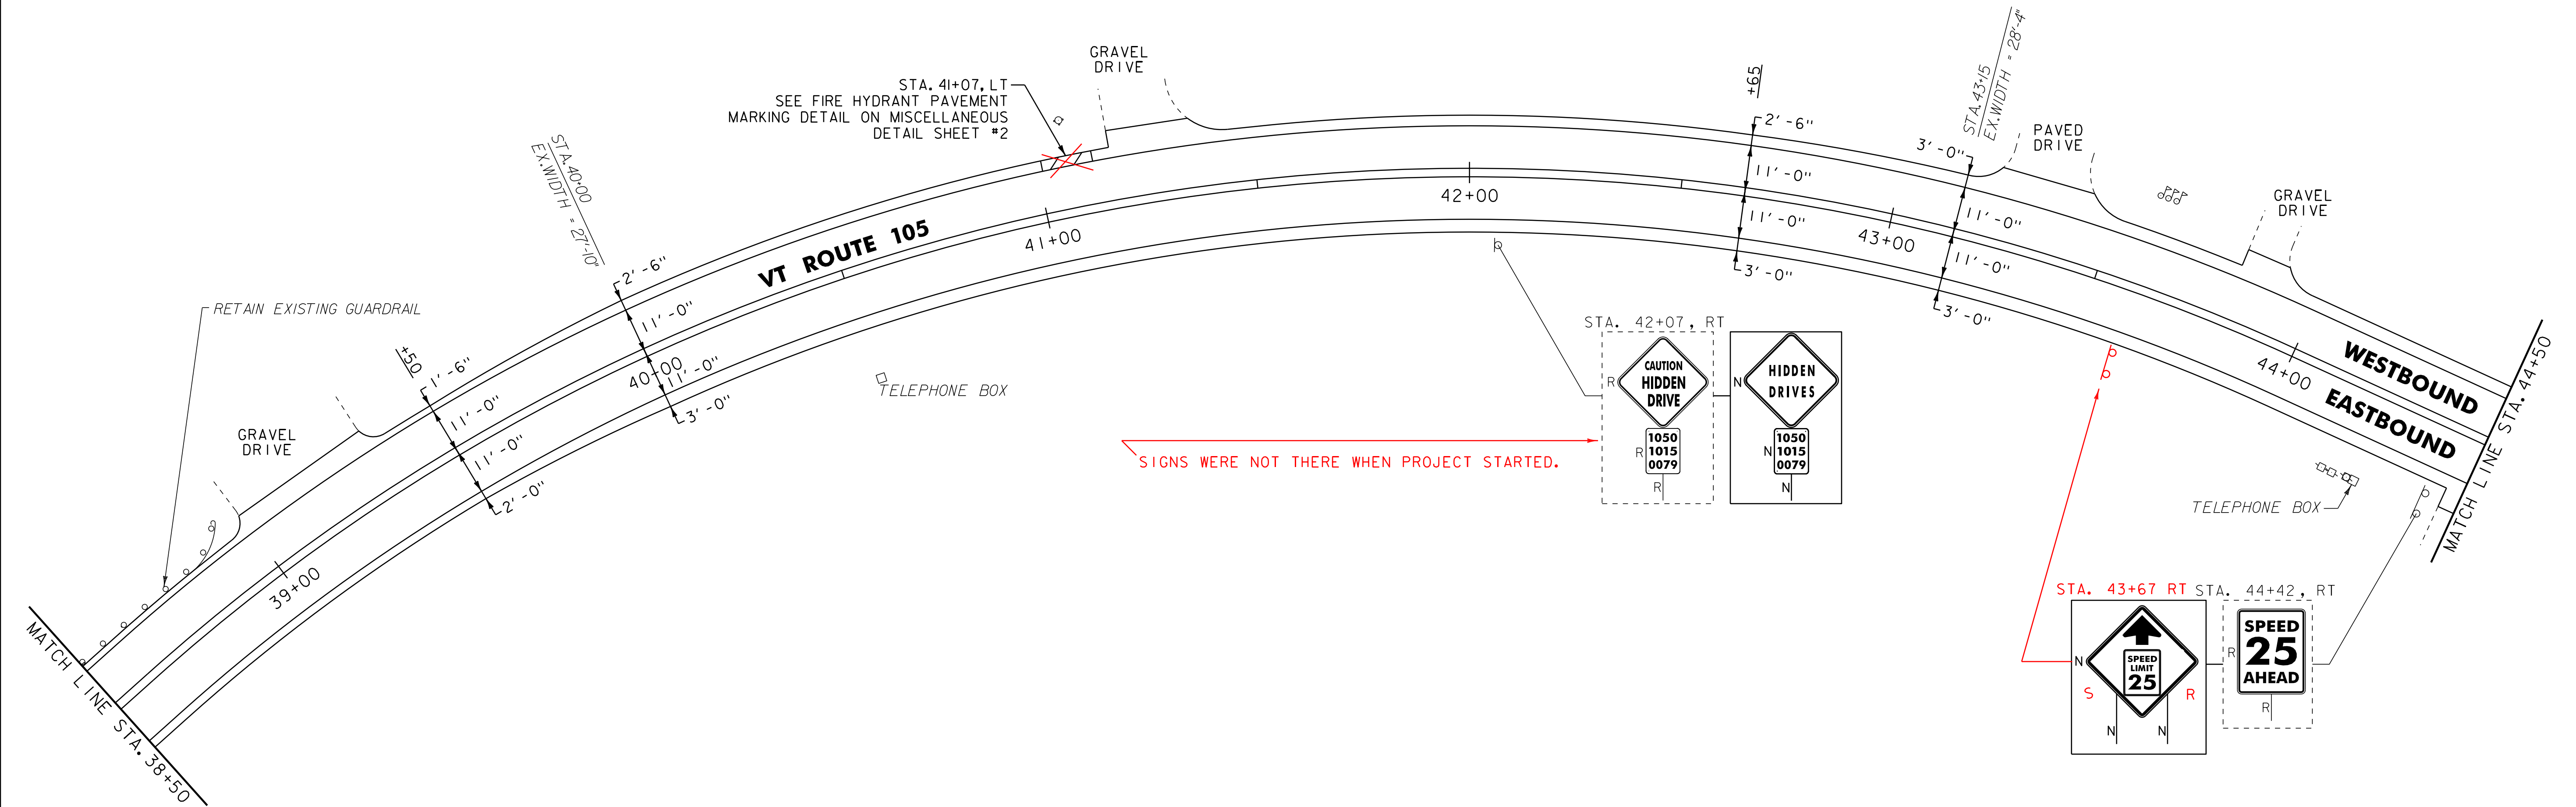

NOTE:  
 1. FOR LEGENDS, SEE LAYOUT SHEET #1.  
 2. ALL EXISTING SIGNS NOT SHOWN SHALL BE RETAINED.

<b>PROJECT LAYOUT SHEET #5</b>	<b>NOT TO SCALE</b>	
	PROJECT NAME: NEWPORT CITY	
	PROJECT NUMBER: STP 2720(1)	
	FILE NAME: p07d204.dgn	PLOT DATE: 28-NOV-2012 14:5
PROJECT LEADER: JLL	DRAWN BY: STANTEC	
DESIGNED BY: STANTEC	CHECKED BY: STANTEC	
IPARM FILE: p07d204105.i	SHEET 13 OF 30	

