

604.42 CHANGING ELEVATION OF SEWER MANHOLES

STA. 48+95, LT (WEST MAIN STREET)  
STA. 48+99, RT

646.402 DURABLE 4 INCH WHITE LINE, THERMOPLASTIC OR

646.403 DURABLE 4 INCH WHITE LINE, EPOXY PAINT

(ALL LINES WILL INCLUDE EDGE LINE BREAKS AND RADIUS FOR SIDE ROADS)

STA. 44+50 TO 50+50, SOLID LT & RT  
STA. 48+18, SOLID LT (WEST MAIN STREET)  
STA. 48+69, SOLID RT (MEMPHREMAGOG VIEWS)

616.47 BITUMINOUS CONCRETE GUTTERS AND TRAFFIC ISLANDS

STA. 45+14 TO 46+42, RT  
48+30 RT

646.412 DURABLE 4 INCH YELLOW LINE, THERMOPLASTIC OR

646.413 DURABLE 4 INCH YELLOW LINE, EPOXY PAINT

(ALL LINES WILL INCLUDE C BREAKS FOR SIDE ROADS)

STA. 44+50 TO 50+50, SOLID LT & RT  
STA. 48+18, DOUBLE SOLID LT (WEST MAIN STREET)  
STA. 48+69, DOUBLE SOLID RT (MEMPHREMAGOG VIEWS)

646.442 DURABLE 8 INCH WHITE LINE, THERMOPLASTIC OR

646.443 DURABLE 8 INCH WHITE LINE, EPOXY PAINT

STA. 45+04 TO 45+16, LT

646.482 DURABLE 24 INCH STOP BAR, THERMOPLASTIC OR

646.483 DURABLE 24 INCH STOP BAR, EPOXY PAINT

STA. 48+18, LT (WEST MAIN STREET)  
STA. 48+69, RT (MEMPHREMAGOG VIEWS)

646.492 DURABLE LETTER OR SYMBOL, THERMOPLASTIC OR

646.493 DURABLE LETTER OR SYMBOL, EPOXY PAINT

STA. 48+18, LT (WEST MAIN STREET) - "STOP"  
STA. 48+69, RT (MEMPHREMAGOG VIEWS) - "STOP"

646.602 TEMPORARY 4 INCH WHITE LINE, PAINT

(ALL LINES WILL INCLUDE EDGE LINE BREAKS AND RADIUS FOR SIDE ROADS)

STA. 44+50 TO 50+50, SOLID LT & RT  
STA. 48+18, SOLID LT (WEST MAIN STREET)  
STA. 48+69, SOLID RT (MEMPHREMAGOG VIEWS)

646.612 TEMPORARY 4 INCH YELLOW LINE, PAINT

(ALL LINES WILL INCLUDE C BREAKS FOR SIDE ROADS)

STA. 44+50 TO 50+50, SOLID LT & RT  
STA. 48+18, DOUBLE SOLID LT (WEST MAIN STREET)  
STA. 48+69, DOUBLE SOLID RT (MEMPHREMAGOG VIEWS)

646.642 TEMPORARY 8 INCH WHITE LINE, PAINT

STA. 45+04 TO 45+16, LT

646.682 TEMPORARY 24 INCH STOP BAR, PAINT

STA. 48+18, LT (WEST MAIN STREET)  
STA. 48+69, RT (MEMPHREMAGOG VIEWS)

613.10 STONE FILL, TYPE I

STA. 48+16 TO 48+28 RT  
STA. 48+81 TO 48+95 RT

646.692 TEMPORARY LETTER OR SYMBOL, PAINT

STA. 48+18, LT (WEST MAIN STREET) - "STOP"  
STA. 48+69, RT (MEMPHREMAGOG VIEWS) - "STOP"

675.50 REMOVING SIGNS


AS SHOWN - 12  
10

629.20 ADJUST ELEVATION OF VALVE BOX

STA. 45+09 RT - 1

619.17 YEILDING MARKER POSTS

STA. 49+25 LT & RT - 2

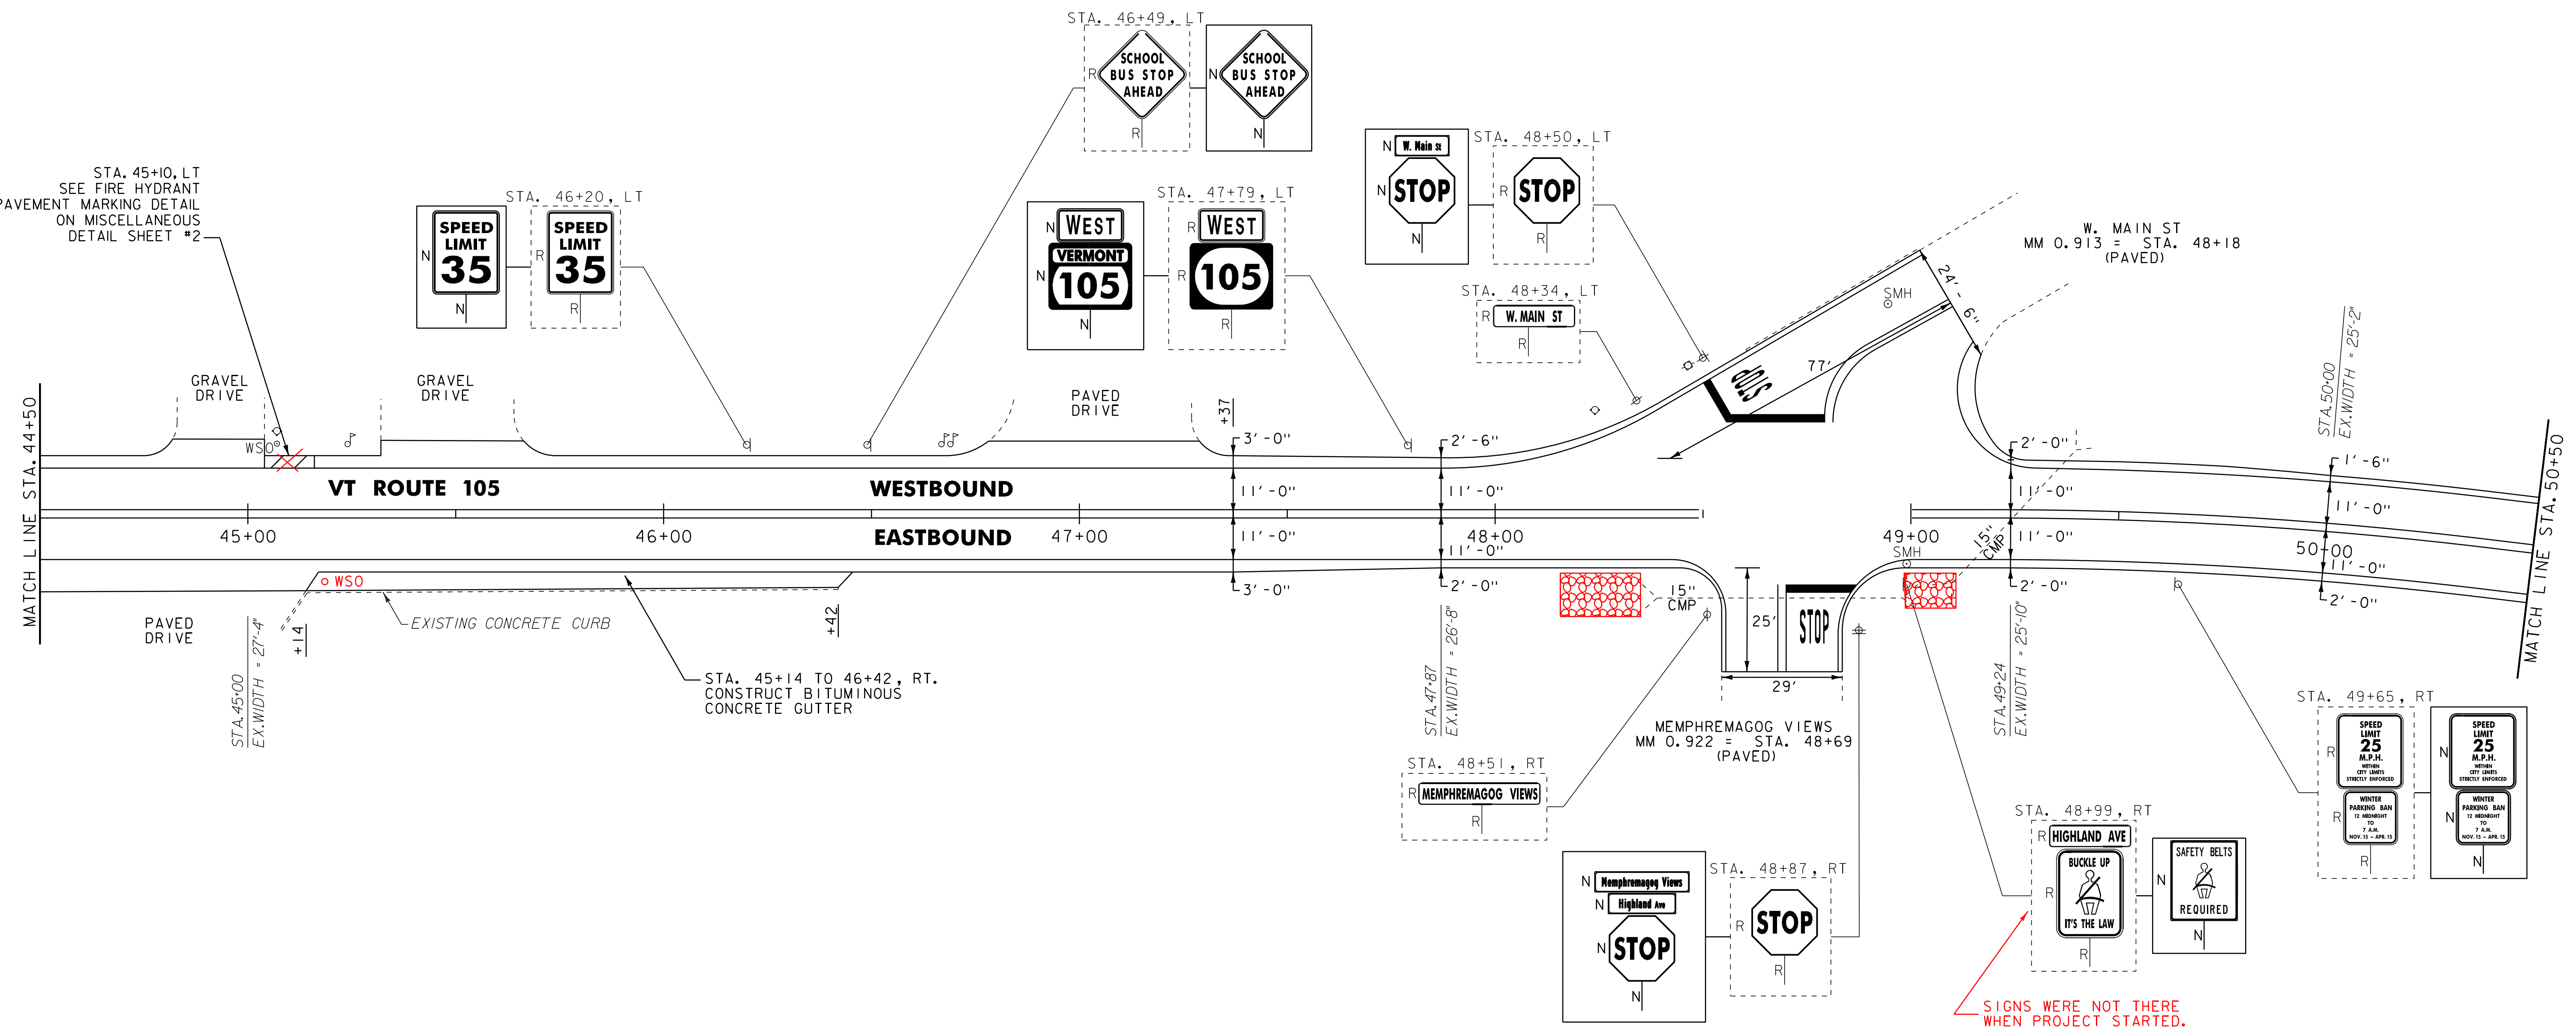

NOTE: SIGNS WERE NOT THERE WHEN PROJECT STARTED.

- NOTE:
1. FOR LEGENDS, SEE LAYOUT SHEET #1.
  2. ALL EXISTING SIGNS NOT SHOWN SHALL BE RETAINED.

**NOT TO SCALE**

**PROJECT LAYOUT SHEET #6**

PROJECT NAME: NEWPORT CITY  
PROJECT NUMBER: STP 2720(1)

FILE NAME: p07d204.dgn  
PROJECT LEADER: JLL  
DESIGNED BY: STANTEC  
**IPARM FILE: p07d204i06.i**

PLOT DATE: 28-NOV-2012 14:55  
DRAWN BY: STANTEC  
CHECKED BY: STANTEC  
SHEET 14 OF 30

