

604.40 CHANGING ELEVATION OF DIS, CBs OR MHS
STA. 54+31, RT

604.42 CHANGING ELEVATION OF SEWER MANHOLES
STA. 54+56, RT

629.20 ADJUST ELEVATION OF VALVE BOX
STA. 55+31, LT
STA. 52+80 LT
STA. 55+56 LT

646.402 DURABLE 4 INCH WHITE LINE, THERMOPLASTIC OR
646.403 DURABLE 4 INCH WHITE LINE, EPOXY PAINT
(ALL LINES WILL INCLUDE EDGE LINE BREAKS AND
RADI FOR SIDE ROADS)
STA. 50+50 TO 56+50, SOLID LT & RT

646.412 DURABLE 4 INCH YELLOW LINE, THERMOPLASTIC OR
646.413 DURABLE 4 INCH YELLOW LINE, EPOXY PAINT
(ALL LINES WILL INCLUDE C BREAKS FOR SIDE ROADS)
STA. 50+50 TO 56+50, SOLID LT & RT


646.602 TEMPORARY 4 INCH WHITE LINE, PAINT
(ALL LINES WILL INCLUDE EDGE LINE BREAKS AND
RADI FOR SIDE ROADS)
STA. 50+50 TO 56+50, SOLID LT & RT

646.612 TEMPORARY 4 INCH YELLOW LINE, PAINT
(ALL LINES WILL INCLUDE C BREAKS FOR SIDE ROADS)
STA. 50+50 TO 56+50, SOLID LT & RT

675.50 REMOVING SIGNS
AS SHOWN - I

619.17 YIELDING MARKER POSTS
STA. 54+30 LT - I
STA. 54+31 LT - I

613.10 STONE FILL, TYPE I
STA. 54+31 RT

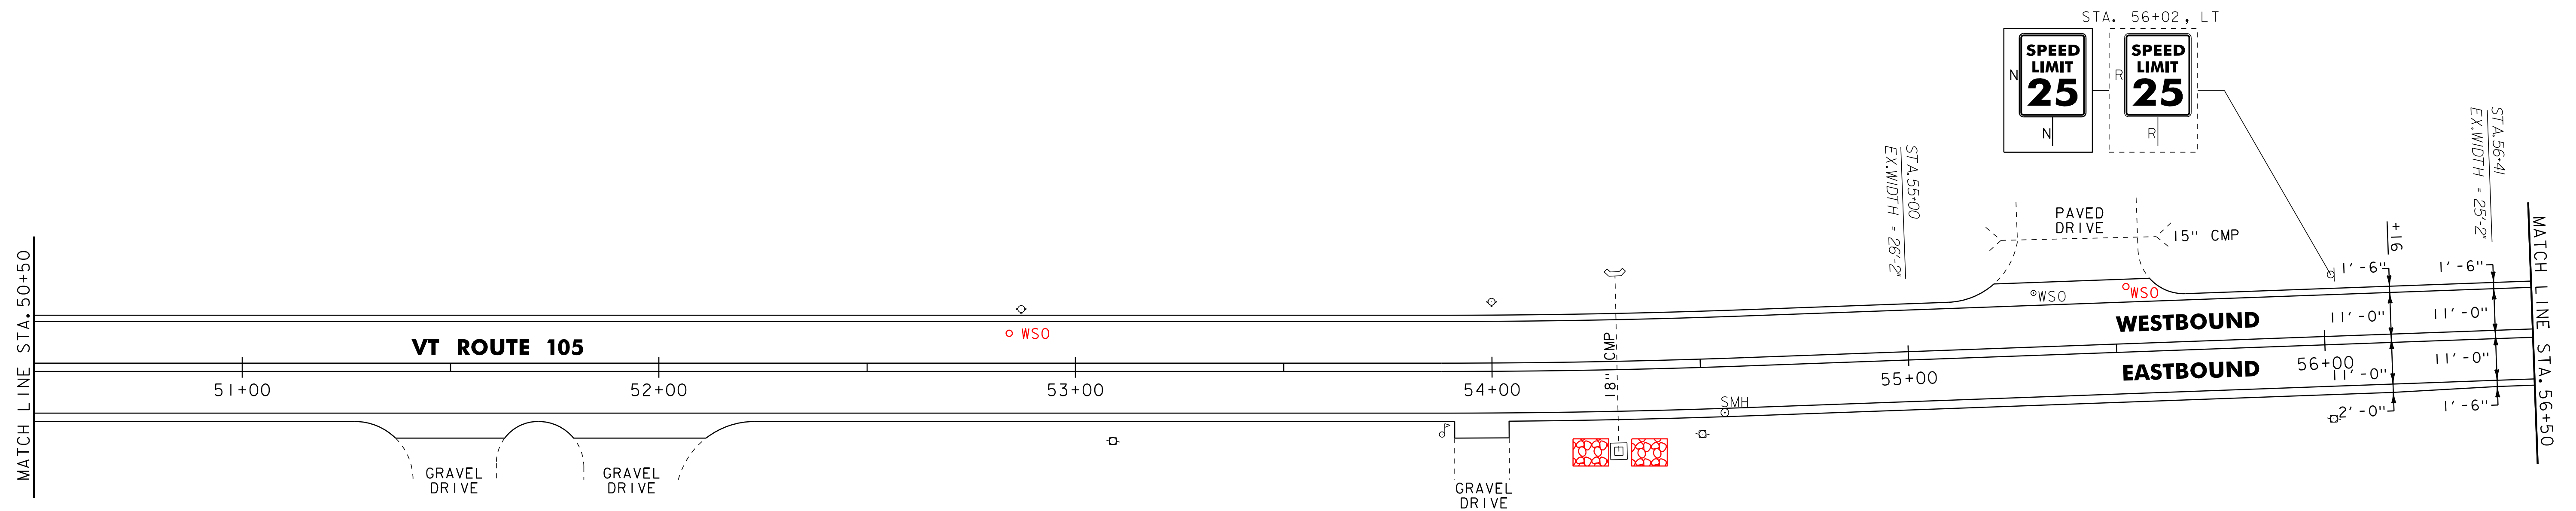

- NOTE:
- FOR LEGENDS, SEE LAYOUT SHEET #1.
 - ALL EXISTING SIGNS NOT SHOWN SHALL BE RETAINED.

NOT TO SCALE

PROJECT LAYOUT SHEET #7	PROJECT NAME: NEWPORT CITY
	PROJECT NUMBER: STP 2720(1)
	FILE NAME: p07d204.dgn
	PLOT DATE: 28-NOV-2012 14:51
PROJECT LEADER: JLL	DRAWN BY: STANTEC
DESIGNED BY: STANTEC	CHECKED BY: STANTEC
IPARM FILE: p07d204i07.i	SHEET 15 OF 30

