

604.40 CHANGING ELEVATION OF DIS, CBS OR MHS

STA. 60+29, RT (2)
 STA. 61+58, LT
 STA. 62+15, C
 STA. 62+10 RT

604.42 CHANGING ELEVATION OF SEWER MANHOLES

STA. 57+38, LT
 STA. 60+29, LT

616.40 REMOVING AND RESETTING CURB

STA. 57+68, LT
 STA. 61+58, LT
 STA. 61+93, LT

618.10 PORTLAND CEMENT CONCRETE SIDEWALK, 5 INCH

STA. 57+68, LT
 STA. 61+58, LT
 STA. 61+93, LT

618.30 DETECTABLE WARNING SURFACE

STA. 57+68, LT
 STA. 61+58, LT
 STA. 61+93, LT

629.20 ADJUST ELEVATION OF VALVE BOX

STA. 57+42, LT
 STA. 57+43, LT
 STA. 57+45, LT
 STA. 57+50, LT
 STA. 61+77, RT
 STA. 61+79, LT

646.402 DURABLE 4 INCH WHITE LINE, THERMOPLASTIC OR
 646.403 DURABLE 4 INCH WHITE LINE, EPOXY PAINT

(ALL LINES WILL INCLUDE EDGE LINE BREAKS AND
 RADII FOR SIDE ROADS)
 STA. 56+50 TO 62+50, SOLID LT & RT
 STA. 57+41, SOLID LT (LONGVIEW AVE.)

646.412 DURABLE 4 INCH YELLOW LINE, THERMOPLASTIC OR
 646.413 DURABLE 4 INCH YELLOW LINE, EPOXY PAINT

(ALL LINES WILL INCLUDE C BREAKS FOR SIDE ROADS)
 STA. 56+50 TO 62+50, SOLID LT & RT
 STA. 57+41, DOUBLE SOLID LT (LONGVIEW AVE.)

646.482 DURABLE 24 INCH STOP BAR, THERMOPLASTIC OR
 646.483 DURABLE 24 INCH STOP BAR, EPOXY PAINT

STA. 57+41, LT (LONGVIEW AVE.)

646.492 DURABLE LETTER OR SYMBOL, THERMOPLASTIC OR
 646.493 DURABLE LETTER OR SYMBOL, EPOXY PAINT

STA. 57+41, LT (LONGVIEW AVE.) - "STOP"

646.502 DURABLE CROSSWALK MARKING, THERMOPLASTIC OR
 646.503 DURABLE CROSSWALK MARKING, EPOXY PAINT

STA. 61+59 TO 61+92, LT (WEST END AVE.)

613.10 STONE FILL, TYPE J

STA. 60+29 RT

646.602 TEMPORARY 4 INCH WHITE LINE, PAINT

(ALL LINES WILL INCLUDE EDGE LINE BREAKS AND
 RADII FOR SIDE ROADS)
 STA. 56+50 TO 62+50, SOLID LT & RT
 STA. 57+41, SOLID LT (LONGVIEW AVE.)

646.612 TEMPORARY 4 INCH YELLOW LINE, PAINT

(ALL LINES WILL INCLUDE C BREAKS FOR SIDE ROADS)
 STA. 56+50 TO 62+50, SOLID LT & RT
 STA. 57+41, DOUBLE SOLID LT (LONGVIEW AVE.)

646.682 TEMPORARY 24 INCH STOP BAR, PAINT

STA. 57+41, LT (LONGVIEW AVE.)

646.692 TEMPORARY LETTER OR SYMBOL, PAINT

STA. 57+41, LT (LONGVIEW AVE.) - "STOP"

646.702 TEMPORARY CROSSWALK MARKING, PAINT


STA. 61+59 TO 61+92, LT (WEST END AVE.)

675.50 REMOVING SIGNS

AS SHOWN - 4

675.60 ERECTING SALVAGED SIGNS

STA. 61+57 LT - 1

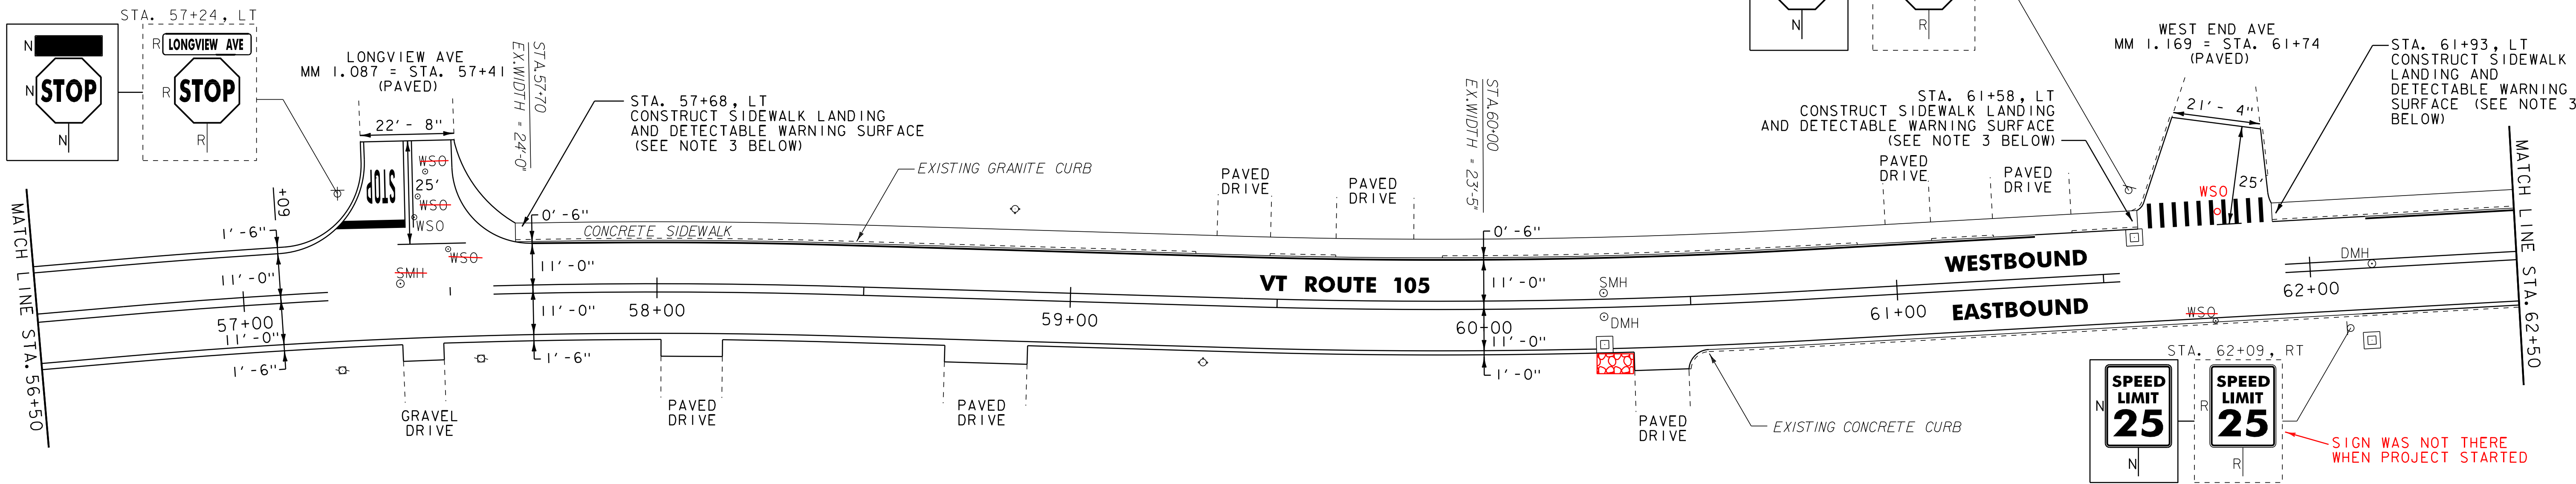

604.40 CHANGING ELEVATION OF DIS, CBS OR MHS

STA. 63+80, RT
 STA. 66+19, LT
 STA. 66+21, RT
 STA. 68+37, RT
 STA. 66+20, LT
 STA. 68+37, LT

604.42 CHANGING ELEVATION OF SEWER MANHOLES

STA. 63+86, RT
 STA. 64+12, LT
 STA. 66+27, LT

646.402 DURABLE 4 INCH WHITE LINE, THERMOPLASTIC OR
 646.403 DURABLE 4 INCH WHITE LINE, EPOXY PAINT

(ALL LINES WILL INCLUDE EDGE LINE BREAKS AND
 RADII FOR SIDE ROADS)
 STA. 62+50 TO 68+50, SOLID LT & RT

646.412 DURABLE 4 INCH YELLOW LINE, THERMOPLASTIC OR
 646.413 DURABLE 4 INCH YELLOW LINE, EPOXY PAINT

(ALL LINES WILL INCLUDE C BREAKS FOR SIDE ROADS)
 STA. 62+50 TO 68+50, SOLID LT & RT

646.602 TEMPORARY 4 INCH WHITE LINE, PAINT


(ALL LINES WILL INCLUDE EDGE LINE BREAKS AND
 RADII FOR SIDE ROADS)
 STA. 62+50 TO 68+50, SOLID LT & RT

646.612 TEMPORARY 4 INCH YELLOW LINE, PAINT

(ALL LINES WILL INCLUDE C BREAKS FOR SIDE ROADS)
 STA. 62+50 TO 68+50, SOLID LT & RT

675.50 REMOVING SIGNS

AS SHOWN - +

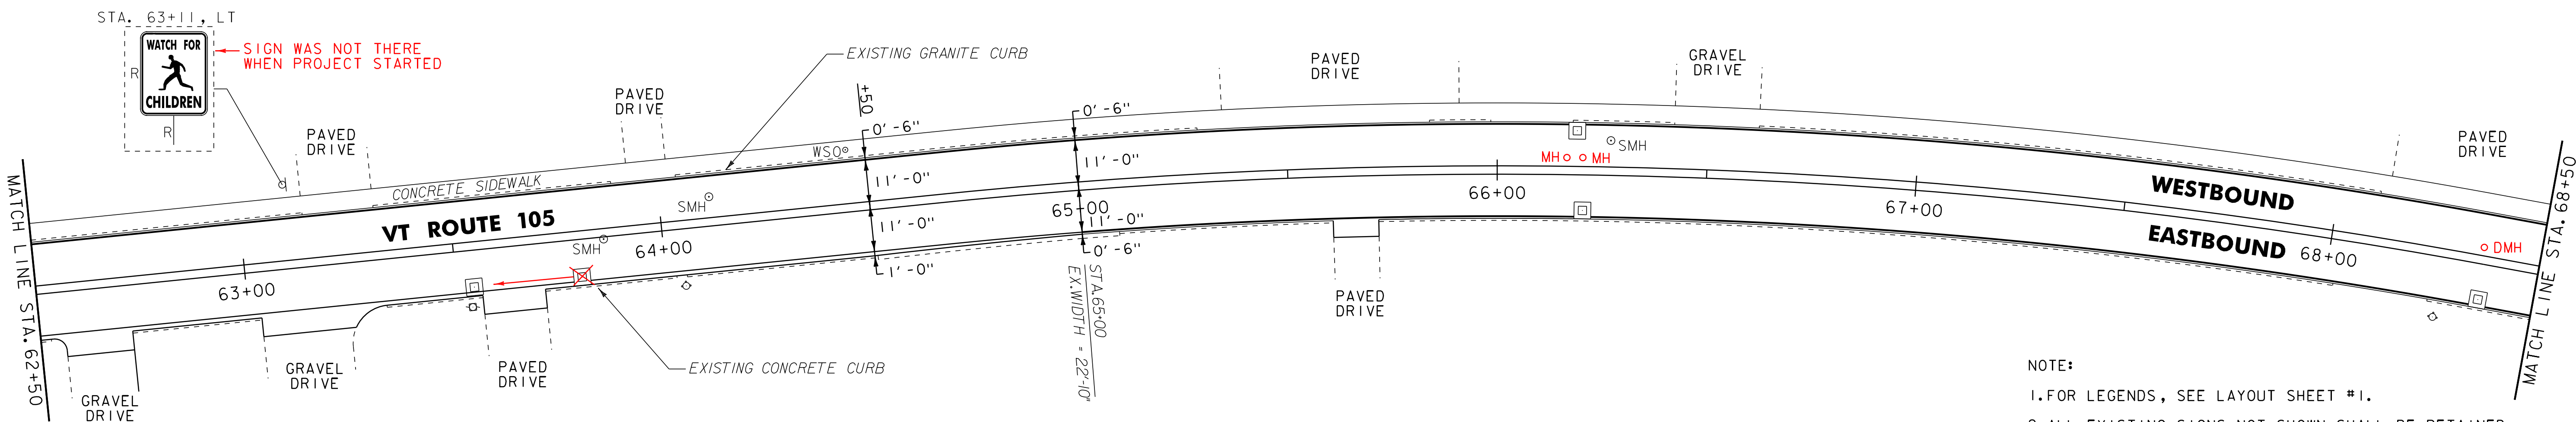

NOTE:

1. FOR LEGENDS, SEE LAYOUT SHEET #1.
2. ALL EXISTING SIGNS NOT SHOWN SHALL BE RETAINED.
3. THE SIDEWALK "LANDINGS" NOTED CONSIST OF REMOVING ONE PANEL OF EXISTING CONCRETE SIDEWALK AND REPLACING IT WITH NEW SUBBASE, CONCRETE AND DETECTABLE WARNING SURFACE.

NOT TO SCALE

PROJECT LAYOUT SHEET #8



PROJECT NAME: NEWPORT CITY

PROJECT NUMBER: STP 2720(1)

FILE NAME: p07d204.dgn

PROJECT LEADER: JLL

DESIGNED BY: STANTEC

IPARM FILE: p07d204108.i

PLOT DATE: 28-NOV-2012 14:5

DRAWN BY: STANTEC

CHECKED BY: STANTEC

SHEET 16 OF 30