

604.40 CHANGING ELEVATION OF DIS, CBs OR MHS  
 STA. 71+22, RT  
 STA. 71+31, LT

604.42 CHANGING ELEVATION OF SEWER MANHOLES

STA. 69+87, RT  
 STA. 71+19, RT  
 STA. 71+53, LT  
 STA. 73+06, LT

STA. 68+70, LT  
 629.20 ADJUST ELEVATION OF VALVE BOX

STA. 73+06, LT  
 STA. 73+06, C  
 STA. 73+06, RT

646.402 DURABLE 4 INCH WHITE LINE, THERMOPLASTIC OR  
 646.403 DURABLE 4 INCH WHITE LINE, EPOXY PAINT  
 (ALL LINES WILL INCLUDE EDGE LINE BREAKS AND  
 RADII FOR SIDE ROADS)  
 STA. 68+50 TO 73+13, SOLID LT & RT

646.412 DURABLE 4 INCH YELLOW LINE, THERMOPLASTIC OR  
 646.413 DURABLE 4 INCH YELLOW LINE, EPOXY PAINT  
 (ALL LINES WILL INCLUDE C BREAKS FOR SIDE ROADS)  
 STA. 68+50 TO 73+13, SOLID LT & RT




646.602 TEMPORARY 4 INCH WHITE LINE, PAINT  
 (ALL LINES WILL INCLUDE EDGE LINE BREAKS AND  
 RADII FOR SIDE ROADS)  
 STA. 68+50 TO 73+13, SOLID LT & RT

646.612 TEMPORARY 4 INCH YELLOW LINE, PAINT  
 (ALL LINES WILL INCLUDE C BREAKS FOR SIDE ROADS)  
 STA. 68+50 TO 73+13, SOLID LT & RT

675.50 REMOVING SIGNS  
 AS SHOWN - 21 20

675.60 ERECTING SALVAGED SIGNS  
 AS SHOWN - 1 2

**END STP 2720(1) VT ROUTE 105  
 NEWPORT CITY STA. 73+12.80 = MM 1.385**

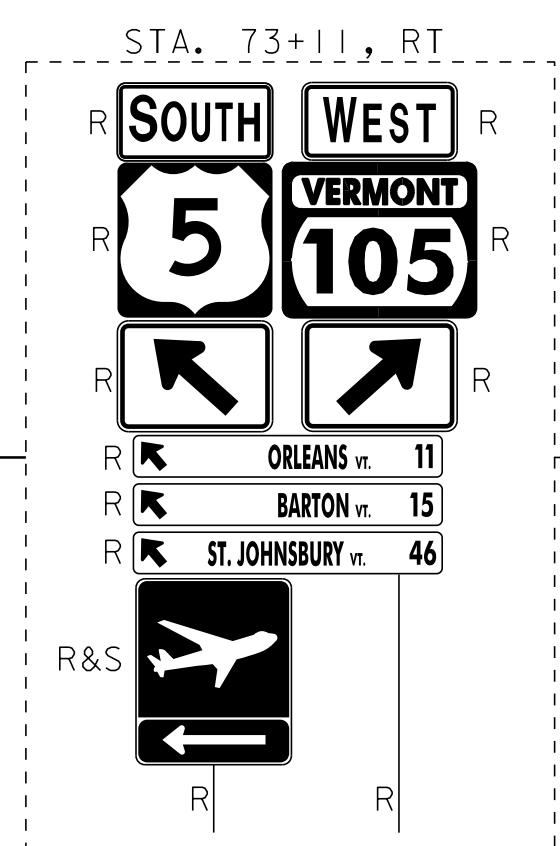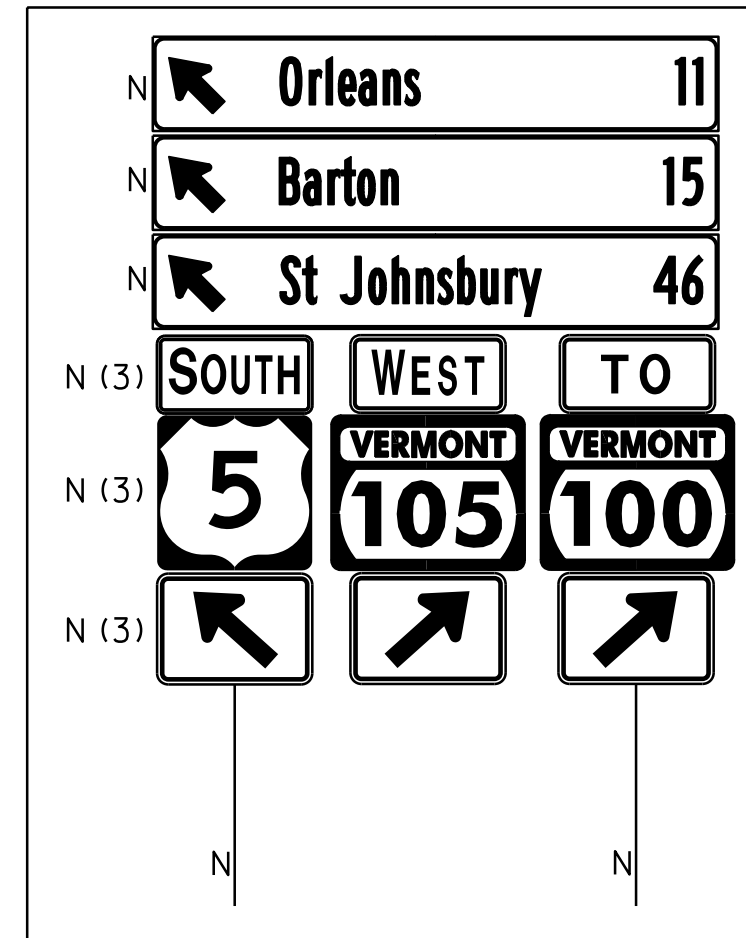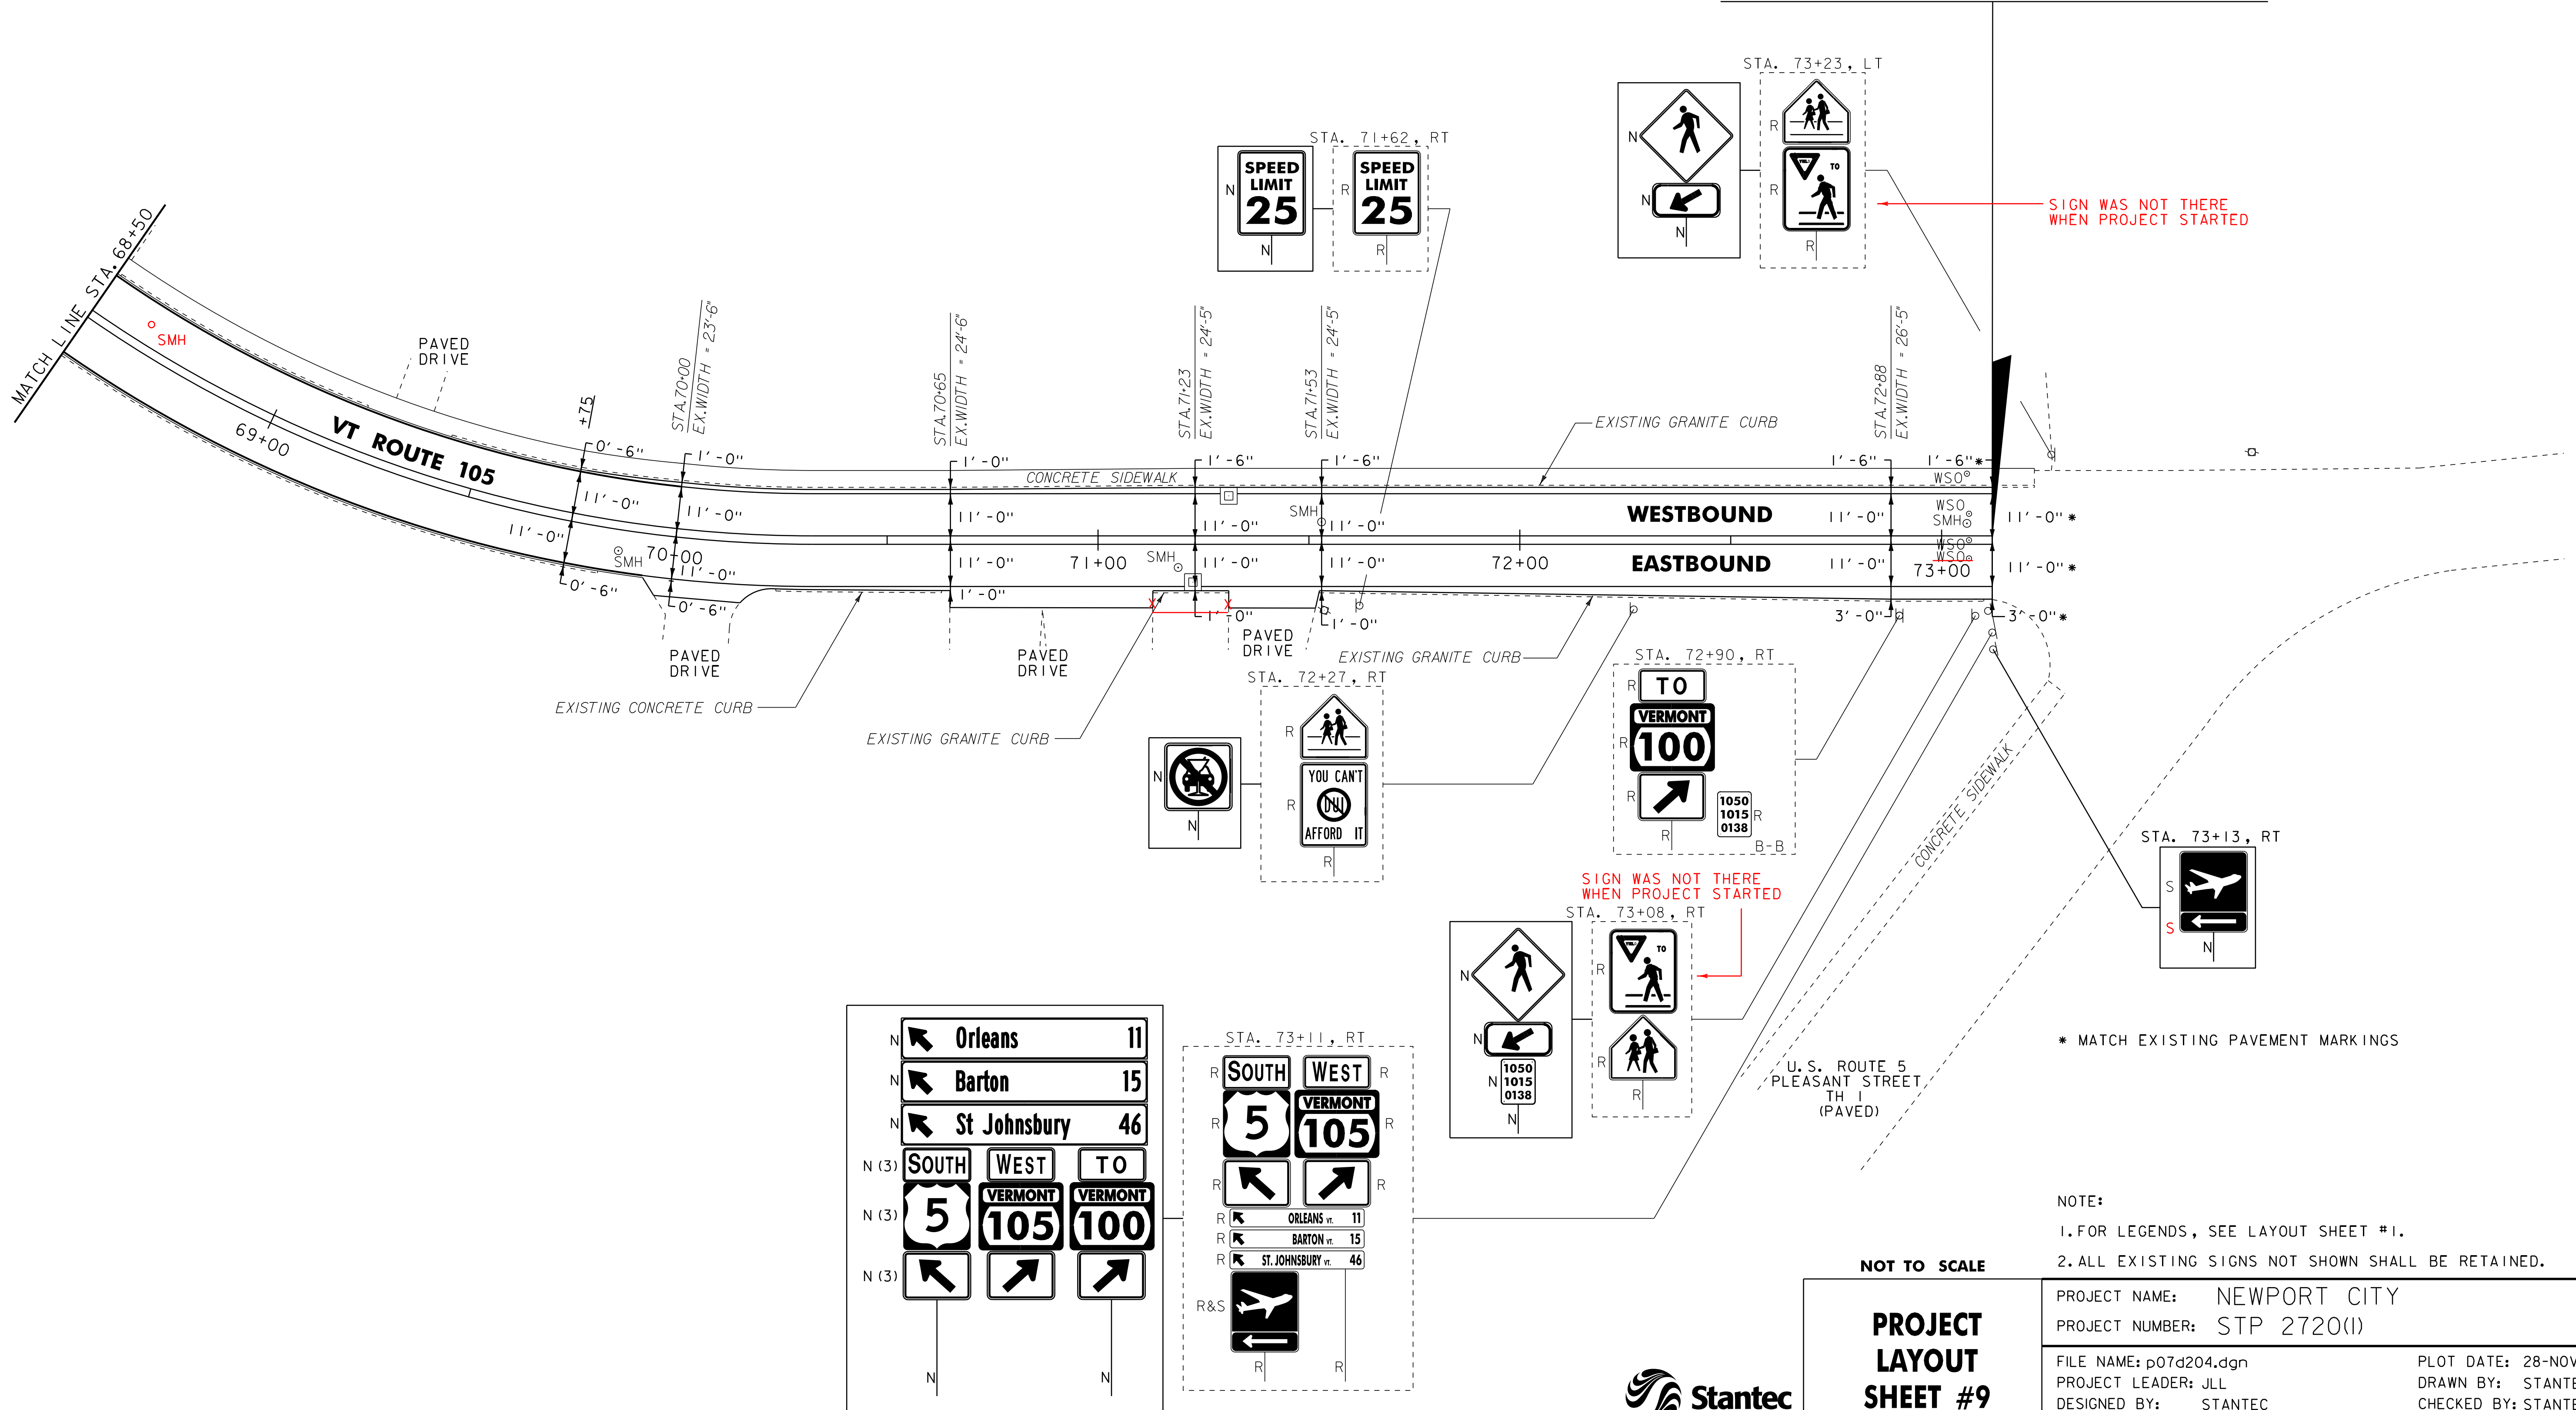

SIGN WAS NOT THERE WHEN PROJECT STARTED

SIGN WAS NOT THERE WHEN PROJECT STARTED

\* MATCH EXISTING PAVEMENT MARKINGS

NOTE:  
 1. FOR LEGENDS, SEE LAYOUT SHEET #1.  
 2. ALL EXISTING SIGNS NOT SHOWN SHALL BE RETAINED.

NOT TO SCALE

**PROJECT LAYOUT SHEET #9**



PROJECT NAME: NEWPORT CITY	PLOT DATE: 28-NOV-2012 14:5
PROJECT NUMBER: STP 2720(1)	DRAWN BY: STANTEC
FILE NAME: p07d204.dgn	CHECKED BY: STANTEC
DESIGNED BY: STANTEC	SHEET 17 OF 30
IPARM FILE: p07d204i09.i	