

203.16 SOLID ROCK EXCAVATION

STA. 25+73 - STA. 25+77 LT
 STA. 26+07 - STA. 26+13 LT
 STA. 26+18 - STA. 26+23 LT
 STA. 26+48 - STA. 26+53 RT
 STA. 26+81 - STA. 26+86 RT

604.412, 604.415, 604.418 REHAB. DROP INLETS, CATCH BASINS, OR MANHOLES, CLASS I, CLASS II OR CLASS III

STA. 25+75 LT "TYPE D GRATE"
 STA. 26+44 RT "TYPE D GRATE"
 STA. 26+79 RT "TYPE D GRATE"
 STA. 27+01 RT "TYPE D GRATE"

604.42 CHANGING ELEVATION OF SEWER MANHOLES

STA. 26+77 RT

618.10 PORTLAND CEMENT CONCRETE SIDEWALK, 5 INCH

STA. 25+73 - STA. 25+77 LT
 STA. 26+07 - STA. 26+13 LT
 STA. 26+18 - STA. 26+23 LT
 STA. 26+48 - STA. 26+53 RT
 STA. 26+81 - STA. 26+86 RT

618.30 DETECTABLE WARNING SURFACE

STA. 25+75 LT STA. 26+50 RT
 STA. 26+10 LT STA. 26+83 RT
 STA. 26+20 LT

629.20 ADJUST ELEVATION OF VALVE BOX

STA. 25+43 LT (WSV) STA. 26+01 LT (WSV)
 STA. 25+48 LT (WSV) STA. 26+26 LT (WSV)
 STA. 25+54 LT (WSV) STA. 26+79 RT (GSV)
 STA. 25+91 LT (WSV) STA. 26+83 RT (GSV)

646.406 DURABLE 4" WHITE LINE, RECESSED POLYUREA

STA. 24+06.57 - STA. 28+50 (DASHED LT)
 STA. 24+06.57 - STA. 28+50 (DASHED RT)

646.416 DURABLE 4" YELLOW LINE, RECESSED POLYUREA

STA. 24+06.57 - STA. 25+72 (SOLID LT & RT)
 STA. 25+92 LT (CENTERLINE LYMAN AVE.)
 STA. 26+12 - STA. 26+47 (SOLID LT & RT)
 STA. 26+64 RT (CENTERLINE WHITE PL.)
 STA. 26+87 - STA. 28+50 (SOLID LT & RT)

646.486 DURABLE 24" STOP BAR, RECESSED POLYUREA

STA. 25+77 - STA. 25+92 LT
 STA. 26+64 - STA. 26+81 RT

646.491 DURABLE LETTER OR SYMBOL, TYPE I TAPE

STA. 25+85 LT "STOP"
 STA. 26+72 RT "STOP"

646.501 DURABLE CROSSWALK MARKING, TYPE I TAPE

STA. 25+77 - STA. 26+07 LT
 STA. 26+53 - STA. 26+81 RT

646.602 TEMPORARY 4" WHITE LINE, PAINT

STA. 24+06.57 - STA. 28+50 (DASHED LT)
 STA. 24+06.57 - STA. 28+50 (DASHED RT)

646.612 TEMPORARY 4" YELLOW LINE, PAINT

STA. 24+06.57 - STA. 25+72 (SOLID LT & RT)
 STA. 25+92 LT (CENTERLINE LYMAN AVE.)
 STA. 26+12 - STA. 26+47 (SOLID LT & RT)
 STA. 26+64 RT (CENTERLINE WHITE PL.)
 STA. 26+87 - STA. 28+50 (SOLID LT & RT)

646.682 TEMPORARY 24" STOP BAR, PAINT

STA. 25+77 - STA. 25+92 LT
 STA. 26+64 - STA. 26+81 RT

646.692 TEMPORARY LETTER OR SYMBOL, PAINT

STA. 25+85 LT "STOP"
 STA. 26+72 RT "STOP"

646.702 TEMPORARY CROSSWALK MARKING, PAINT


STA. 25+77 - STA. 26+07 LT
 STA. 26+53 - STA. 26+81 RT

675.50 REMOVING SIGNS

AS SHOWN - 4

675.60 ERECTING SALVAGED SIGNS

AS SHOWN - 2

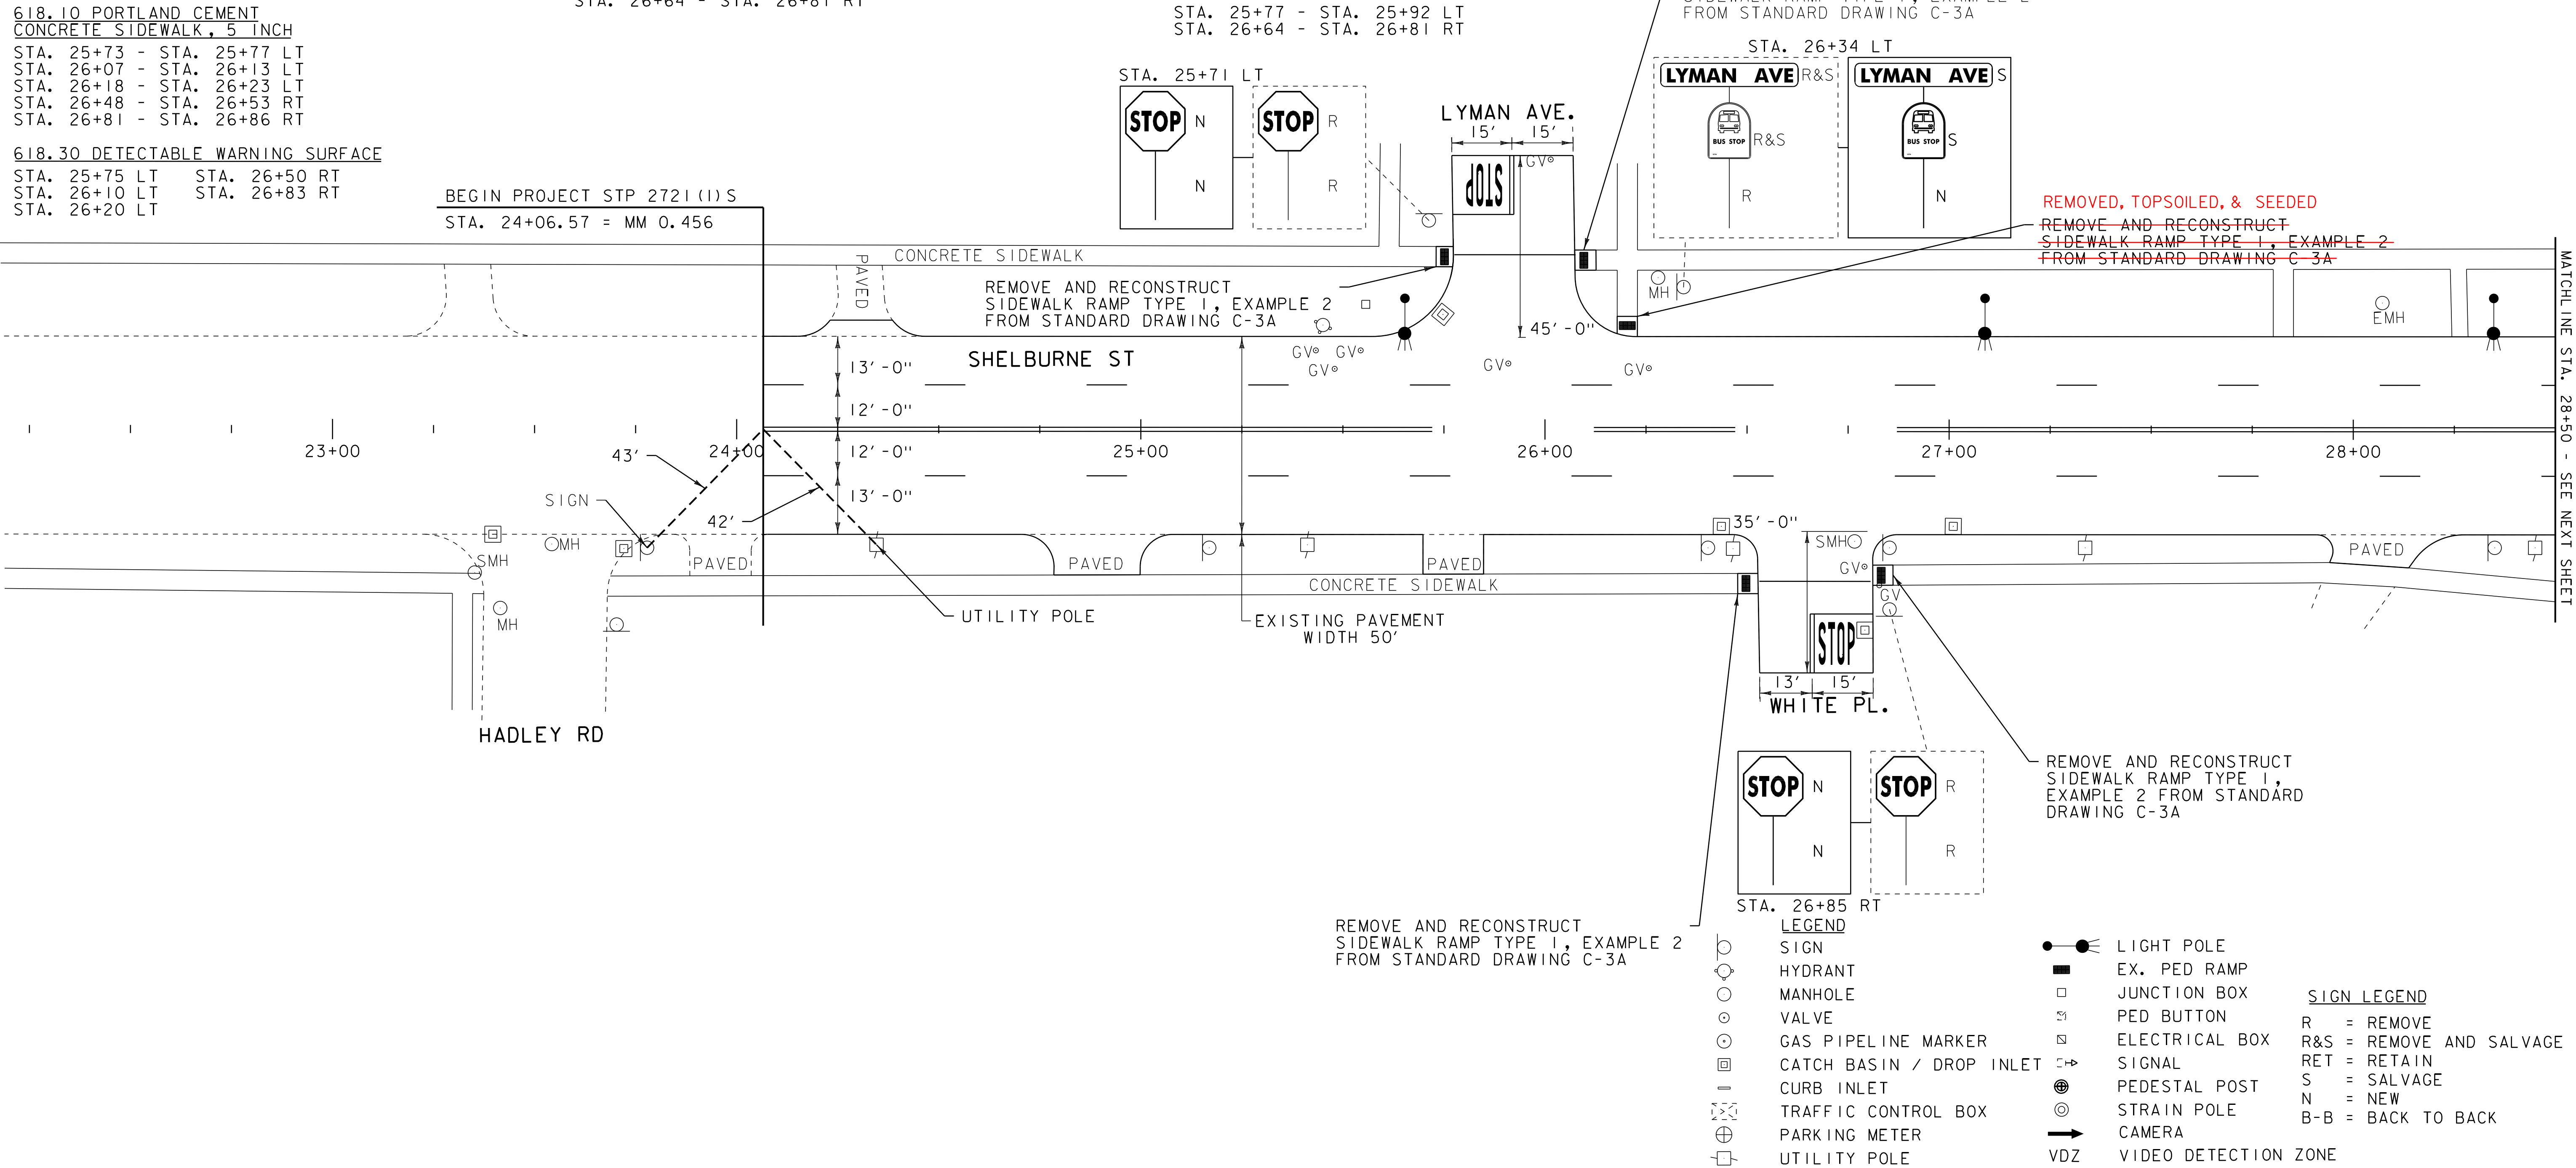

REMOVE AND RECONSTRUCT SIDEWALK RAMP TYPE 1, EXAMPLE 2 FROM STANDARD DRAWING C-3A

REMOVED, TOPSOILED, & SEED
 REMOVE AND RECONSTRUCT SIDEWALK RAMP TYPE 1, EXAMPLE 2 FROM STANDARD DRAWING C-3A

REMOVE AND RECONSTRUCT SIDEWALK RAMP TYPE 1, EXAMPLE 2 FROM STANDARD DRAWING C-3A

- LEGEND**
- SIGN
 - HYDRANT
 - MANHOLE
 - VALVE
 - GAS PIPELINE MARKER
 - CATCH BASIN / DROP INLET
 - CURB INLET
 - ⊗ TRAFFIC CONTROL BOX
 - ⊕ PARKING METER
 - UTILITY POLE
 - LIGHT POLE
 - EX. PED RAMP
 - JUNCTION BOX
 - ⊞ PED BUTTON
 - ⊞ ELECTRICAL BOX
 - ⊞ SIGNAL
 - ⊞ PEDESTAL POST
 - ⊞ STRAIN POLE
 - ⊞ CAMERA
 - VDZ VIDEO DETECTION ZONE
- SIGN LEGEND**
- R = REMOVE
 - R&S = REMOVE AND SALVAGE
 - RET = RETAIN
 - S = SALVAGE
 - N = NEW
 - B-B = BACK TO BACK

PROJECT LAYOUT SHEET 1

PROJECT NAME: BURLINGTON (CLASS I)	PLOT DATE: 18-APR-2014 13:51
PROJECT NUMBER: STP 2721(I)	DRAWN BY: BMB
FILE NAME: 07d206.dgn	CHECKED BY: EPD
PROJECT LEADER: CDL	SHEET 17 OF 70
DESIGNED BY: BMB	
PLOT FILE: 07d206_17.1	

NOT TO SCALE

MATCHLINE STA. 28+50 - SEE NEXT SHEET