

604.40 CHANGING ELEVATION OF DROP  
INLETS, CATCH BASINS, OR MANHOLES  
STA. 38+11 RT DMH STA. 40+50 LT TMH  
604.412, 604.415, 604.418 REHAB, DROP  
INLETS, CATCH BASINS, OR MANHOLES, CLASS I,  
CLASS II OR CLASS III  
STA. 35+13 RT "TYPE D GRATE"  
STA. 37+79 RT "TYPE D GRATE"

629.20 ADJUST ELEVATION OF VALVE BOX  
STA. 34+93 RT (WSV) STA. 38+11 RT (WSV)  
STA. 36+45 RT (WSV) STA. 38+22 RT (GSV)  
STA. 36+69 RT (WSV) STA. 39+11 LT (WSV)  
STA. 37+50 RT (WSV) STA. 39+95 CL (WSV)

646.406 DURABLE 4" WHITE LINE, RECESSED POLYUREA  
STA. 34+75 - STA. 40+75 (DASHED LT & RT)  
STA. 34+75 - STA. 35+50 (SOLID LT)  
STA. 35+50 - STA. 36+45 (DOTTED LT)

646.416 DURABLE 4" YELLOW LINE, RECESSED POLYUREA  
STA. 34+75 - STA. 40+75 (CENTERLINE LT & RT)  
STA. 35+67 - STA. 37+13 (CENTERLINE RT)

646.456 DURABLE 8" YELLOW LINE, RECESSED POLYUREA  
STA. 35+74 - STA. 37+03 (HATCHED LT & RT)

646.491 DURABLE LETTER OR SYMBOL, TYPE I TAPE  
STA. 34+93 RT "ONLY"  
STA. 35+47 RT LEFT ARROW


646.602 TEMPORARY 4" WHITE LINE, PAINT  
STA. 34+75 - STA. 40+75 (DASHED LT & RT)  
STA. 34+75 - STA. 35+50 (SOLID LT)  
STA. 35+50 - STA. 36+45 (DOTTED LT)

646.612 TEMPORARY 4" YELLOW LINE, PAINT  
STA. 34+75 - STA. 40+75 (CENTERLINE LT & RT)  
STA. 35+67 - STA. 37+13 (CENTERLINE RT)

646.652 TEMPORARY 8" YELLOW LINE, PAINT  
STA. 35+74 - STA. 37+03 (HATCHED LT & RT)

646.692 TEMPORARY LETTER OR SYMBOL, PAINT  
STA. 34+93 RT "ONLY"  
STA. 35+47 RT LEFT ARROW

675.50 REMOVING SIGNS  
AS SHOWN - 2

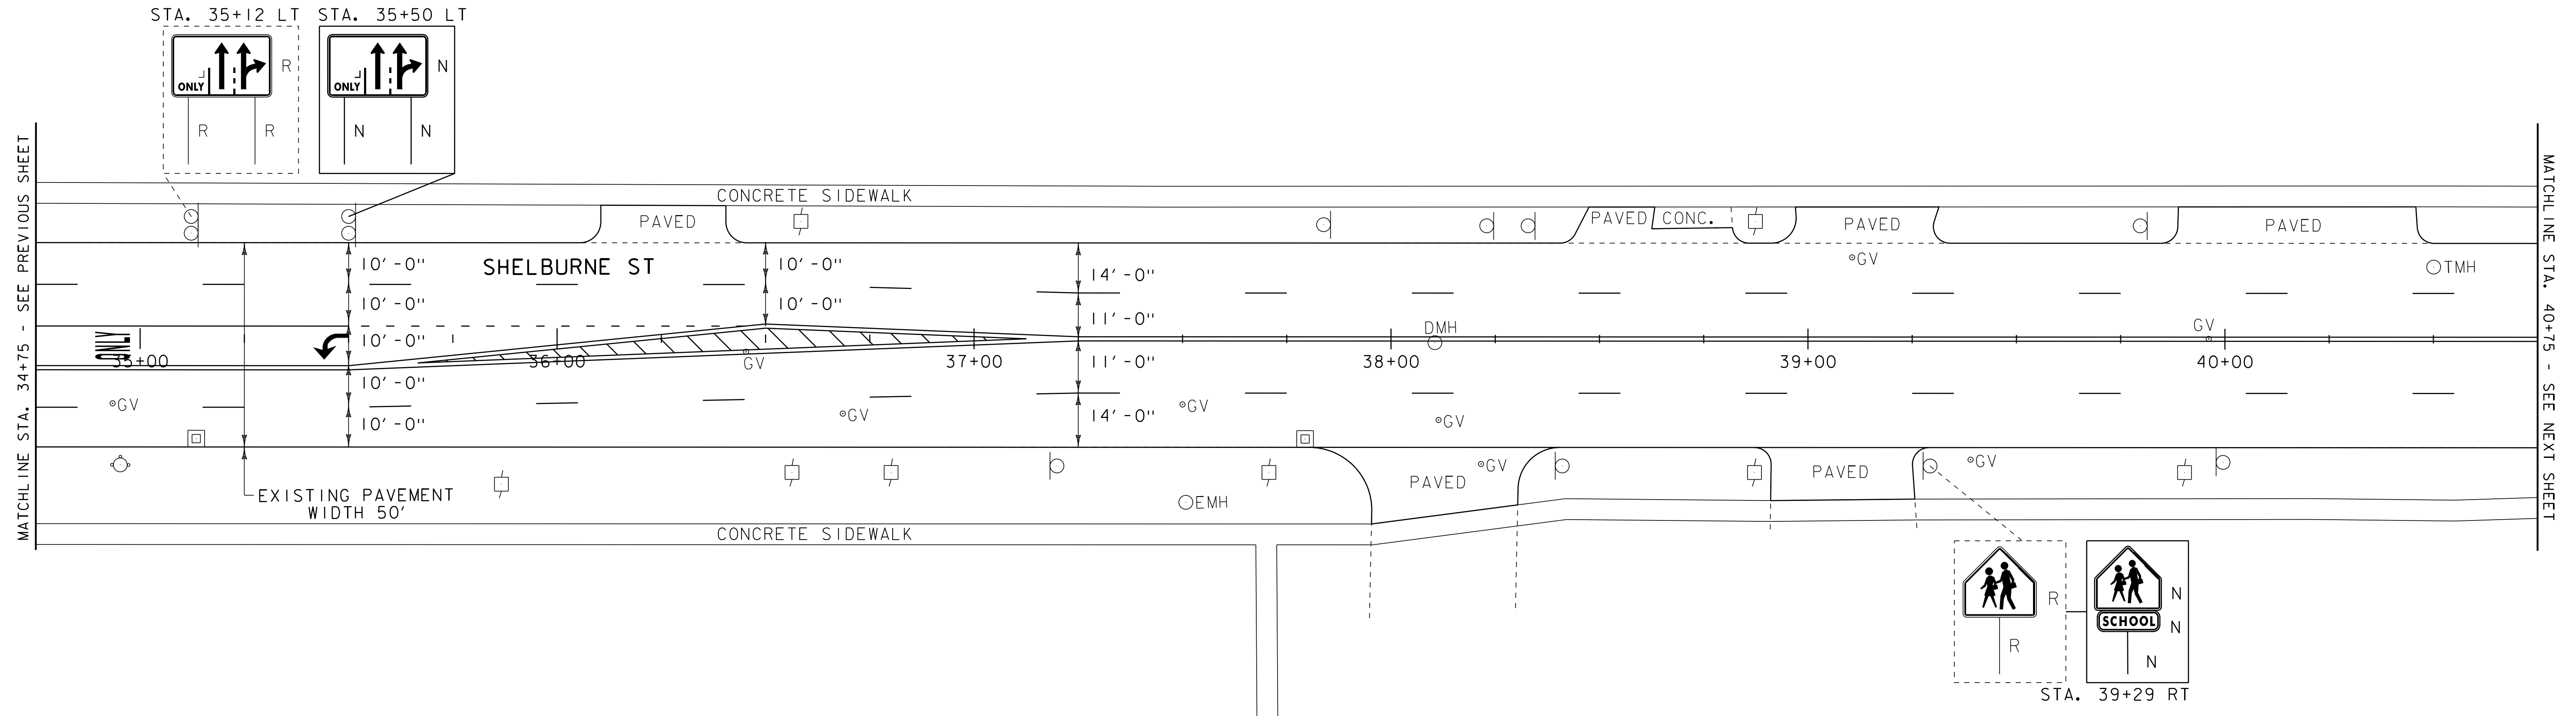

<ul style="list-style-type: none"> <li>○ SIGN</li> <li>○ HYDRANT</li> <li>○ MANHOLE</li> <li>○ VALVE</li> <li>○ GAS PIPELINE MARKER</li> <li>□ CATCH BASIN / DROP INLET</li> <li>□ CURB INLET</li> <li>□ TRAFFIC CONTROL BOX</li> <li>⊕ PARKING METER</li> <li>□ UTILITY POLE</li> </ul>	<ul style="list-style-type: none"> <li>● LIGHT POLE</li> <li>■ EX. PED RAMP</li> <li>□ JUNCTION BOX</li> <li>⊞ PED BUTTON</li> <li>⊞ ELECTRICAL BOX</li> <li>□ SIGNAL</li> <li>⊕ PEDESTAL POST</li> <li>⊙ STRAIN POLE</li> <li>→ CAMERA</li> <li>VDZ VIDEO DETECTION ZONE</li> </ul>	<p><b>SIGN LEGEND</b></p> <ul style="list-style-type: none"> <li>R = REMOVE</li> <li>R&amp;S = REMOVE AND SALVAGE</li> <li>RET = RETAIN</li> <li>S = SALVAGE</li> <li>N = NEW</li> <li>B-B = BACK TO BACK</li> </ul>
--	--	--

**PROJECT LAYOUT SHEET 3**

PROJECT NAME: BURLINGTON (CLASS I)  
PROJECT NUMBER: STP 2721(I)  
FILE NAME: 07d206.dgn  
PROJECT LEADER: CDL  
DESIGNED BY: BMB  
PLOT FILE: 07d206\_19.1  
PLOT DATE: 18-APR-2014 13:51  
DRAWN BY: BMB  
CHECKED BY: EPD  
SHEET 19 OF 70

NOT TO SCALE