

**203.16 SOLID ROCK EXCAVATION**

STA. 54+22 - STA. 54+27 RT  
 STA. 54+54 - STA. 54+59 RT  
 STA. 57+47 - STA. 57+52 RT  
 STA. 57+79 - STA. 57+85 RT

**604.40 CHANGING ELEVATION OF DROP INLETS, CATCH BASINS, OR MANHOLES**

STA. 54+22 RT (DMH)  
 STA. 54+47 RT (DMH)  
 STA. 54+48 RT (DMH)

**604.42 CHANGING ELEVATION OF SEWER MANHOLES**

STA. 53+70 RT STA. 57+40 RT  
 STA. 54+39 RT STA. 57+52 RT

**604.412, 604.415, 604.418 REHAB, DROP**

**INLETS, CATCH BASINS, OR MANHOLES, CLASS I, CLASS II OR CLASS III**

STA. 54+10 RT "TYPE D GRATE"  
 STA. 54+26 RT "TYPE D GRATE"  
 STA. 54+55 RT "TYPE D GRATE"  
 STA. 54+67 RT "TYPE D GRATE"  
 STA. 54+69 LT "TYPE D GRATE"  
 STA. 57+36 RT "TYPE D GRATE"  
 STA. 57+75 LT "TYPE D GRATE"  
 STA. 57+93 RT "TYPE D GRATE"

**618.10 PORTLAND CEMENT CONCRETE SIDEWALK, 5 INCH**

STA. 54+22 - STA. 54+27 RT  
 STA. 54+54 - STA. 54+59 RT  
 STA. 57+47 - STA. 57+52 RT  
 STA. 57+79 - STA. 57+85 RT

**618.30 DETECTABLE WARNING SURFACE**

STA. 54+25 RT STA. 57+50 RT  
 STA. 54+57 RT STA. 57+82 RT

**629.20 ADJUST ELEVATION OF VALVE BOX**

STA. 54+25 RT (WSV) STA. 54+59 RT (WSV)  
 STA. 54+31 RT (GSV) STA. 57+57 RT (WSV)  
 STA. 54+32 RT (WSV)

**646.406 DURABLE 4" WHITE LINE, RECESSED POLYUREA**

STA. 52+75 - STA. 59+25 (DASHED LT & RT)

**646.416 DURABLE 4" YELLOW LINE, RECESSED POLYUREA**

STA. 52+75 - STA. 54+21 (SOLID LT & RT)  
 STA. 54+61 - STA. 57+46 (SOLID LT & RT)  
 STA. 57+86 - STA. 59+25 (SOLID LT & RT)

**646.486 DURABLE 24" STOP BAR, RECESSED POLYUREA**

STA. 54+40 - STA. 54+54 RT  
 STA. 57+67 - STA. 57+79 RT

**646.491 DURABLE LETTER OR SYMBOL, TYPE I TAPE**

STA. 54+47 RT "STOP"  
 STA. 57+73 RT "STOP"

**646.501 DURABLE CROSSWALK MARKING, TYPE I TAPE**

STA. 54+28 - STA. 54+53 RT  
 STA. 57+53 - STA. 57+79 RT

**646.602 TEMPORARY 4" WHITE LINE, PAINT**

STA. 52+75 - STA. 59+25 (DASHED LT & RT)

**646.612 TEMPORARY 4" YELLOW LINE, PAINT**

STA. 52+75 - STA. 54+21 (SOLID LT & RT)  
 STA. 54+61 - STA. 57+46 (SOLID LT & RT)  
 STA. 57+86 - STA. 59+25 (SOLID LT & RT)

**646.682 TEMPORARY 24" STOP BAR, PAINT**

STA. 54+40 - STA. 54+54 RT  
 STA. 57+67 - STA. 57+79 RT

**646.692 TEMPORARY LETTER OR SYMBOL, PAINT**

STA. 54+47 RT "STOP"  
 STA. 57+73 RT "STOP"

**646.702 TEMPORARY CROSSWALK MARKING, PAINT**

STA. 54+28 - STA. 54+53 RT  
 STA. 57+53 - STA. 57+79 RT

**675.50 REMOVING SIGNS**


AS SHOWN - 5

**675.60 ERECTING SALVAGED SIGNS**

AS SHOWN - 2

MATCHLINE STA. 52+75 - SEE PREVIOUS SHEET

MATCHLINE STA. 59+25 - SEE NEXT SHEET

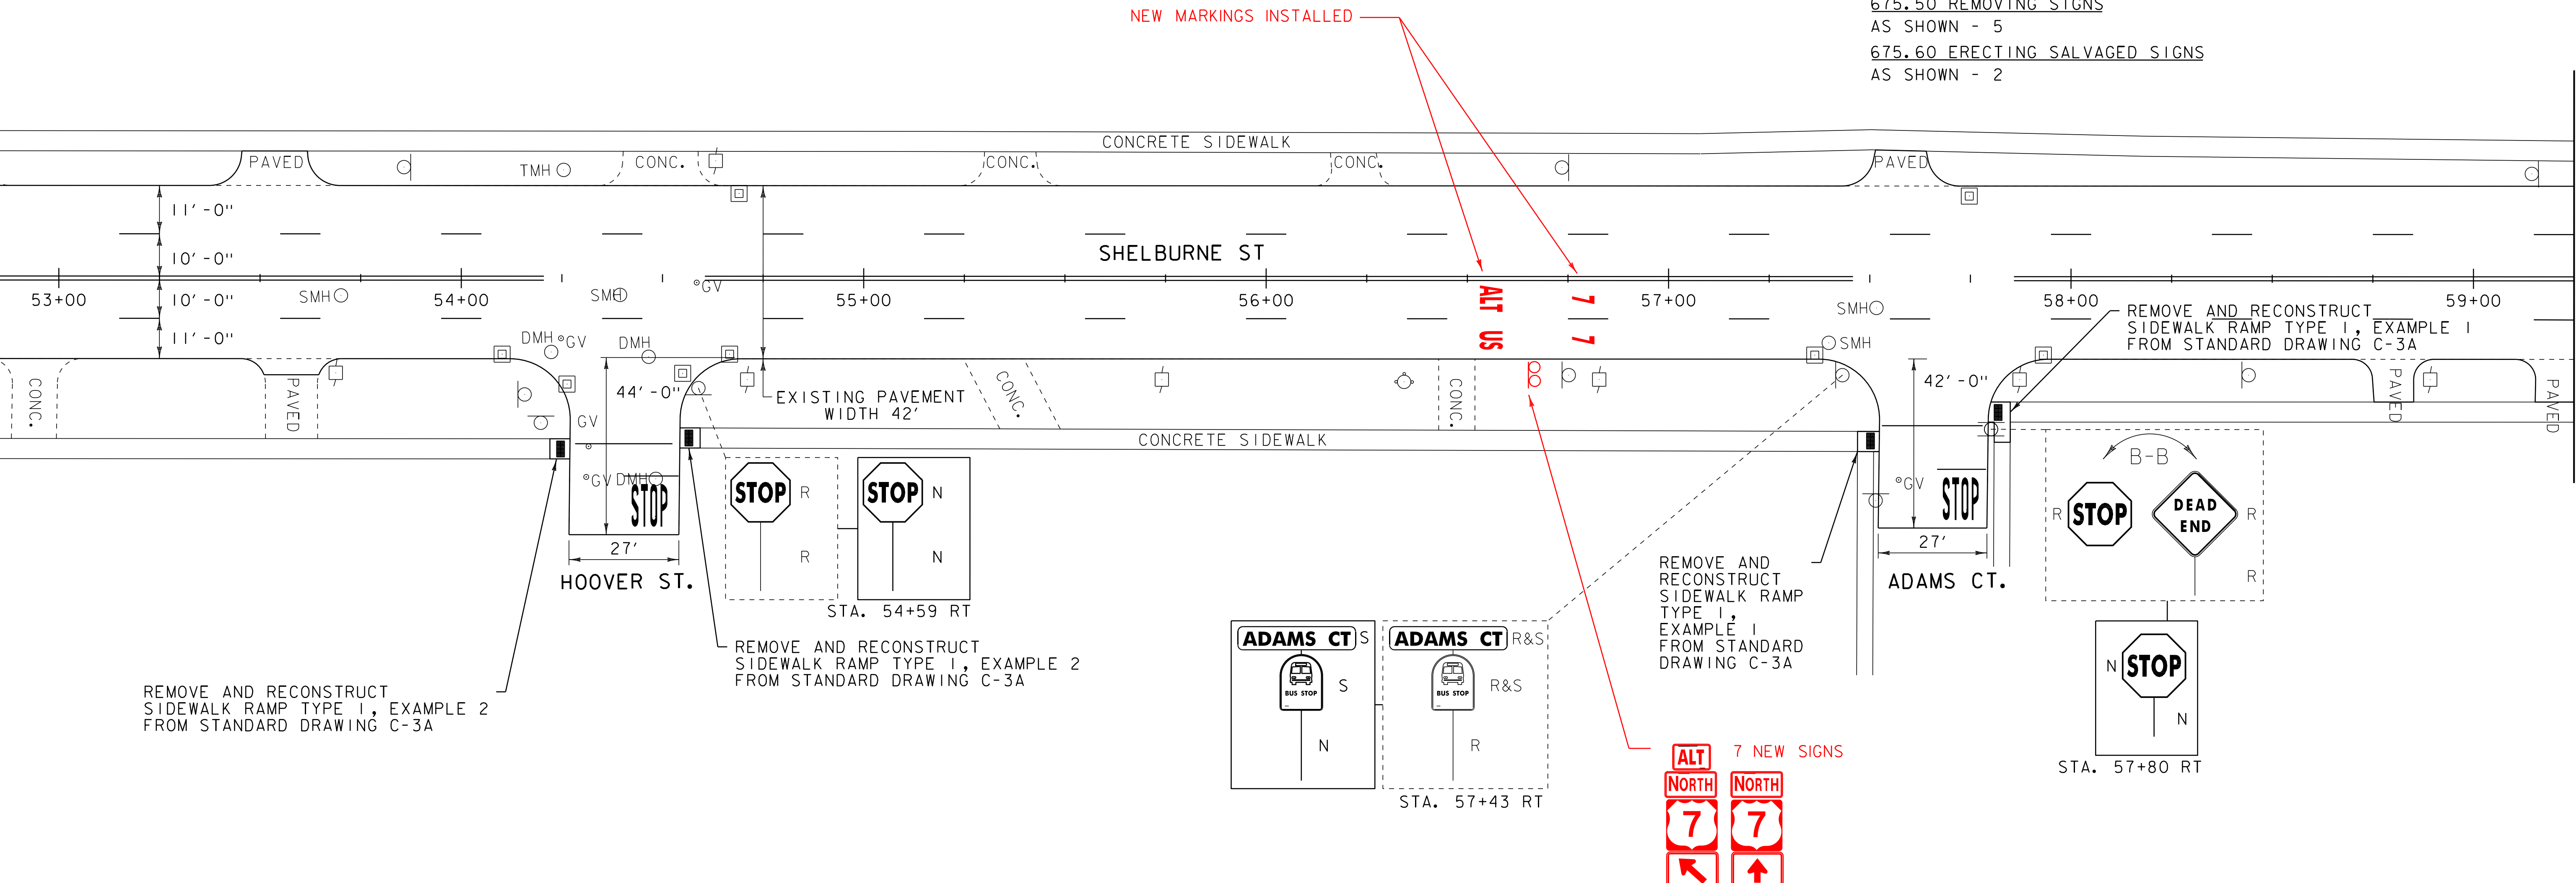

**LEGEND**

- SIGN
- HYDRANT
- MANHOLE
- VALVE
- GAS PIPELINE MARKER
- CATCH BASIN / DROP INLET
- CURB INLET
- ⊠ TRAFFIC CONTROL BOX
- ⊕ PARKING METER
- UTILITY POLE

- LIGHT POLE
- EX. PED RAMP
- JUNCTION BOX
- ⊠ PED BUTTON
- ⊠ ELECTRICAL BOX
- ⊠ SIGNAL
- ⊠ PEDESTAL POST
- ⊠ STRAIN POLE
- CAMERA
- VDZ VIDEO DETECTION ZONE

**SIGN LEGEND**

- R = REMOVE
- R&S = REMOVE AND SALVAGE
- RET = RETAIN
- S = SALVAGE
- N = NEW
- B-B = BACK TO BACK

NOT TO SCALE

**PROJECT LAYOUT SHEET 6**

PROJECT NAME: BURLINGTON (CLASS I)  
 PROJECT NUMBER: STP 2721(I)

FILE NAME: 07d206.dgn  
 PROJECT LEADER: CDL  
 DESIGNED BY: BMB  
 PLOT FILE: 07d206\_22.i

PLOT DATE: 18-APR-2014 13:51  
 DRAWN BY: BMB  
 CHECKED BY: EPD  
 SHEET 22 OF 70