

203.16 SOLID ROCK EXCAVATION

STA. 79+19 - STA. 79+26 LT
 STA. 79+60 - STA. 79+68 LT

604.42 CHANGING ELEVATION OF SEWER MANHOLE

STA. 79+52 LT (SMH)

604.412, 604.415, 604.418 REHAB, DROP INLETS, CATCH BASINS, OR MANHOLES, CLASS I, CLASS II OR CLASS III

STA. 79+86 RT "TYPE D GRATE"
 STA. 79+88 LT "TYPE D GRATE"

618.10 PORTLAND CEMENT CONCRETE SIDEWALK, 5 INCH

STA. 79+19 - STA. 79+26 LT
 STA. 79+60 - STA. 79+68 LT

618.30 DETECTABLE WARNING SURFACE

STA. 79+24 LT STA. 79+63 LT

629.20 ADJUST ELEVATION OF VALVE BOX

STA. 79+32 RT (WSV) STA. 79+51 LT (WSV)
 STA. 79+50 LT (WSV) STA. 79+76 RT (WSV)

646.406 DURABLE 4" WHITE LINE, RECESSED POLYUREA

STA. 77+25 - STA. 83+25 (SOLID RT)
 STA. 77+25 - STA. 79+16 (SOLID LT)
 STA. 79+70 - STA. 83+25 (SOLID LT)

646.416 DURABLE 4" YELLOW LINE, RECESSED POLYUREA

STA. 77+25 - STA. 79+33 (SOLID LT & RT)
 STA. 79+40 LT (CENTERLINE HOWARD ST.)
 STA. 79+73 - STA. 83+25 (SOLID LT & RT)

646.446 DURABLE 8" WHITE LINE, RECESSED POLYUREA

STA. 78+71 (SOLID LT)
 STA. 78+71 - STA. 79+11 (HATCHED LT)
 STA. 79+76 - STA. 80+57 (HATCHED LT)
 STA. 80+57 (SOLID LT)

646.486 DURABLE 24" STOP BAR, RECESSED POLYUREA

STA. 79+25 - STA. 79+43 LT

646.491 DURABLE LETTER OR SYMBOL, TYPE I TAPE

STA. 79+31 LT "STOP"

900.640 SPECIAL PROVISION (DURABLE CROSSWALK MARKING, IMPRINTED/COLORIZED)

STA. 79+26 - STA. 79+60 LT

646.602 TEMPORARY 4" WHITE LINE, PAINT

STA. 77+25 - STA. 83+25 (SOLID RT)
 STA. 77+25 - STA. 79+16 (SOLID LT)
 STA. 79+70 - STA. 83+25 (SOLID LT)

646.612 TEMPORARY 4" YELLOW LINE, PAINT

STA. 77+25 - STA. 79+33 (SOLID LT & RT)
 STA. 79+40 LT (CENTERLINE HOWARD ST.)
 STA. 79+73 - STA. 83+25 (SOLID LT & RT)

646.642 TEMPORARY 8" WHITE LINE, PAINT

STA. 78+71 (SOLID LT)
 STA. 78+71 - STA. 79+11 (HATCHED LT)
 STA. 79+76 - STA. 80+57 (HATCHED LT)
 STA. 80+57 (SOLID LT)

646.682 TEMPORARY 24" STOP BAR, PAINT


STA. 79+25 - STA. 79+43 LT

646.692 TEMPORARY LETTER OR SYMBOL, PAINT

STA. 79+31 LT "STOP"

646.702 TEMPORARY CROSSWALK MARKING, PAINT

STA. 79+26 - STA. 79+60 LT

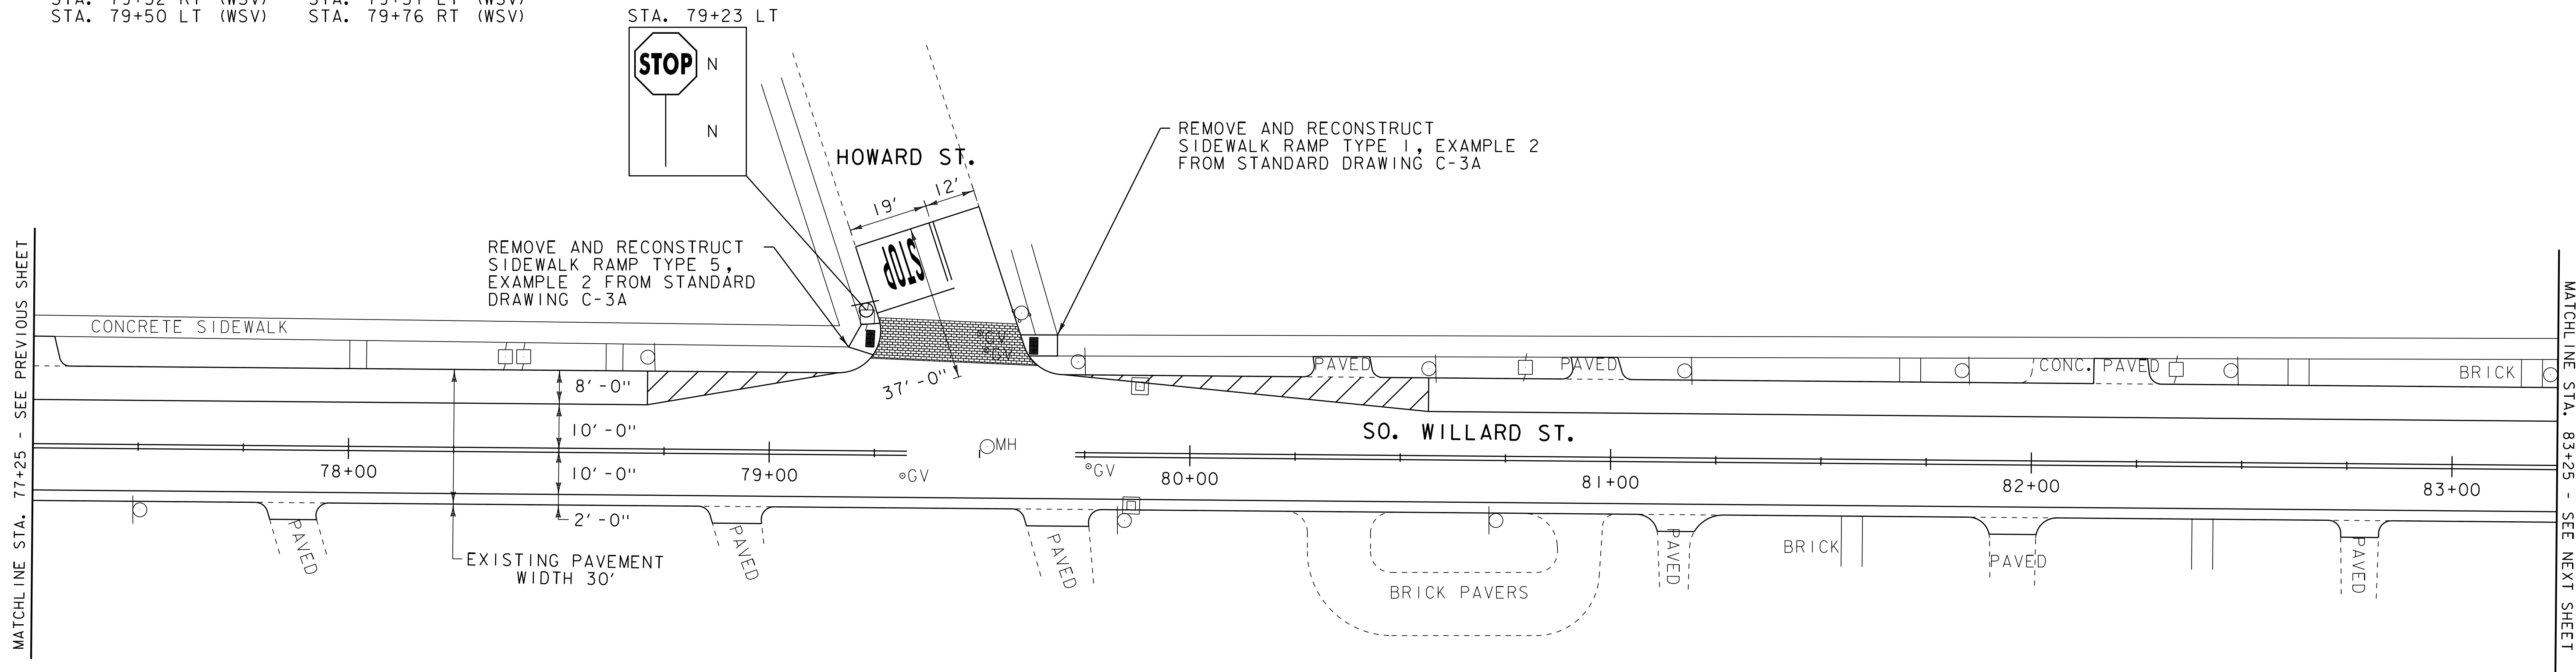

LEGEND

- | | | | |
|---|--------------------------|---|----------------------|
| ○ | SIGN | ● | LIGHT POLE |
| ○ | HYDRANT | ■ | EX. PED RAMP |
| ○ | MANHOLE | □ | JUNCTION BOX |
| ○ | VALVE | ⊗ | PED BUTTON |
| ○ | GAS PIPELINE MARKER | ⊕ | ELECTRICAL BOX |
| □ | CATCH BASIN / DROP INLET | ⊙ | SIGNAL |
| □ | CURB INLET | ⊕ | PEDESTAL POST |
| ⊗ | TRAFFIC CONTROL BOX | ⊙ | STRAIN POLE |
| ⊕ | PARKING METER | → | CAMERA |
| □ | UTILITY POLE | → | VIDEO DETECTION ZONE |

SIGN LEGEND

- R = REMOVE
 R&S = REMOVE AND SALVAGE
 RET = RETAIN
 S = SALVAGE
 N = NEW
 B-B = BACK TO BACK

NOT TO SCALE

PROJECT LAYOUT SHEET 10

PROJECT NAME: BURLINGTON (CLASS I)
 PROJECT NUMBER: STP 2721(I)

FILE NAME: 07d206.dgn
 PROJECT LEADER: CDL
 DESIGNED BY: BMB
 PLOT FILE: 07d206_26.i

PLOT DATE: 18-APR-2014 13:52
 DRAWN BY: BMB
 CHECKED BY: EPD
 SHEET 26 OF 70