

203.16 SOLID ROCK EXCAVATION

STA. 143+61 - STA. 143+65 LT
 STA. 143+61 - STA. 143+70 RT
 STA. 143+65 - STA. 143+72 LT
 STA. 143+98 - STA. 144+08 LT
 STA. 143+98 - STA. 144+08 RT
 STA. 148+17 - STA. 148+29 LT
 STA. 148+54 - STA. 148+66 LT

604.40 CHANGING ELEVATION OF DROP INLETS, CATCH BASINS, OR MANHOLES

604.412, 604.415, 604.418 REHAB, DROP INLETS, CATCH BASINS, OR MANHOLES, CLASS I, CLASS II OR CLASS III

STA. 143+65 RT "TYPE D GRATE"
 STA. 143+68 LT "TYPE D GRATE"
 STA. 144+00 RT "TYPE D GRATE"
 STA. 144+16 LT "TYPE D GRATE"
 STA. 148+15 LT "TYPE D GRATE"
 STA. 148+39 RT "TYPE D GRATE"
 STA. 148+58 LT "TYPE D GRATE"

604.42 CHANGING ELEVATION OF SEWER MANHOLES

STA. 143+84 LT
 STA. 148+44 LT

629.20 ADJUST ELEVATION OF VALVE BOX

STA. 143+58 LT (WSV) STA. 144+09 LT (WSV)
 STA. 143+75 RT (WSV) STA. 144+21 LT (WSV)
 STA. 143+81 LT (WSV) STA. 148+46 LT (WSV)
 STA. 148+50 LT (WSV)

618.10 PORTLAND CEMENT CONCRETE SIDEWALK, 5 INCH

STA. 143+61 - STA. 143+65 LT
 STA. 143+61 - STA. 143+70 RT
 STA. 143+65 - STA. 143+72 LT
 STA. 143+98 - STA. 144+08 LT
 STA. 143+98 - STA. 144+08 RT
 STA. 148+17 - STA. 148+29 LT
 STA. 148+54 - STA. 148+66 LT

618.30 DETECTABLE WARNING SURFACE

STA. 143+63 LT STA. 144+01 LT
 STA. 143+64 RT STA. 144+05 RT
 STA. 143+68 RT STA. 144+06 LT
 STA. 143+69 LT STA. 148+24 LT
 STA. 144+00 RT STA. 148+58 LT

646.406 DURABLE 4" WHITE LINE, RECESSED POLYUREA

STA. 143+25 - STA. 143+57 (SOLID LT)

646.416 DURABLE 4" YELLOW LINE, RECESSED POLYUREA

STA. 143+25 - STA. 143+53 (SOLID LT & RT)
 STA. 144+19 - STA. 148+22 (SOLID LT & RT)
 STA. 148+62 - STA. 148+75 (SOLID LT & RT)

646.426 DURABLE 6" WHITE LINE, RECESSED POLYUREA

STA. 143+25 - STA. 143+53 (SOLID RT)

646.446 DURABLE 8" WHITE LINE, RECESSED POLYUREA

STA. 143+32 (SOLID LT)
 STA. 143+32 - STA. 143+57 (HATCHED LT)

646.486 DURABLE 24" STOP BAR, RECESSED POLYUREA

STA. 143+54 RT
 STA. 143+72 - STA. 143+82 LT
 STA. 143+88 - STA. 143+98 RT
 STA. 144+18 LT

646.491 DURABLE LETTER OR SYMBOL, TYPE I TAPE

STA. 143+45 RT "STOP"
 STA. 143+77 LT "STOP"
 STA. 143+93 RT "STOP"
 STA. 144+26 LT "STOP"

646.501 DURABLE CROSSWALK MARKING, TYPE I TAPE

STA. 143+62 LT & RT
 STA. 143+70 - STA. 143+98 RT
 STA. 143+73 - STA. 143+98 LT
 STA. 144+06 LT & RT
 STA. 148+28 - STA. 148+54 LT

646.602 TEMPORARY 4" WHITE LINE, PAINT

STA. 143+25 - STA. 143+57 (SOLID LT)

646.612 TEMPORARY 4" YELLOW LINE, PAINT

STA. 143+25 - STA. 143+53 (SOLID LT & RT)
 STA. 144+19 - STA. 148+22 (SOLID LT & RT)
 STA. 148+62 - STA. 148+75 (SOLID LT & RT)

646.622 TEMPORARY 6" WHITE LINE, PAINT

STA. 143+25 - STA. 143+53 (SOLID RT)

646.642 TEMPORARY 8" WHITE LINE, PAINT

STA. 143+32 (SOLID LT)
 STA. 143+32 - STA. 143+57 (HATCHED LT)

646.682 TEMPORARY 24" STOP BAR, PAINT

STA. 143+54 RT
 STA. 143+72 - STA. 143+82 LT
 STA. 143+88 - STA. 143+98 RT
 STA. 144+18 LT

646.692 TEMPORARY LETTER OR SYMBOL, PAINT

STA. 143+45 RT "STOP"
 STA. 143+77 LT "STOP"
 STA. 143+93 RT "STOP"
 STA. 144+26 LT "STOP"

646.702 TEMPORARY CROSSWALK MARKING, PAINT


STA. 143+62 LT & RT
 STA. 143+70 - STA. 143+98 RT
 STA. 143+73 - STA. 143+98 LT
 STA. 144+06 LT & RT
 STA. 148+28 - STA. 148+54 LT

675.50 REMOVING SIGNS

AS SHOWN - 5

675.60 ERECTING SALVAGED SIGNS

AS SHOWN - 1

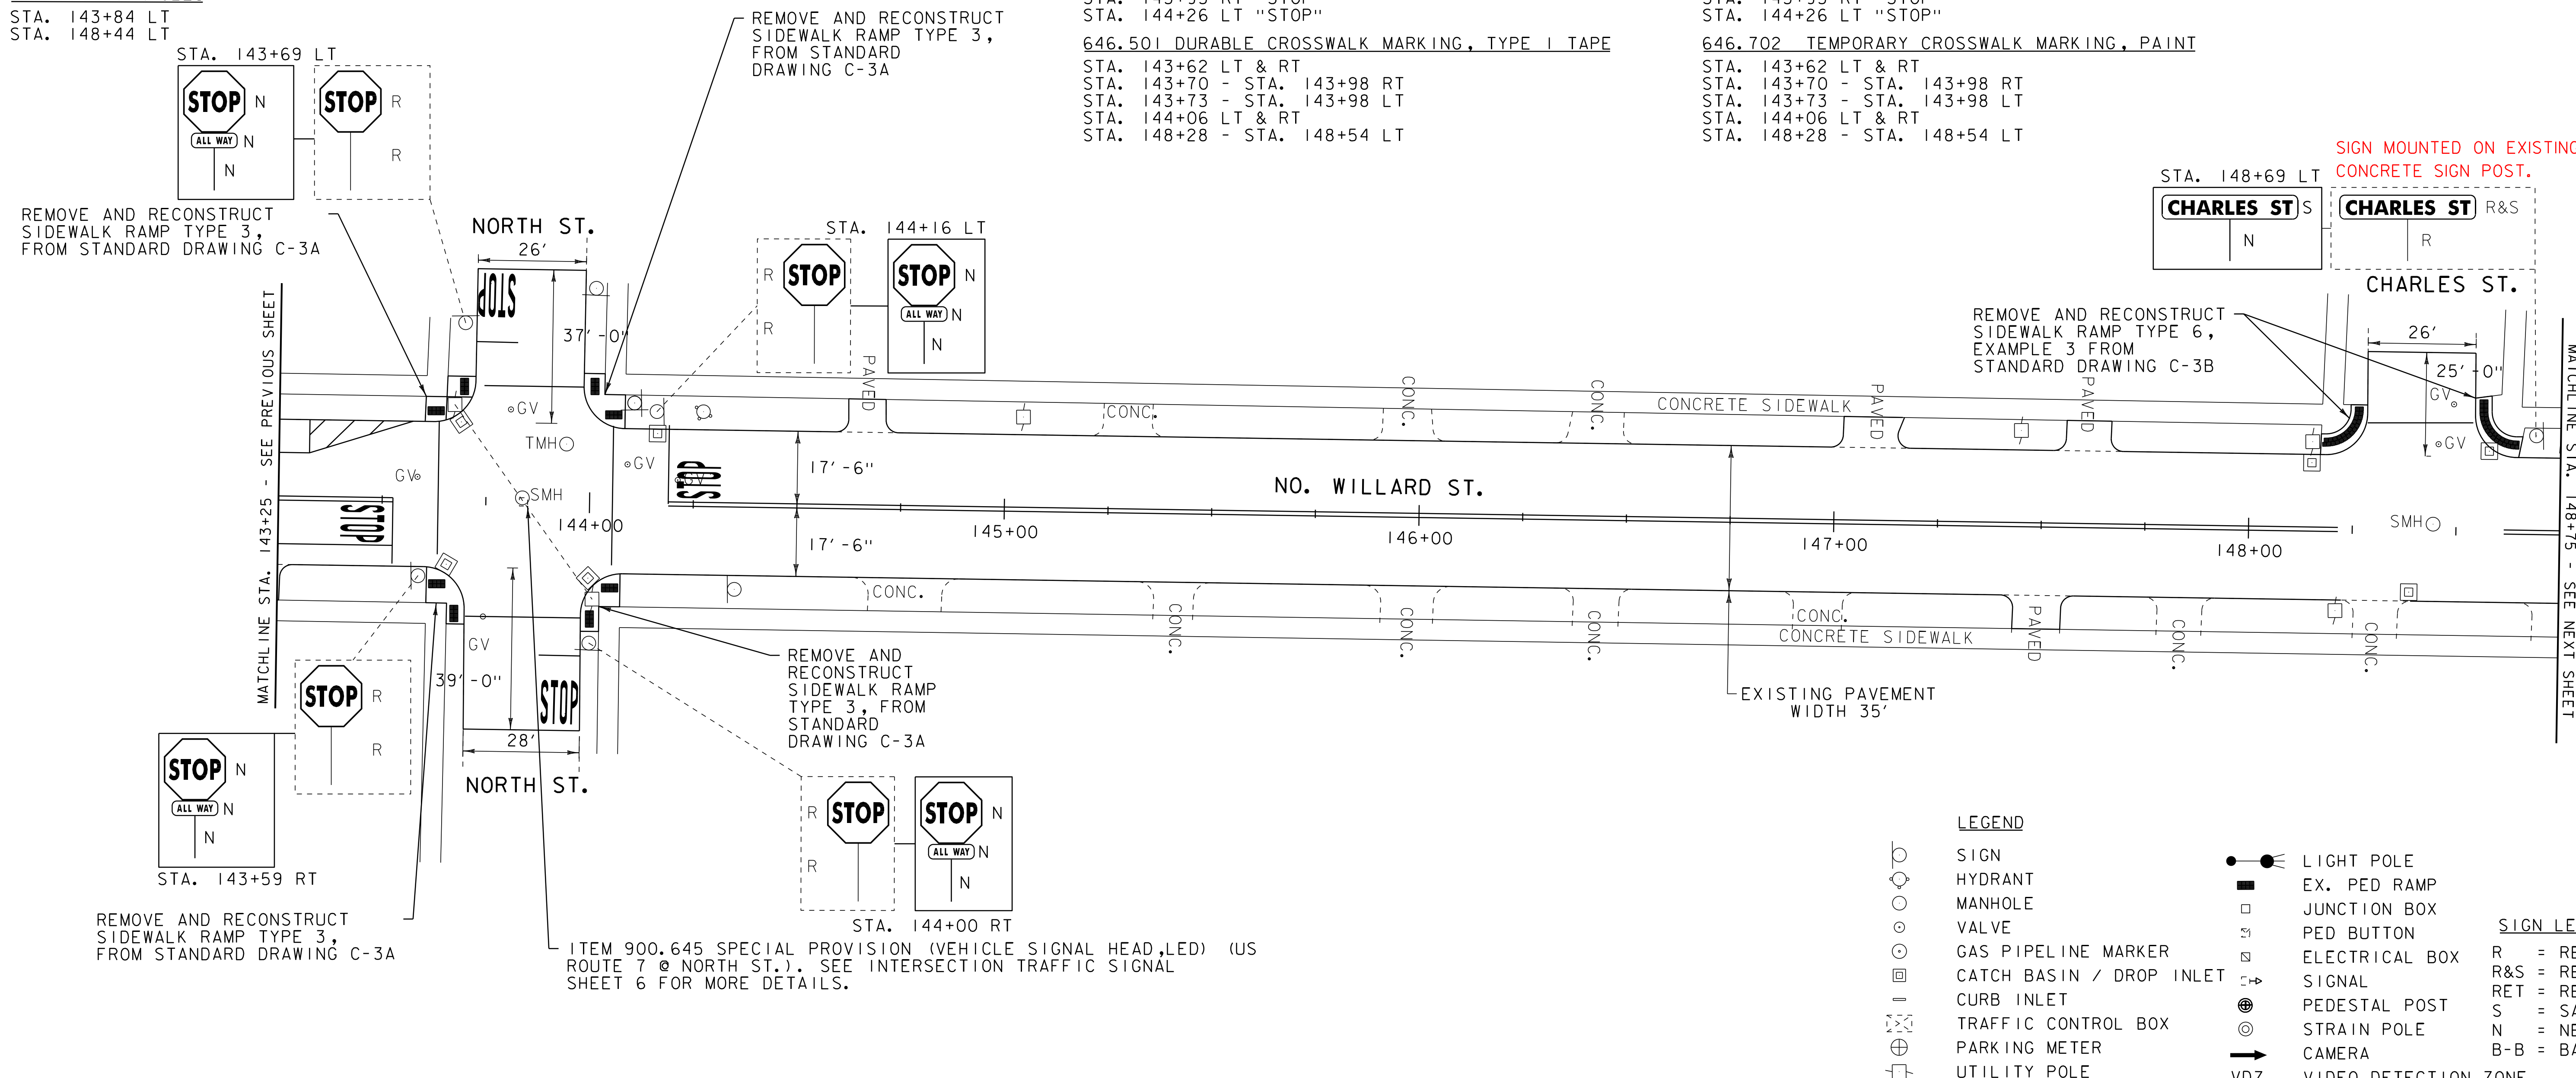

ITEM 900.645 SPECIAL PROVISION (VEHICLE SIGNAL HEAD,LED) (US ROUTE 7 @ NORTH ST.). SEE INTERSECTION TRAFFIC SIGNAL SHEET 6 FOR MORE DETAILS.

PROJECT LAYOUT SHEET 21

PROJECT NAME:	BURLINGTON (CLASS I)
PROJECT NUMBER:	STP 2721(I)
FILE NAME:	07d206.dgn
PROJECT LEADER:	CDL
DESIGNED BY:	BMB
PLOT FILE:	07d206_37.i
PLOT DATE:	18-APR-2014 13:52
DRAWN BY:	BMB
CHECKED BY:	EPD
SHEET	37 OF 70

NOT TO SCALE