

**203.16 SOLID ROCK EXCAVATION**

- STA. 155+00 - STA. 155+13 LT
- STA. 155+04 - STA. 155+15 RT
- STA. 155+39 - STA. 155+52 LT
- STA. 155+40 - STA. 155+49 RT
- STA. 156+66 - STA. 156+75 LT

**618.10 PORTLAND CEMENT CONCRETE SIDEWALK, 5 INCH**

- STA. 155+00 - STA. 155+13 LT
- STA. 155+04 - STA. 155+15 RT
- STA. 155+39 - STA. 155+52 LT
- STA. 155+40 - STA. 155+49 RT
- STA. 156+66 - STA. 156+75 LT

**618.30 DETECTABLE WARNING SURFACE**

- STA. 155+06 LT STA. 155+43 LT
- STA. 155+11 LT STA. 155+44 RT
- STA. 155+10 RT STA. 156+73 LT

**604.412, 604.415, 604.418 REHAB, DROP**

- INLETS, CATCH BASINS, OR MANHOLES, CLASS I, CLASS II OR CLASS III
- STA. 155+14 RT "TYPE D GRATE"
- STA. 155+54 RT "TYPE D GRATE"

**604.42 CHANGING ELEVATION OF SEWER MANHOLES**

- STA. 155+27 LT UNKNOWN

**629.20 ADJUST ELEVATION OF VALVE BOX**

- STA. 154+99 LT (WSV) STA. 155+52 LT (WSV)
- STA. 155+03 LT (WSV) STA. 155+58 LT (WSV)
- STA. 155+34 LT (WSV)

**646.406 DURABLE 4" WHITE LINE, RECESSED POLYUREA**

- STA. 155+52 - STA. 160+37.88 (SOLID RT)
- STA. 158+12 - STA. 160+37.88 (SOLID LT)

**646.416 DURABLE 4" YELLOW LINE, RECESSED POLYUREA**

- STA. 154+75 - STA. 154+97 (SOLID LT & RT)
- STA. 155+60 - STA. 156+75 (SOLID LT & RT)
- STA. 157+50 - STA. 160+37.88 (SOLID LT & RT)

**646.486 DURABLE 24" STOP BAR, RECESSED POLYUREA**

- STA. 154+98 RT
- STA. 155+13 - STA. 155+26 LT
- STA. 155+27 - STA. 155+39 RT
- STA. 155+59 LT
- STA. 156+65 - STA. 156+71 LT

**646.491 DURABLE LETTER OR SYMBOL, TYPE I TAPE**

- STA. 154+89 RT "STOP" STA. 156+35 LT "AHEAD"
- STA. 155+19 LT "STOP" STA. 156+58 LT "STOP"
- STA. 155+34 RT "STOP" STA. 156+75 LT "STOP"
- STA. 155+67 LT "STOP"

**646.501 DURABLE CROSSWALK MARKING, TYPE I TAPE**

- STA. 155+05 LT & RT
- STA. 155+13 - STA. 155+39 LT
- STA. 155+15 - STA. 155+40 RT
- STA. 155+46 LT & RT

**646.602 TEMPORARY 4" WHITE LINE, PAINT**

- STA. 155+52 - STA. 160+37.88 (SOLID RT)
- STA. 158+12 - STA. 160+37.88 (SOLID LT)

**646.612 TEMPORARY 4" YELLOW LINE, PAINT**

- STA. 154+75 - STA. 154+97 (SOLID LT & RT)
- STA. 155+60 - STA. 156+75 (SOLID LT & RT)
- STA. 157+50 - STA. 160+37.88 (SOLID LT & RT)

**646.682 TEMPORARY 24" STOP BAR, PAINT**

- STA. 154+98 RT
- STA. 155+13 - STA. 155+26 LT
- STA. 155+27 - STA. 155+39 RT
- STA. 155+59 LT
- STA. 156+65 - STA. 156+71 LT

**646.692 TEMPORARY LETTER OR SYMBOL, PAINT**

- STA. 154+89 RT "STOP" STA. 156+35 LT "AHEAD"
- STA. 155+19 LT "STOP" STA. 156+58 LT "STOP"
- STA. 155+34 RT "STOP" STA. 156+75 LT "STOP"
- STA. 155+67 LT "STOP"

**646.702 TEMPORARY CROSSWALK MARKING, PAINT**

- STA. 155+05 LT & RT
- STA. 155+13 - STA. 155+39 LT
- STA. 155+15 - STA. 155+40 RT
- STA. 155+46 LT & RT


**675.50 REMOVING SIGNS**

AS SHOWN - 13

**675.60 ERECTING SALVAGED SIGNS**

AS SHOWN - 5

SIDEWALK RAMPs RELOCATED ONTO HYDE ST.

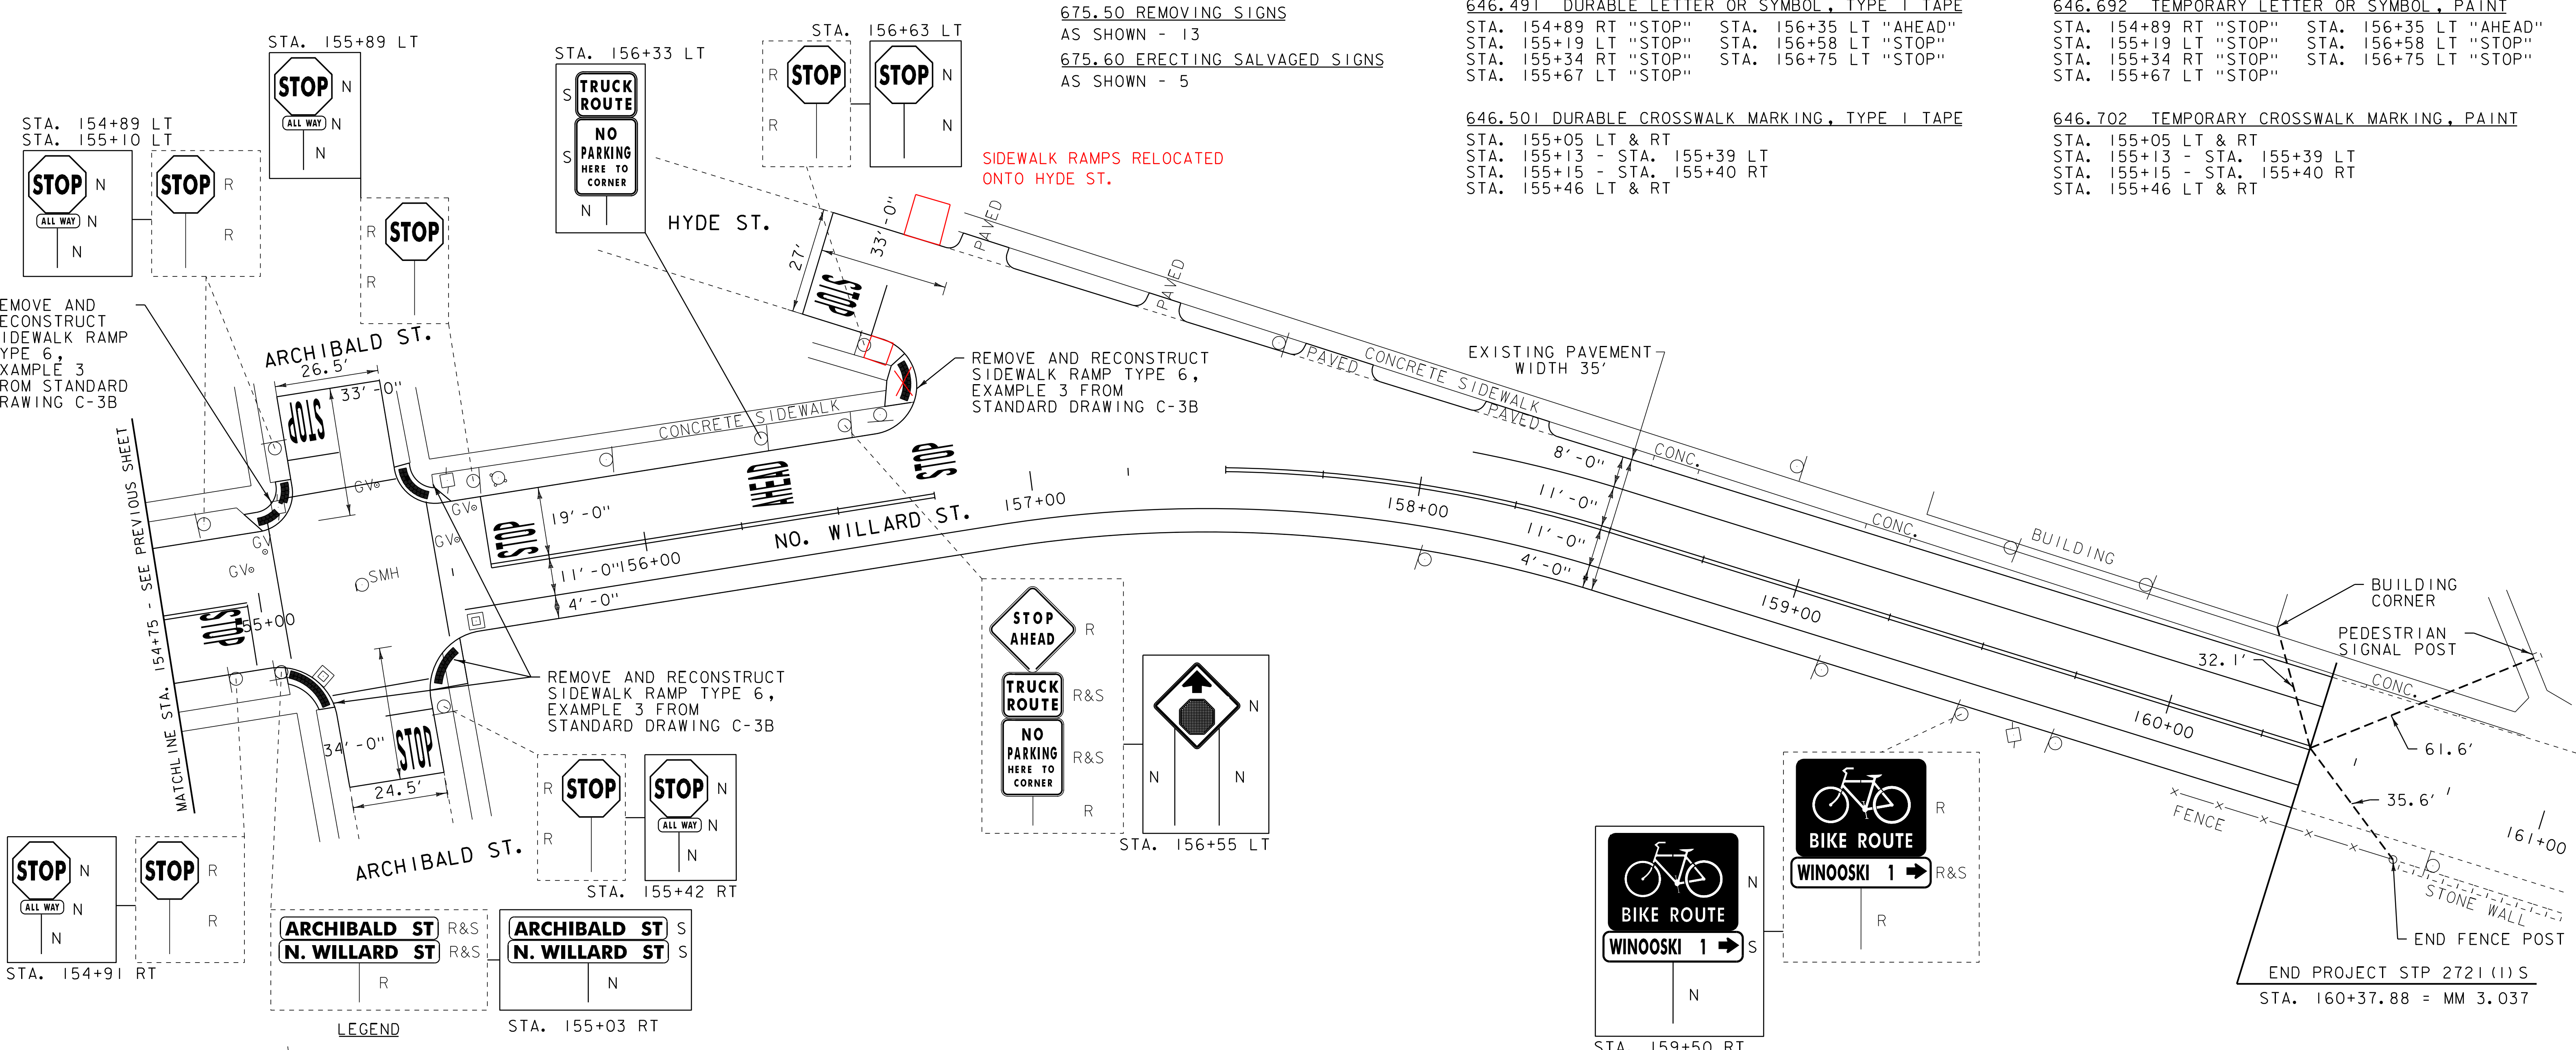

REMOVE AND RECONSTRUCT SIDEWALK RAMP TYPE 6, EXAMPLE 3 FROM STANDARD DRAWING C-3B

REMOVE AND RECONSTRUCT SIDEWALK RAMP TYPE 6, EXAMPLE 3 FROM STANDARD DRAWING C-3B

REMOVE AND RECONSTRUCT SIDEWALK RAMP TYPE 6, EXAMPLE 3 FROM STANDARD DRAWING C-3B

- LEGEND**
- SIGN
  - HYDRANT
  - MANHOLE
  - VALVE
  - GAS PIPELINE MARKER
  - CATCH BASIN / DROP INLET
  - CURB INLET
  - ⊠ TRAFFIC CONTROL BOX
  - ⊕ PARKING METER
  - ⊞ UTILITY POLE
  - LIGHT POLE
  - EX. PED RAMP
  - JUNCTION BOX
  - ⊞ PED BUTTON
  - ⊞ ELECTRICAL BOX
  - ⊞ SIGNAL
  - ⊞ PEDESTAL POST
  - ⊞ STRAIN POLE
  - CAMERA
  - VDZ VIDEO DETECTION ZONE
- SIGN LEGEND**
- R = REMOVE
  - R&S = REMOVE AND SALVAGE
  - RET = RETAIN
  - S = SALVAGE
  - N = NEW
  - B-B = BACK TO BACK

NOT TO SCALE

<b>PROJECT LAYOUT SHEET 23</b>	PROJECT NAME: BURLINGTON (CLASS I)	PLOT DATE: 18-APR-2014 13:52
	PROJECT NUMBER: STP 2721(I)	DRAWN BY: BMB
	FILE NAME: 07d206.dgn	CHECKED BY: EPD
	DESIGNED BY: BMB	SHEET 39 OF 70
	PLOT FILE: 07d206_39.i	