
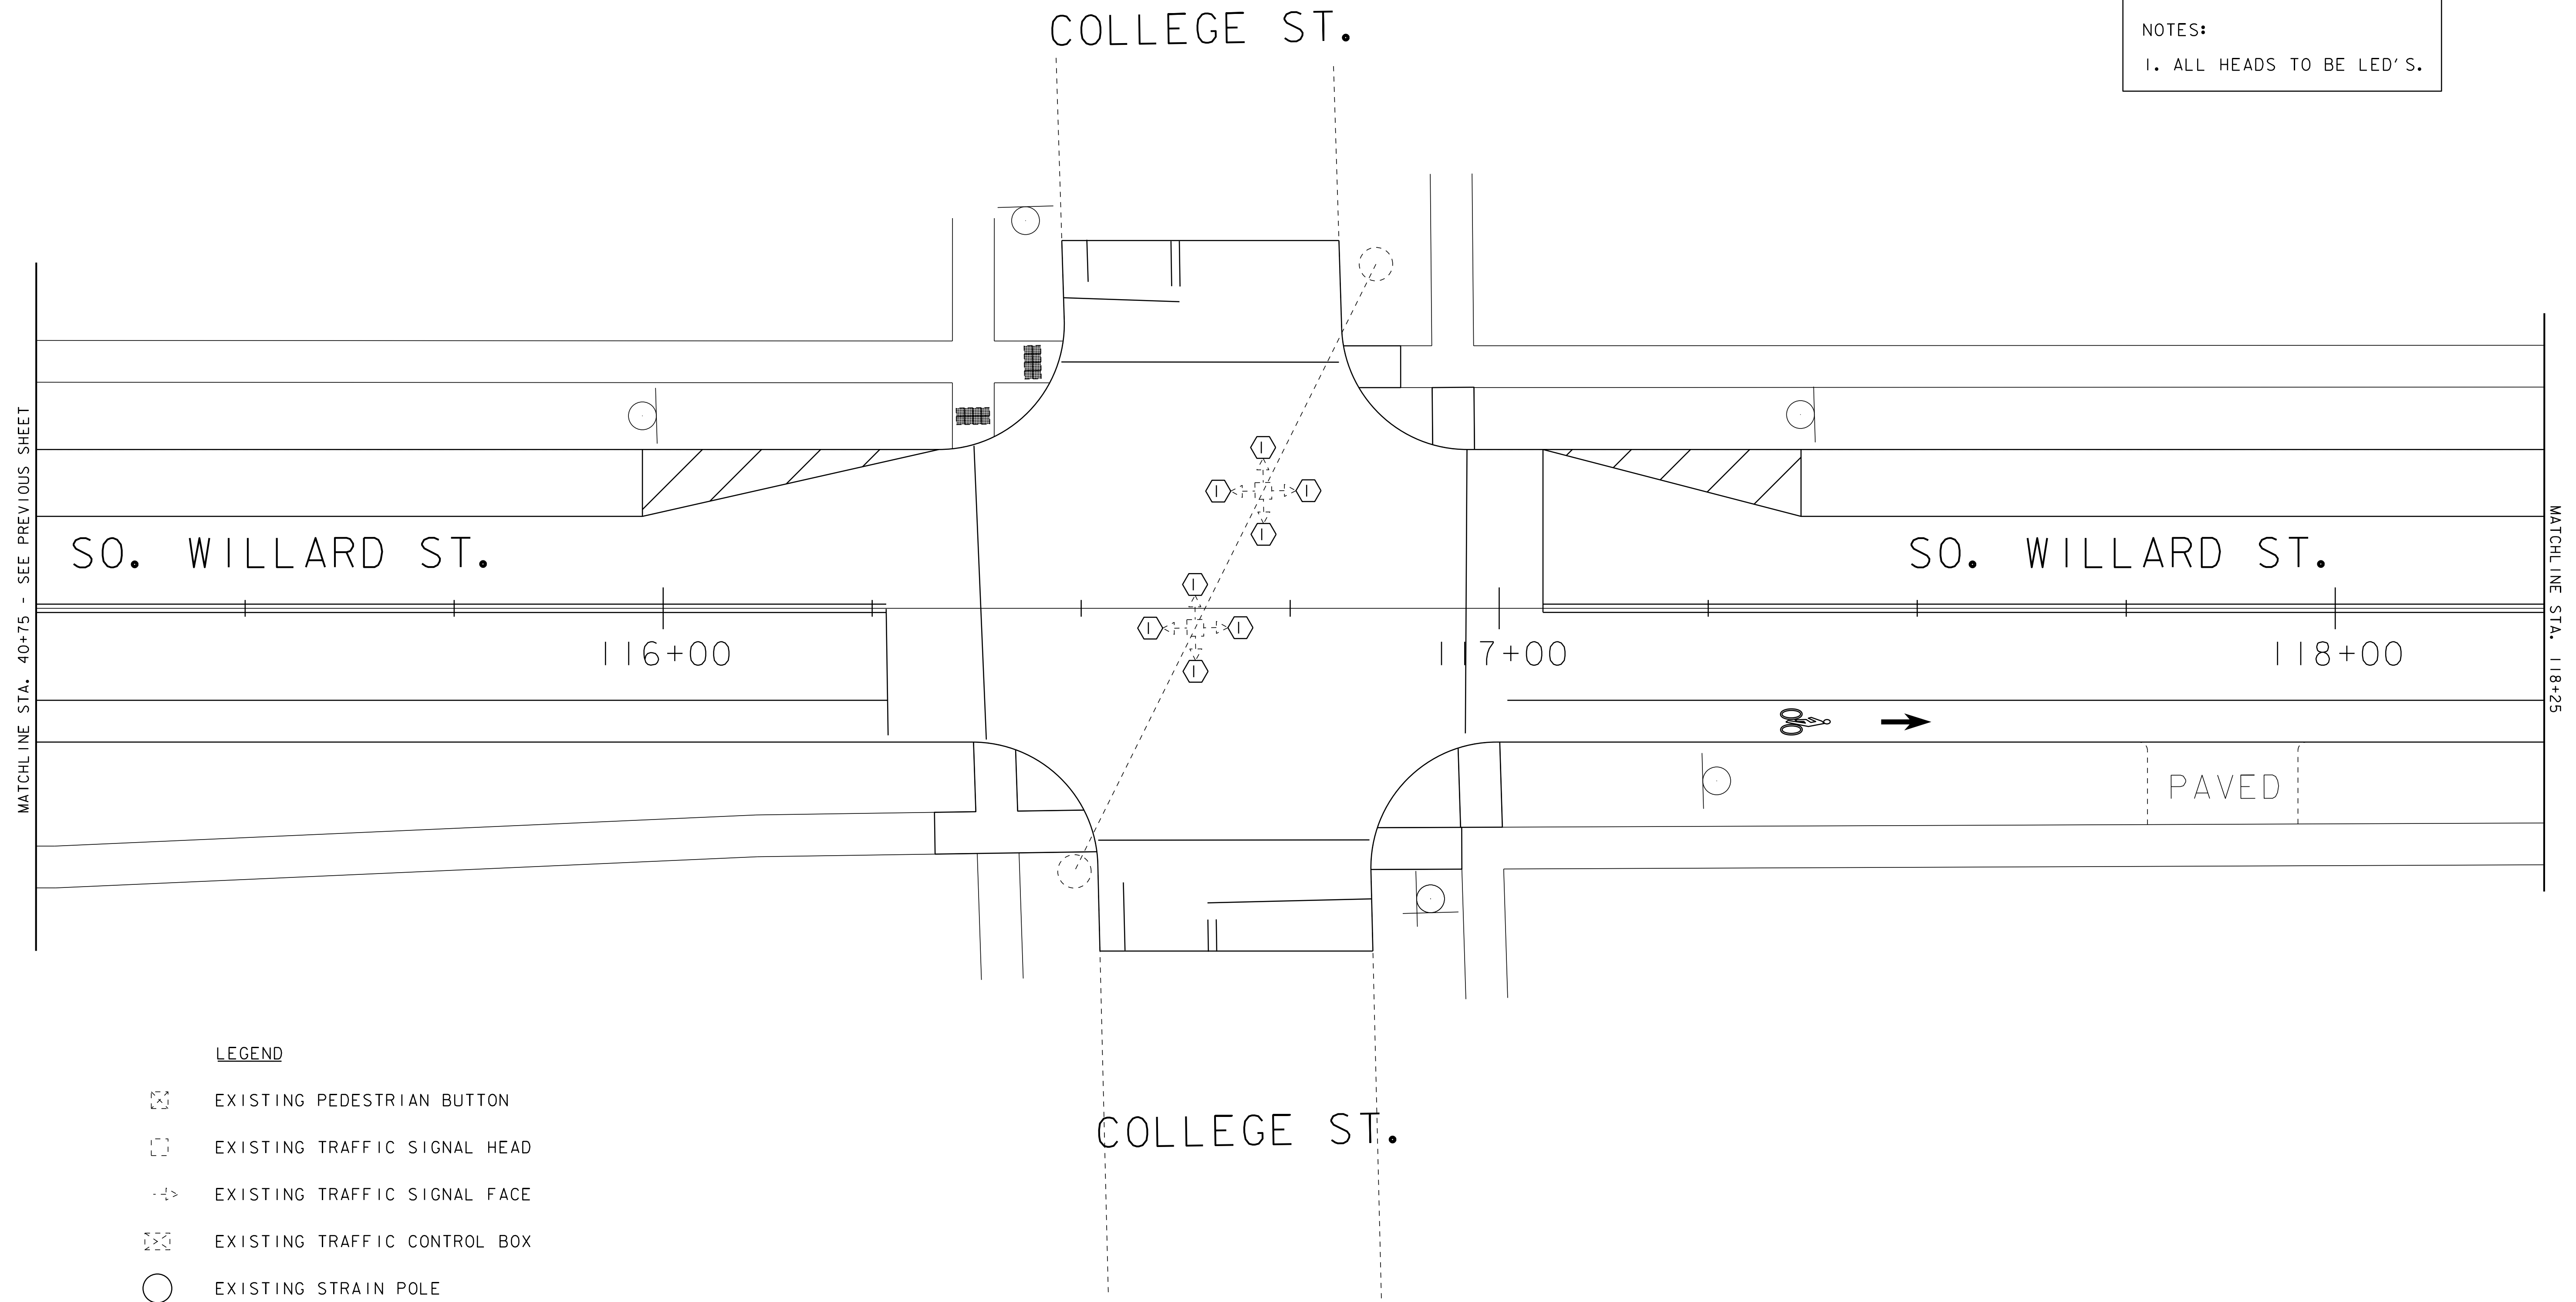


LIST OF MAJOR EQUIPMENT	QUANTITY
	(EA)
ITEM 900.645 SPECIAL PROVISION (VEHICLE SIGNAL HEADS, LED) (U.S. ROUTE 7 @ COLLEGE ST.)	
8" LED SIGNAL HEADS	8
SIGNAL HEAD MOUNTING EQUIPMENT	8
SIGNAL CABLE	8

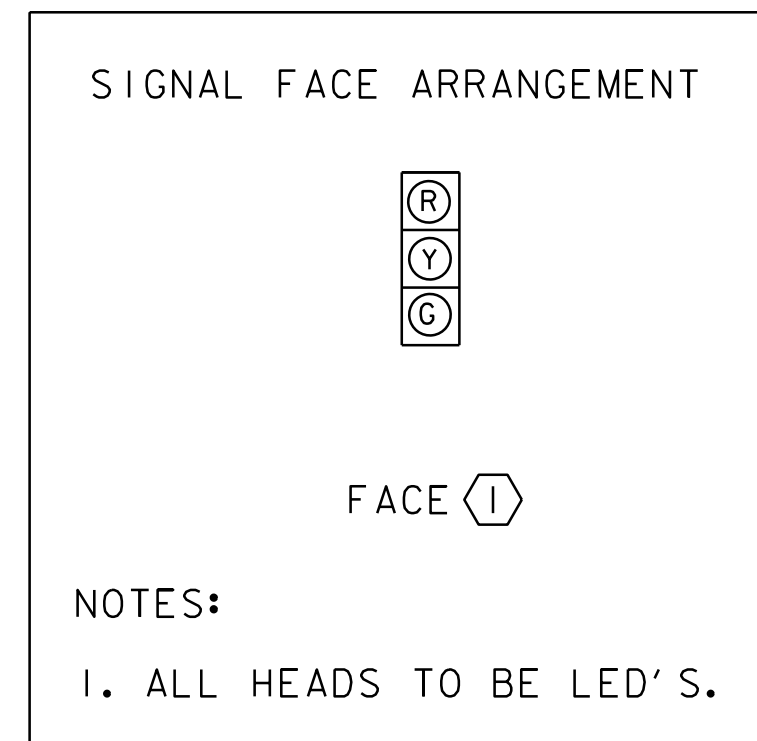

LEGEND

- EXISTING PEDESTRIAN BUTTON
- EXISTING TRAFFIC SIGNAL HEAD
- EXISTING TRAFFIC SIGNAL FACE
- EXISTING TRAFFIC CONTROL BOX
- EXISTING STRAIN POLE
- EXISTING MAST ARM
- VIDEO DETECTION ZONE
- VIDEO CAMERA

DATUM

VERTICAL	N/A
HORIZONTAL	N/A

NOT TO SCALE

INTERSECTION TRAFFIC SIGNAL EQUIPMENT SHEET 3	PROJECT NAME: BURLINGTON (CLASS 1)	PLOT DATE: 18-APR-2014 13:52
	PROJECT NUMBER: STP 2721(1)	DRAWN BY: BMB
	FILE NAME: 07d206.dgn	CHECKED BY: EPD
	DESIGNED BY: BMB	SHEET 42 OF 70
	PLOT FILE: 07d206_42.i	