


LIST OF MAJOR EQUIPMENT	QUANTITY
ITEM 900.645 SPECIAL PROVISION (VEHICLE SIGNAL HEADS, LED) (U.S. ROUTE 7 @ NORTH ST.)	(EA)
8" LED FLASHING RED SIGNAL HEADS	4
SIGNAL HEAD MOUNTING EQUIPMENT	4
SIGNAL CABLE	4

SIGNAL FACE ARRANGEMENT

FACE

NOTES:

1. ALL HEADS TO BE LED'S.

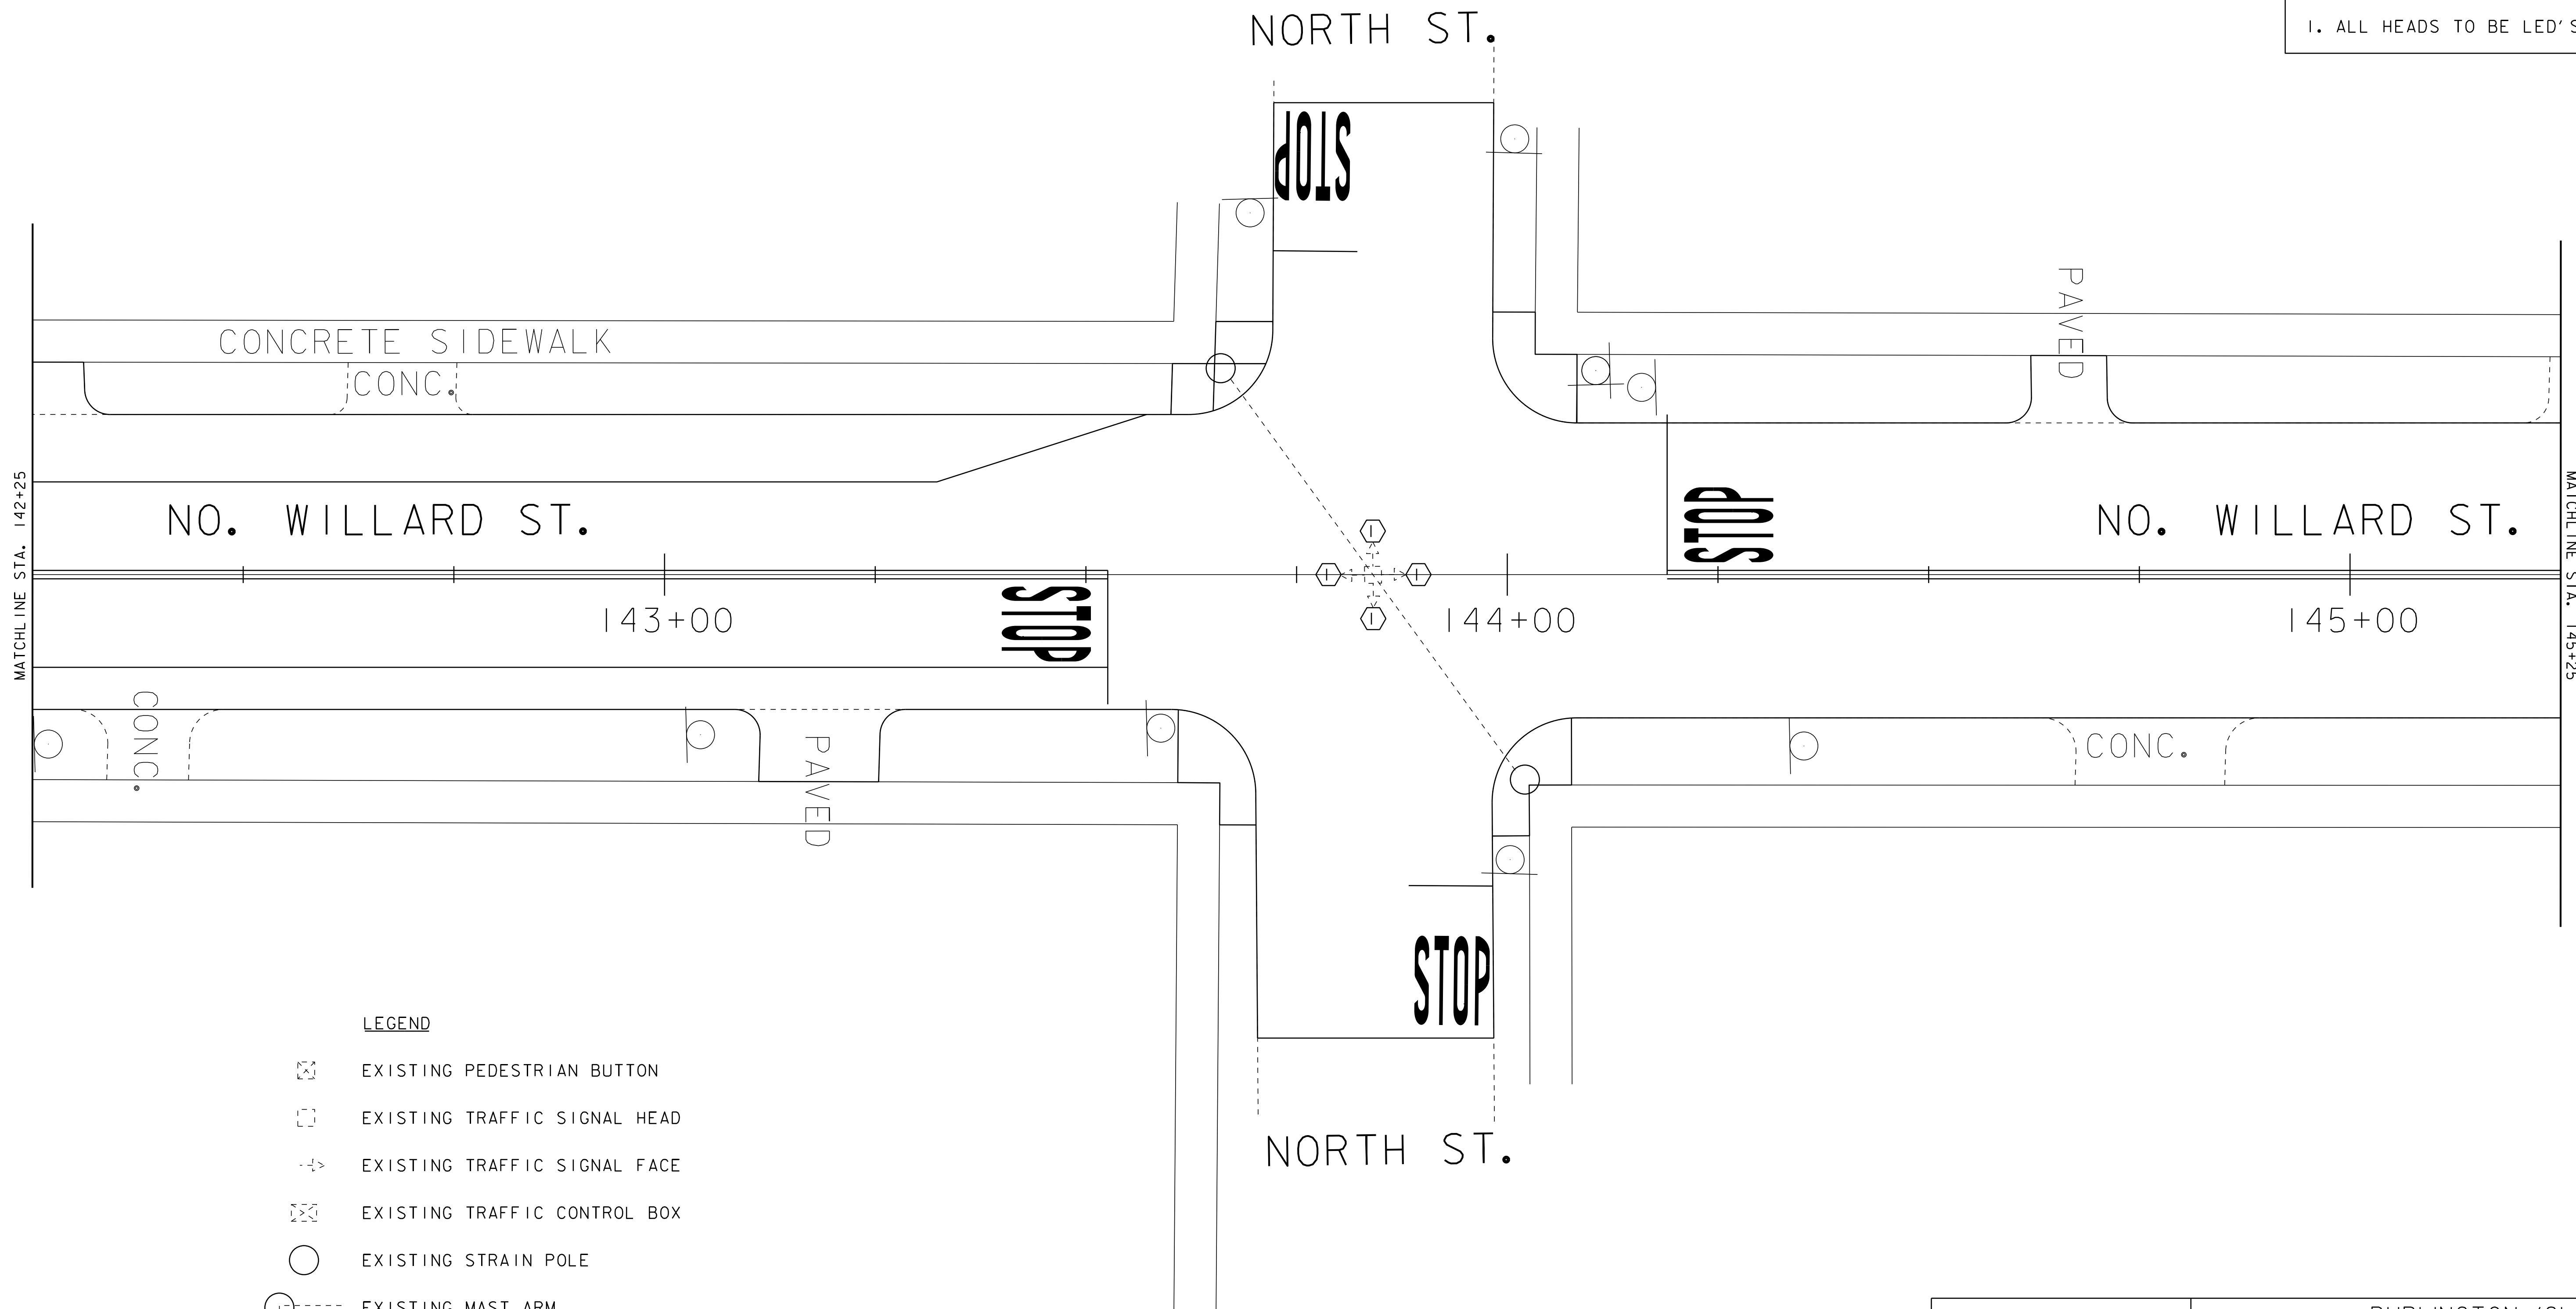

LEGEND

- EXISTING PEDESTRIAN BUTTON
- EXISTING TRAFFIC SIGNAL HEAD
- EXISTING TRAFFIC SIGNAL FACE
- EXISTING TRAFFIC CONTROL BOX
- EXISTING STRAIN POLE
- EXISTING MAST ARM
- VIDEO DETECTION ZONE
- VIDEO CAMERA

DATUM

VERTICAL	N/A
HORIZONTAL	N/A

NOT TO SCALE

<b>INTERSECTION TRAFFIC SIGNAL EQUIPMENT SHEET 6</b>	PROJECT NAME: BURLINGTON (CLASS I)	PLOT DATE: 18-APR-2014 13:52
	PROJECT NUMBER: STP 2721(I)	DRAWN BY: BMB
	FILE NAME: 07d206.dgn	CHECKED BY: EPD
	DESIGNED BY: BMB	SHEET 45 OF 70
	PLOT FILE: 07d206_45.i	