


646.407 DURABLE 4 INCH WHITE LINE, RECESSED TYPE ITAPE
 (ALL LINES WILL INCLUDE EDGE LINE BREAKS AND RADIUS FOR TOWN HIGHWAYS)
 U.S. ROUTE 7:
 STA 10+40.16 - STA 15+30.00 EDGE LINE LT / RT
 STA 10+40.16 - STA 11+90.00 DASHED LANE LINE LT
 STA 10+40.16 - STA 16+50.00 DASHED LANE LINE RT
 STA 10+40.16 - STA 16+50.00 DASHED LANE LINE LT
 STA 11+61.00 - STA 12+55.00 DOTTED LANE LINE RT
 STA 11+61.00 - STA 12+65.00 DOTTED LANE LINE RT
 STA 11+90.00 - STA 12+55.00 SOLID LANE LINE LT
 STA 11+90.00 - STA 12+65.00 SOLID LANE LINE LT
 STA 12+65.00 - STA 13+36.00 SOLID LANE LINE RT
 STA 14+25.00 - STA 15+50.00 SOLID LANE LINE LT
 STA 15+10.00 - STA 15+50.00 SOLID LANE LINE RT
 STA 15+30.00 - STA 16+09.00 DOTTED LANE LINE LT
 STA 15+30.00 - STA 16+33.00 DOTTED LANE LINE LT
 STA 15+30.00 - STA 16+33.00 DOTTED LANE LINE RT
 STA 16+33.00 - STA 16+50.00 SOLID LANE LINE RT

646.602 TEMPORARY 4 INCH WHITE LINE, PAINT
 (ALL LINES WILL INCLUDE EDGE LINE BREAKS AND RADIUS FOR TOWN HIGHWAYS)
 U.S. ROUTE 7:
 STA 10+40.16 - STA 15+30.00 EDGE LINE LT / RT
 STA 10+40.16 - STA 11+90.00 DASHED LANE LINE LT
 STA 10+40.16 - STA 16+50.00 DASHED LANE LINE RT
 STA 10+40.16 - STA 16+50.00 DASHED LANE LINE LT
 STA 11+61.00 - STA 12+55.00 DOTTED LANE LINE RT
 STA 11+61.00 - STA 12+65.00 DOTTED LANE LINE RT
 STA 11+90.00 - STA 12+55.00 SOLID LANE LINE LT
 STA 11+90.00 - STA 12+65.00 SOLID LANE LINE LT
 STA 12+65.00 - STA 13+36.00 SOLID LANE LINE RT
 STA 14+25.00 - STA 15+50.00 SOLID LANE LINE LT
 STA 15+10.00 - STA 15+50.00 SOLID LANE LINE RT
 STA 15+30.00 - STA 16+09.00 DOTTED LANE LINE LT
 STA 15+30.00 - STA 16+33.00 DOTTED LANE LINE LT
 STA 15+30.00 - STA 16+33.00 DOTTED LANE LINE RT
 STA 16+33.00 - STA 16+50.00 SOLID LANE LINE RT

646.487 DURABLE 24 INCH STOP BAR, RECESSED TYPE ITAPE
 U.S. ROUTE 7:
 STA 13+37.00 RT
 STA 14+24.00 LT
 646.682 TEMPORARY 24 INCH STOP BAR, PAINT
 U.S. ROUTE 7:
 STA 13+37.00 RT
 STA 14+24.00 LT

646.491 DURABLE LETTER OR SYMBOL, TYPE ITAPE
 U.S. ROUTE 7:
 STA 12+69.00 C/L, "O,N,L,Y" (4 EA)
 STA 13+28.00 C/L, ARROW (1EA)
 STA 14+32.00 C/L, ARROW (1EA)
 STA 14+79.00 C/L, "O,N,L,Y" (4 EA)
 STA 15+26.00 C/L, ARROW (1EA)
 STA 15+50.00 RT, YIELD LINE (3 EA)
 STA 16+37.00 C/L, "O,N,L,Y" (4 EA)
 646.692 TEMPORARY LETTER OR SYMBOL, PAINT
 U.S. ROUTE 7:
 STA 13+28.00 C/L, ARROW (1EA)
 STA 14+32.00 C/L, ARROW (1EA)
 STA 15+26.00 C/L, ARROW (1EA)
 STA 15+50.00 RT, YIELD LINE (3 EA)

646.457 DURABLE 8 INCH YELLOW LINE, RECESSED TYPE ITAPE
 U.S. ROUTE 7:
 STA 10+61.00 - STA 11+51.00 HATCHED MEDIAN C/L & RT
 STA 11+51.00 - STA 12+65.00 HATCHED MEDIAN LT & RT
 646.85 REMOVAL OF EXISTING PAVEMENT MARKINGS
 U.S. ROUTE 7:
 STA 10+40.16 - STA 11+51.00 YELLOW & WHITE LINE, 245 SF
 646.507 DURABLE CROSSWALK MARKING, RECESSED TYPE ITAPE
 U.S. ROUTE 7:
 STA 13+46.00 LT / RT
 646.702 TEMPORARY CROSSWALK MARKING, PAINT
 U.S. ROUTE 7:
 STA 13+46.00 LT / RT
 675.50 REMOVING SIGNS
 AS SHOWN - 4

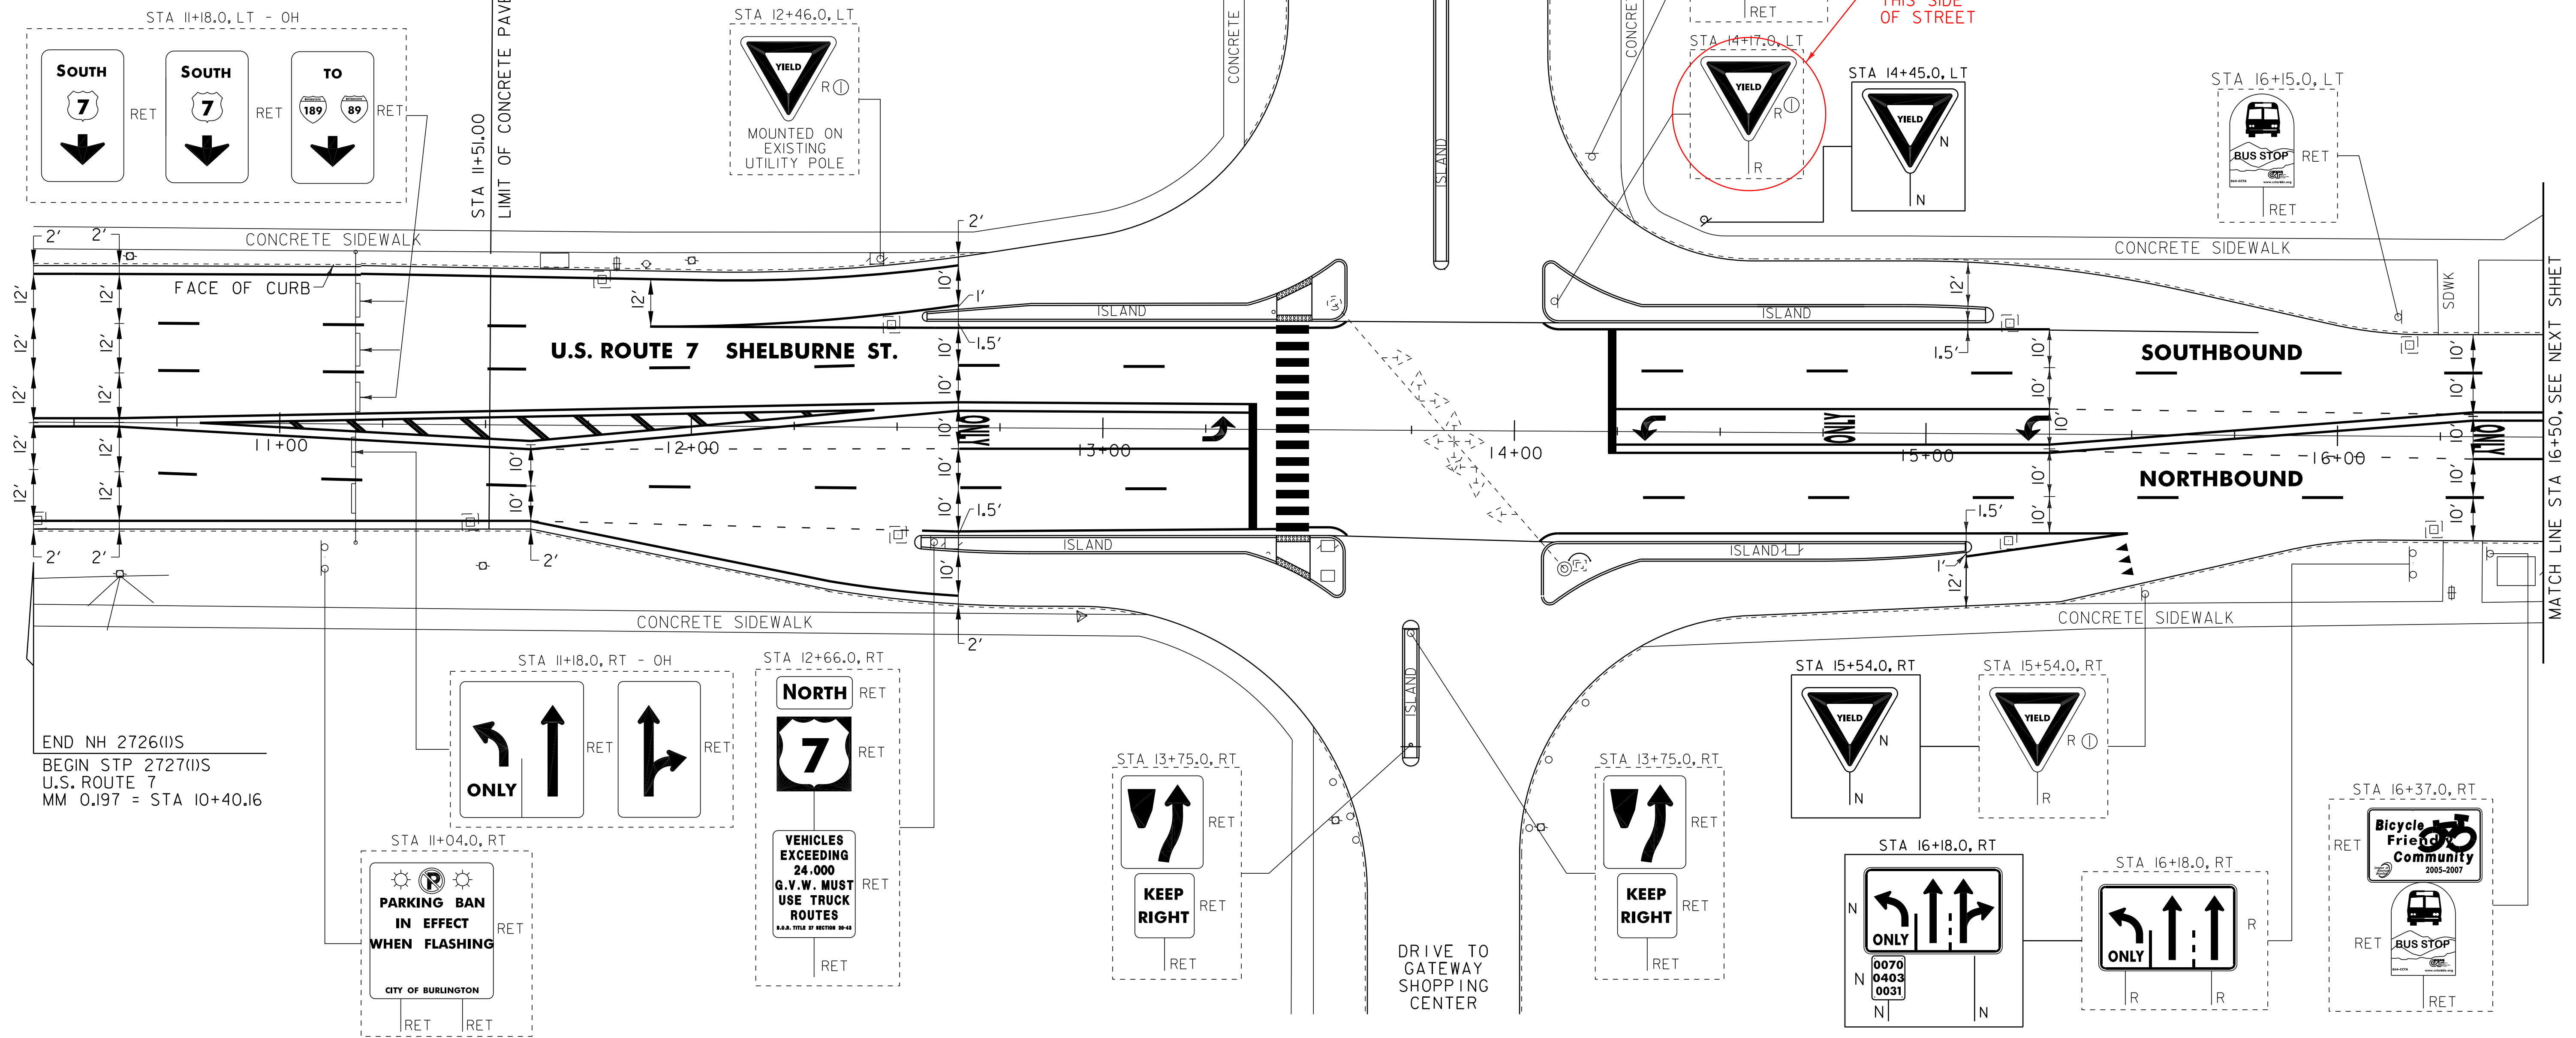

646.417 DURABLE 4 INCH YELLOW LINE, RECESSED TYPE ITAPE
 U.S. ROUTE 7:
 STA 10+40.16 - STA 10+61.00 DOUBLE SOLID C/L
 STA 10+61.00 - STA 12+65.00 DOUBLE SOLID MEDIAN LT & RT
 STA 12+65.00 - STA 13+36.00 DOUBLE SOLID LT
 STA 14+25.00 - STA 16+50.00 DOUBLE SOLID RT / LT

646.612 TEMPORARY 4 INCH YELLOW LINE, PAINT
 U.S. ROUTE 7:
 STA 10+40.16 - STA 10+61.00 DOUBLE SOLID C/L
 STA 10+61.00 - STA 12+65.00 DOUBLE SOLID MEDIAN LT & RT
 STA 12+65.00 - STA 13+36.00 DOUBLE SOLID LT
 STA 14+25.00 - STA 16+50.00 DOUBLE SOLID RT / LT

SIGN LEGEND
 R = REMOVE
 S = SALVAGE
 N = NEW
 RET = RETAIN
 B-B = BACK TO BACK
 EXISTING = - - - - -
 NEW = _____
 ⊕ = RETURN TO BURLINGTON CITY

SIGNING & STRIPING PLAN SHEET #1

NOTES:
 1. SEE SHEET 5 FOR DETAIL OF CROSSWALK MARKINGS.
 2. SEE SHEET 5 FOR YIELD LINE DETAIL.

PROJECT NAME: BURLINGTON CITY
 PROJECT NUMBER: STP 2727(I)S

FILE NAME: 07D222.dgn
 PROJECT LEADER: DEG
 DESIGNED BY: JPS
 IPARM FILE: 07D222_47.1

PLOT DATE: 31-OCT-2011 16:45
 DRAWN BY: KAR
 CHECKED BY: DWE
 SHEET 47 OF 88