

646.407 DURABLE 4 INCH WHITE LINE, RECESSED TYPE ITAPE

U.S. ROUTE 7:  
STA 22+00.00 - STA 23+75.00 DASHED LANE LINE LT  
STA 22+00.00 - STA 23+75.00 DASHED LANE LINE RT

646.602 TEMPORARY 4 INCH WHITE LINE, PAINT

U.S. ROUTE 7:  
STA 22+00.00 - STA 23+75.00 DASHED LANE LINE LT  
STA 22+00.00 - STA 23+75.00 DASHED LANE LINE RT

646.487 DURABLE 24 INCH STOP BAR, RECESSED TYPE ITAPE

U.S. ROUTE 7:  
STA 23+17.81 RT, HADLEY ROAD

646.682 TEMPORARY 24 INCH STOP BAR, PAINT

U.S. ROUTE 7:  
STA 23+17.81 RT, HADLEY ROAD

646.491 DURABLE LETTER OR SYMBOL, TYPE ITAPE

U.S. ROUTE 7:  
STA 23+17.81 RT, HADLEY ROAD "S,T,O,P" (4 EA)

646.692 TEMPORARY LETTER OR SYMBOL, PAINT

U.S. ROUTE 7:  
STA 23+17.81 RT, HADLEY ROAD "S,T,O,P" (4 EA)

646.507 DURABLE CROSSWALK MARKING, RECESSED TYPE ITAPE

U.S. ROUTE 7:  
STA 23+17.81 RT, HADLEY ROAD

646.702 TEMPORARY CROSSWALK MARKING, PAINT

U.S. ROUTE 7:  
STA 23+17.81 RT, HADLEY ROAD

646.417 DURABLE 4 INCH YELLOW LINE, RECESSED TYPE ITAPE

(ALL LINES WILL INCLUDE C/L BREAKS FOR TOWN HIGHWAYS)

U.S. ROUTE 7:

STA 22+00.00 - STA 22+92.00 DOUBLE SOLID MEDIAN LT & RT  
STA 22+92.00 - STA 23+75.00 DOUBLE SOLID C/L  
STA 23+17.81 DOUBLE SOLID RT, HADLEY ROAD

646.612 TEMPORARY 4 INCH YELLOW LINE, PAINT

(ALL LINES WILL INCLUDE C/L BREAKS FOR TOWN HIGHWAYS)

U.S. ROUTE 7:

STA 22+00.00 - STA 22+92.00 DOUBLE SOLID MEDIAN LT & RT  
STA 22+92.00 - STA 23+75.00 DOUBLE SOLID C/L  
STA 23+17.81 DOUBLE SOLID RT, HADLEY ROAD

646.457 DURABLE 8 INCH YELLOW LINE, RECESSED TYPE ITAPE


U.S. ROUTE 7:  
STA 22+00.00 - STA 22+92.00 HATCHED MEDIAN LT & RT

675.50 REMOVING SIGNS

AS SHOWN - 2

675.60 ERECTING SALVAGED SIGNS

AS SHOWN - 1

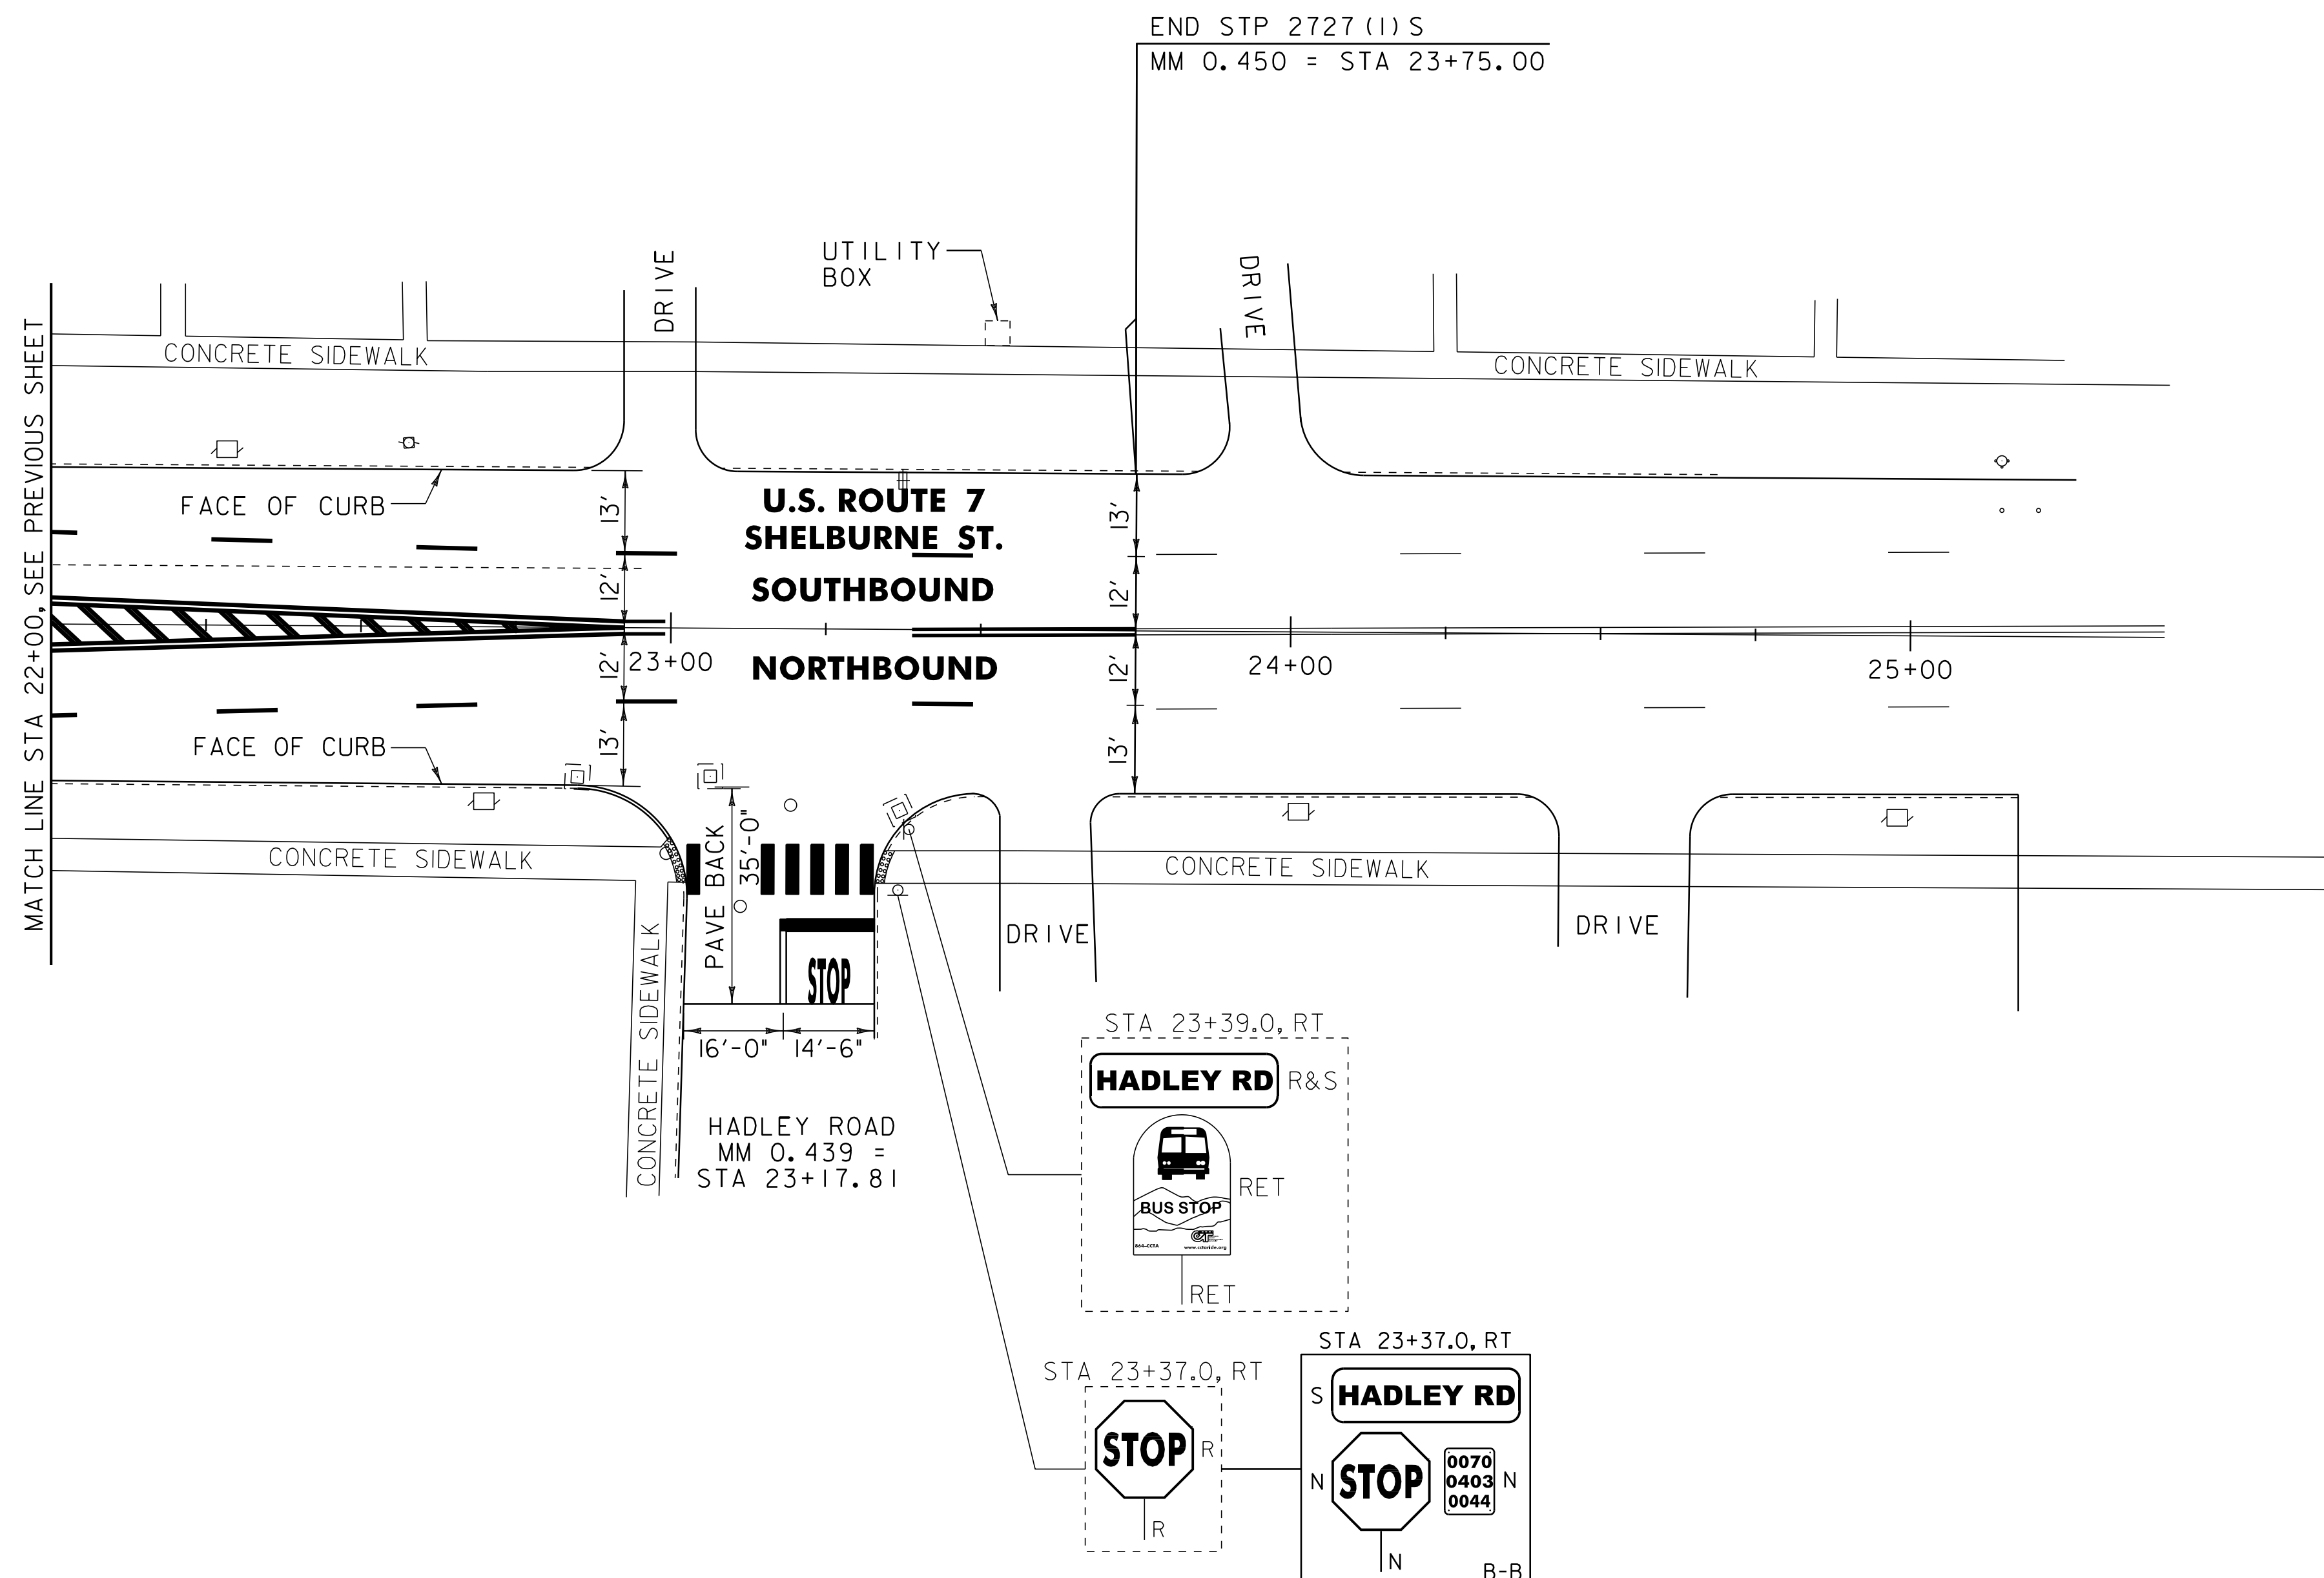

NOTE:  
1. SEE SHEET 5 FOR DETAIL OF CROSSWALK MARKINGS.

**SIGN LEGEND**  
 R = REMOVE  
 S = SALVAGE  
 N = NEW  
 RET = RETAIN  
 B-B = BACK TO BACK  
 EXISTING = - - - - -  
 NEW = \_\_\_\_\_

<b>SIGNING &amp; STRIPING PLAN SHEET #3</b>	PROJECT NAME: BURLINGTON CITY	PLOT DATE: 31-OCT-2011 6:45
	PROJECT NUMBER: STP 2727(I)S	DRAWN BY: KAR
	FILE NAME: 07D222.dgn	CHECKED BY: DWE
	DESIGNED BY: JPS	SHEET 49 OF 88