
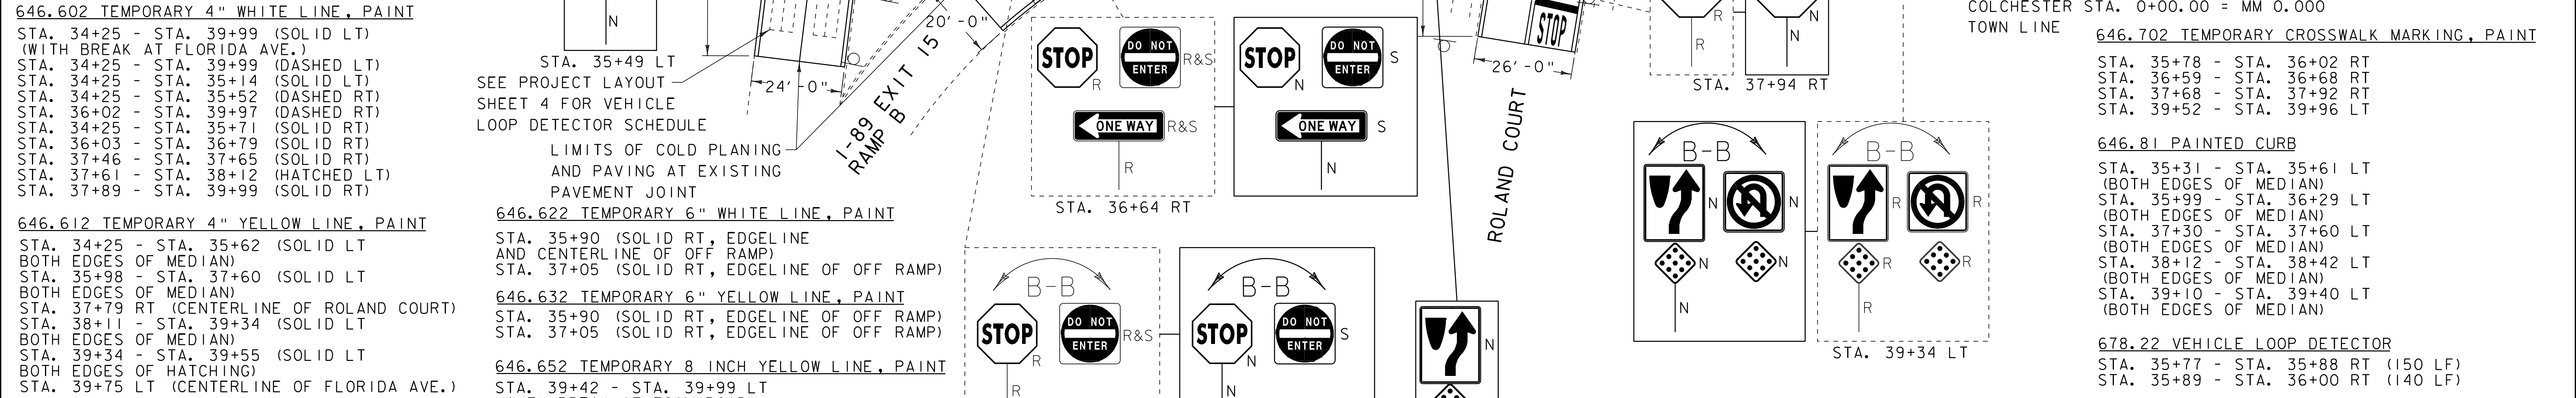
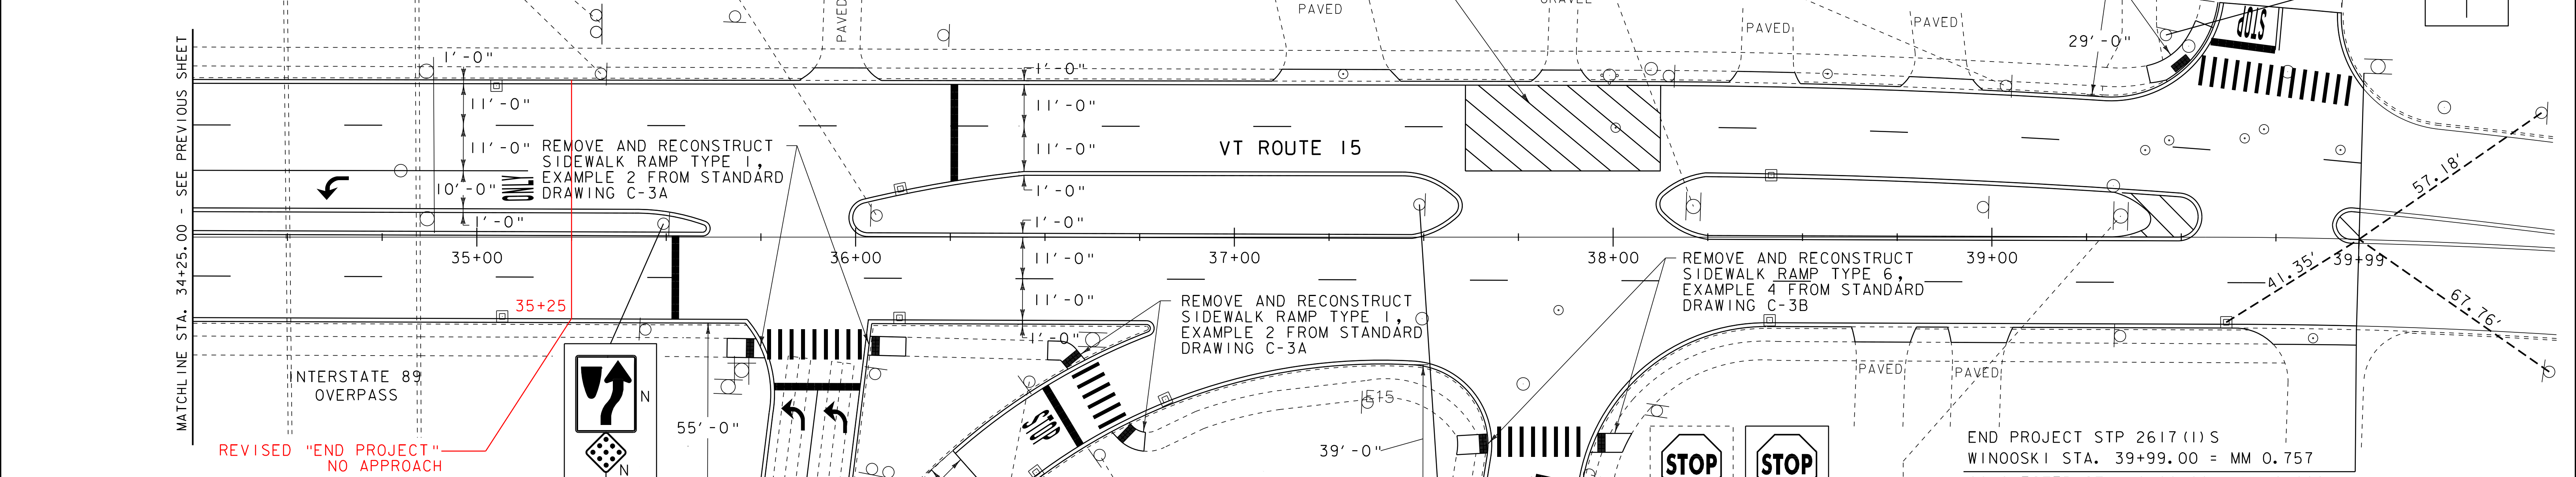


- 604.412, 604.415, 604.418 REHAB, DROP INLETS, CATCH BASINS, OR MANHOLES, CLASS I, CLASS II OR CLASS III
- 675.50 REMOVING SIGNS AS SHOWN - 23
- 675.60 ERECTING SALVAGED SIGNS AS SHOWN - 6
- 618.30 DETECTABLE WARNING SURFACE
- 618.10 PORTLAND CEMENT CONCRETE SIDEWALK, 5 INCH
- 629.20 ADJUST ELEVATION OF VALVE BOX
- 646.407 DURABLE 4 INCH WHITE LINE, RECESSED TYPE I TAPE
- 646.417 DURABLE 4 INCH YELLOW LINE, RECESSED TYPE I TAPE
- 646.427 DURABLE 6 INCH WHITE LINE, RECESSED TYPE I TAPE
- 646.437 DURABLE 6 INCH YELLOW LINE, RECESSED TYPE I TAPE
- 646.457 DURABLE 8 INCH YELLOW LINE, RECESSED TYPE I TAPE
- 646.487 DURABLE 24 INCH STOP BAR, RECESSED TYPE I TAPE
- 646.491 DURABLE LETTER OR SYMBOL, TYPE I TAPE
- 646.507 DURABLE CROSSWALK MARKING, RECESSED TYPE I TAPE
- 646.602 TEMPORARY 4" WHITE LINE, PAINT
- 646.612 TEMPORARY 4" YELLOW LINE, PAINT
- 646.622 TEMPORARY 6" WHITE LINE, PAINT
- 646.632 TEMPORARY 6" YELLOW LINE, PAINT
- 646.652 TEMPORARY 8 INCH YELLOW LINE, PAINT
- 646.682 TEMPORARY 24" STOP BAR, PAINT
- 646.692 TEMPORARY LETTER OR SYMBOL, PAINT
- 646.702 TEMPORARY CROSSWALK MARKING, PAINT
- 646.81 PAINTED CURB
- 678.22 VEHICLE LOOP DETECTOR

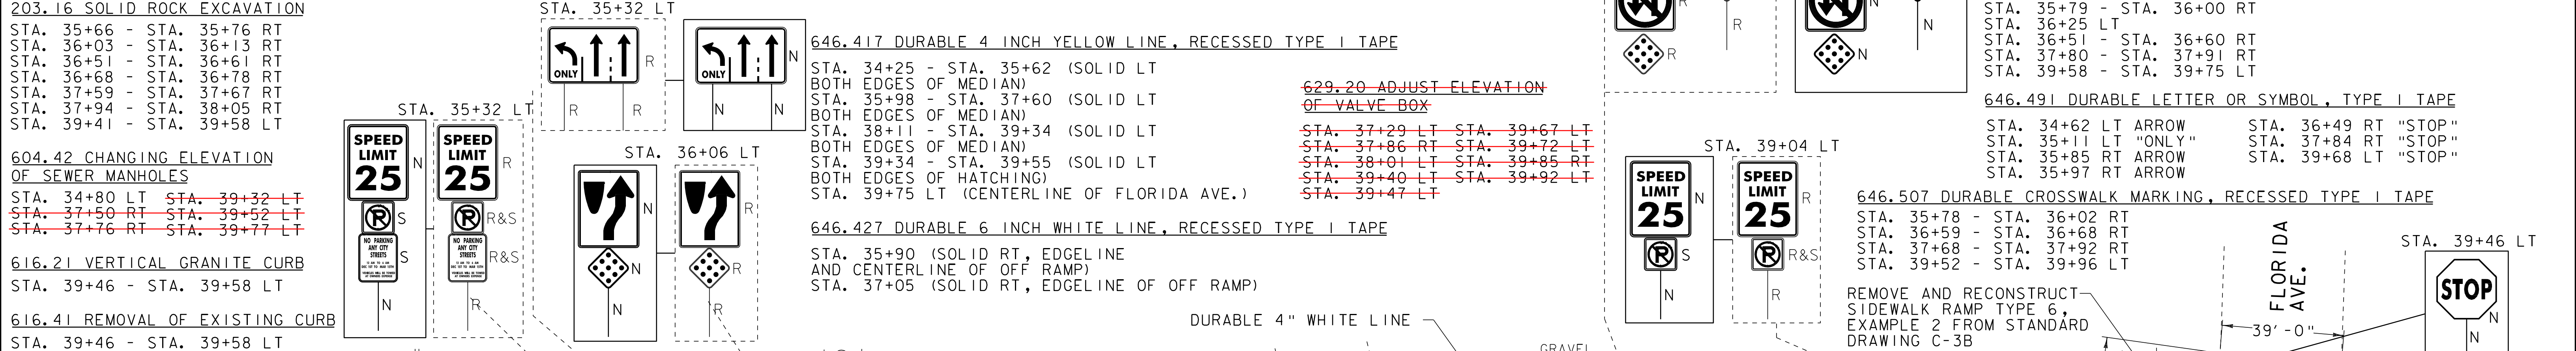

<p>DATUM</p> <p>VERTICAL N/A</p> <p>HORIZONTAL N/A</p>		<p>646.682 TEMPORARY 24" STOP BAR, PAINT</p> <p>STA. 35+53 RT</p> <p>STA. 35+79 - STA. 36+00 RT</p> <p>STA. 36+25 LT</p> <p>STA. 36+51 - STA. 36+60 RT</p> <p>STA. 37+80 - STA. 37+91 RT</p> <p>STA. 39+58 - STA. 39+75 LT</p>		<p>646.692 TEMPORARY LETTER OR SYMBOL, PAINT</p> <p>STA. 34+62 LT ARROW</p> <p>STA. 35+11 LT "ONLY"</p> <p>STA. 35+85 RT ARROW</p> <p>STA. 35+97 RT ARROW</p> <p>STA. 36+49 RT "STOP"</p> <p>STA. 37+84 RT "STOP"</p> <p>STA. 39+68 LT "STOP"</p>		<p>SIGN LEGEND</p> <p>R = REMOVE</p> <p>S = SALVAGE</p> <p>N = NEW</p> <p>RET = RETAIN</p> <p>B-B = BACK TO BACK</p>		<p>PROJECT LAYOUT SHEET 5</p>		<p>PROJECT NAME: WINOOSKI</p> <p>PROJECT NUMBER: STP 2617(1)S</p> <p>FILE NAME: 06d064.dgn</p> <p>PROJECT LEADER: CDL</p> <p>DESIGNED BY: SJL</p> <p>PLOT FILE: 06D064.67.i</p>		<p>END PROJECT STP 2617(1)S</p> <p>WINOOSKI STA. 39+99.00 = MM 0.757</p> <p>COLCHESTER STA. 0+00.00 = MM 0.000</p> <p>TOWN LINE</p> <p>646.702 TEMPORARY CROSSWALK MARKING, PAINT</p> <p>STA. 35+78 - STA. 36+02 RT</p> <p>STA. 36+59 - STA. 36+68 RT</p> <p>STA. 37+68 - STA. 37+92 RT</p> <p>STA. 39+52 - STA. 39+96 LT</p> <p>646.81 PAINTED CURB</p> <p>STA. 35+31 - STA. 35+61 LT (BOTH EDGES OF MEDIAN)</p> <p>STA. 35+99 - STA. 36+29 LT (BOTH EDGES OF MEDIAN)</p> <p>STA. 37+30 - STA. 37+60 LT (BOTH EDGES OF MEDIAN)</p> <p>STA. 38+12 - STA. 38+42 LT (BOTH EDGES OF MEDIAN)</p> <p>STA. 39+10 - STA. 39+40 LT (BOTH EDGES OF MEDIAN)</p> <p>678.22 VEHICLE LOOP DETECTOR</p> <p>STA. 35+77 - STA. 35+88 RT (150 LF)</p> <p>STA. 35+89 - STA. 36+00 RT (140 LF)</p>	
--	--	--	--	---	--	--	--	--------------------------------------	--	---	--	---	--