


BEGIN PROJECT STP 2617 (I)S  
 STA. 1+68.96 = MM 0.032  
 BEGIN COLD PLANING AND PAVING  
 SAWCUT/BUTT JOINT AT EXISTING  
 PLUG JOINT (TO REMAIN UNDISTURBED)

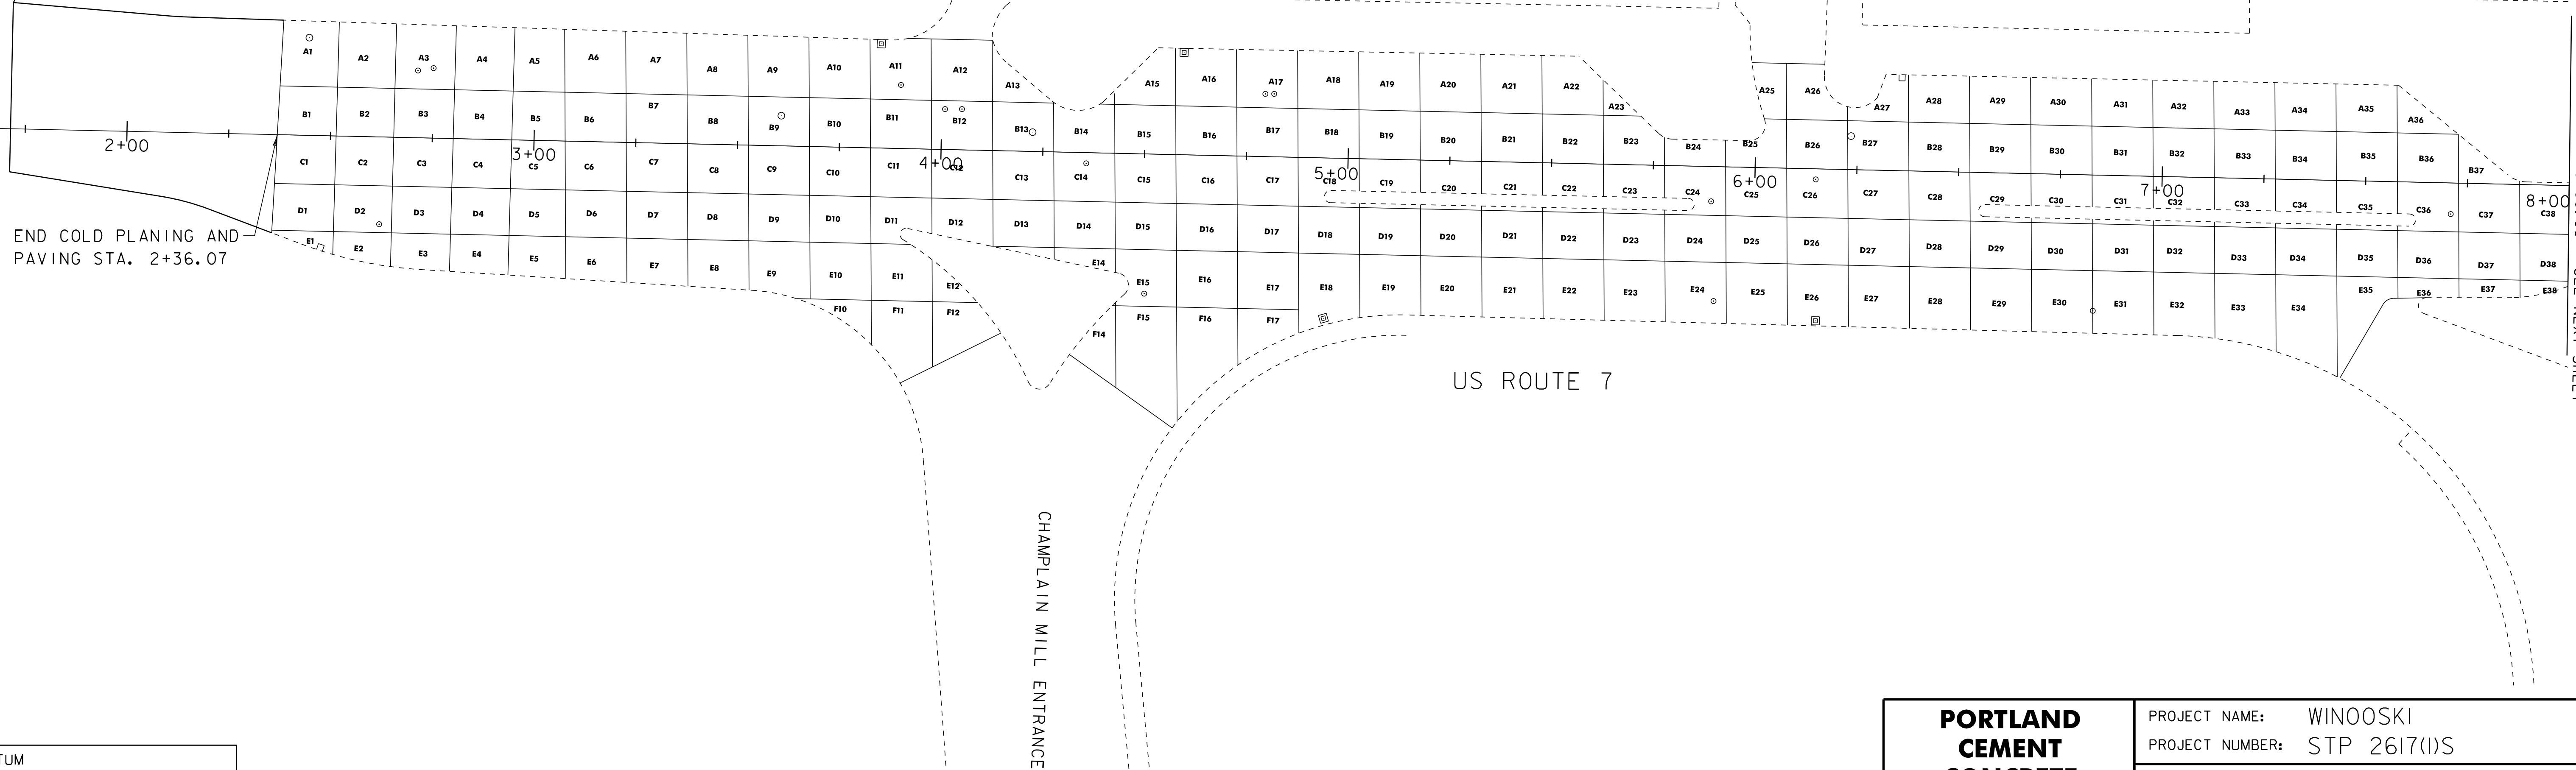

END COLD PLANING AND  
 PAVING STA. 2+36.07

MATCHLINE STA. 8+00.00 - SEE NEXT SHEET

DATUM	
VERTICAL	N/A
HORIZONTAL	N/A

<b>PORTLAND          CEMENT          CONCRETE          PAVEMENT          GRID LAYOUT #1</b>	PROJECT NAME: WINOOSKI	PLOT DATE: 31-OCT-2011 16:46
	PROJECT NUMBER: STP 2617(I)S	DRAWN BY: SJL
	FILE NAME: 06d064.dgn	CHECKED BY: EPD
	PROJECT LEADER: CDL	SHEET 68 OF 88
	DESIGNED BY: SJL	
	PLOT FILE: 06D064_68.i	