




U. S. ROUTE 7

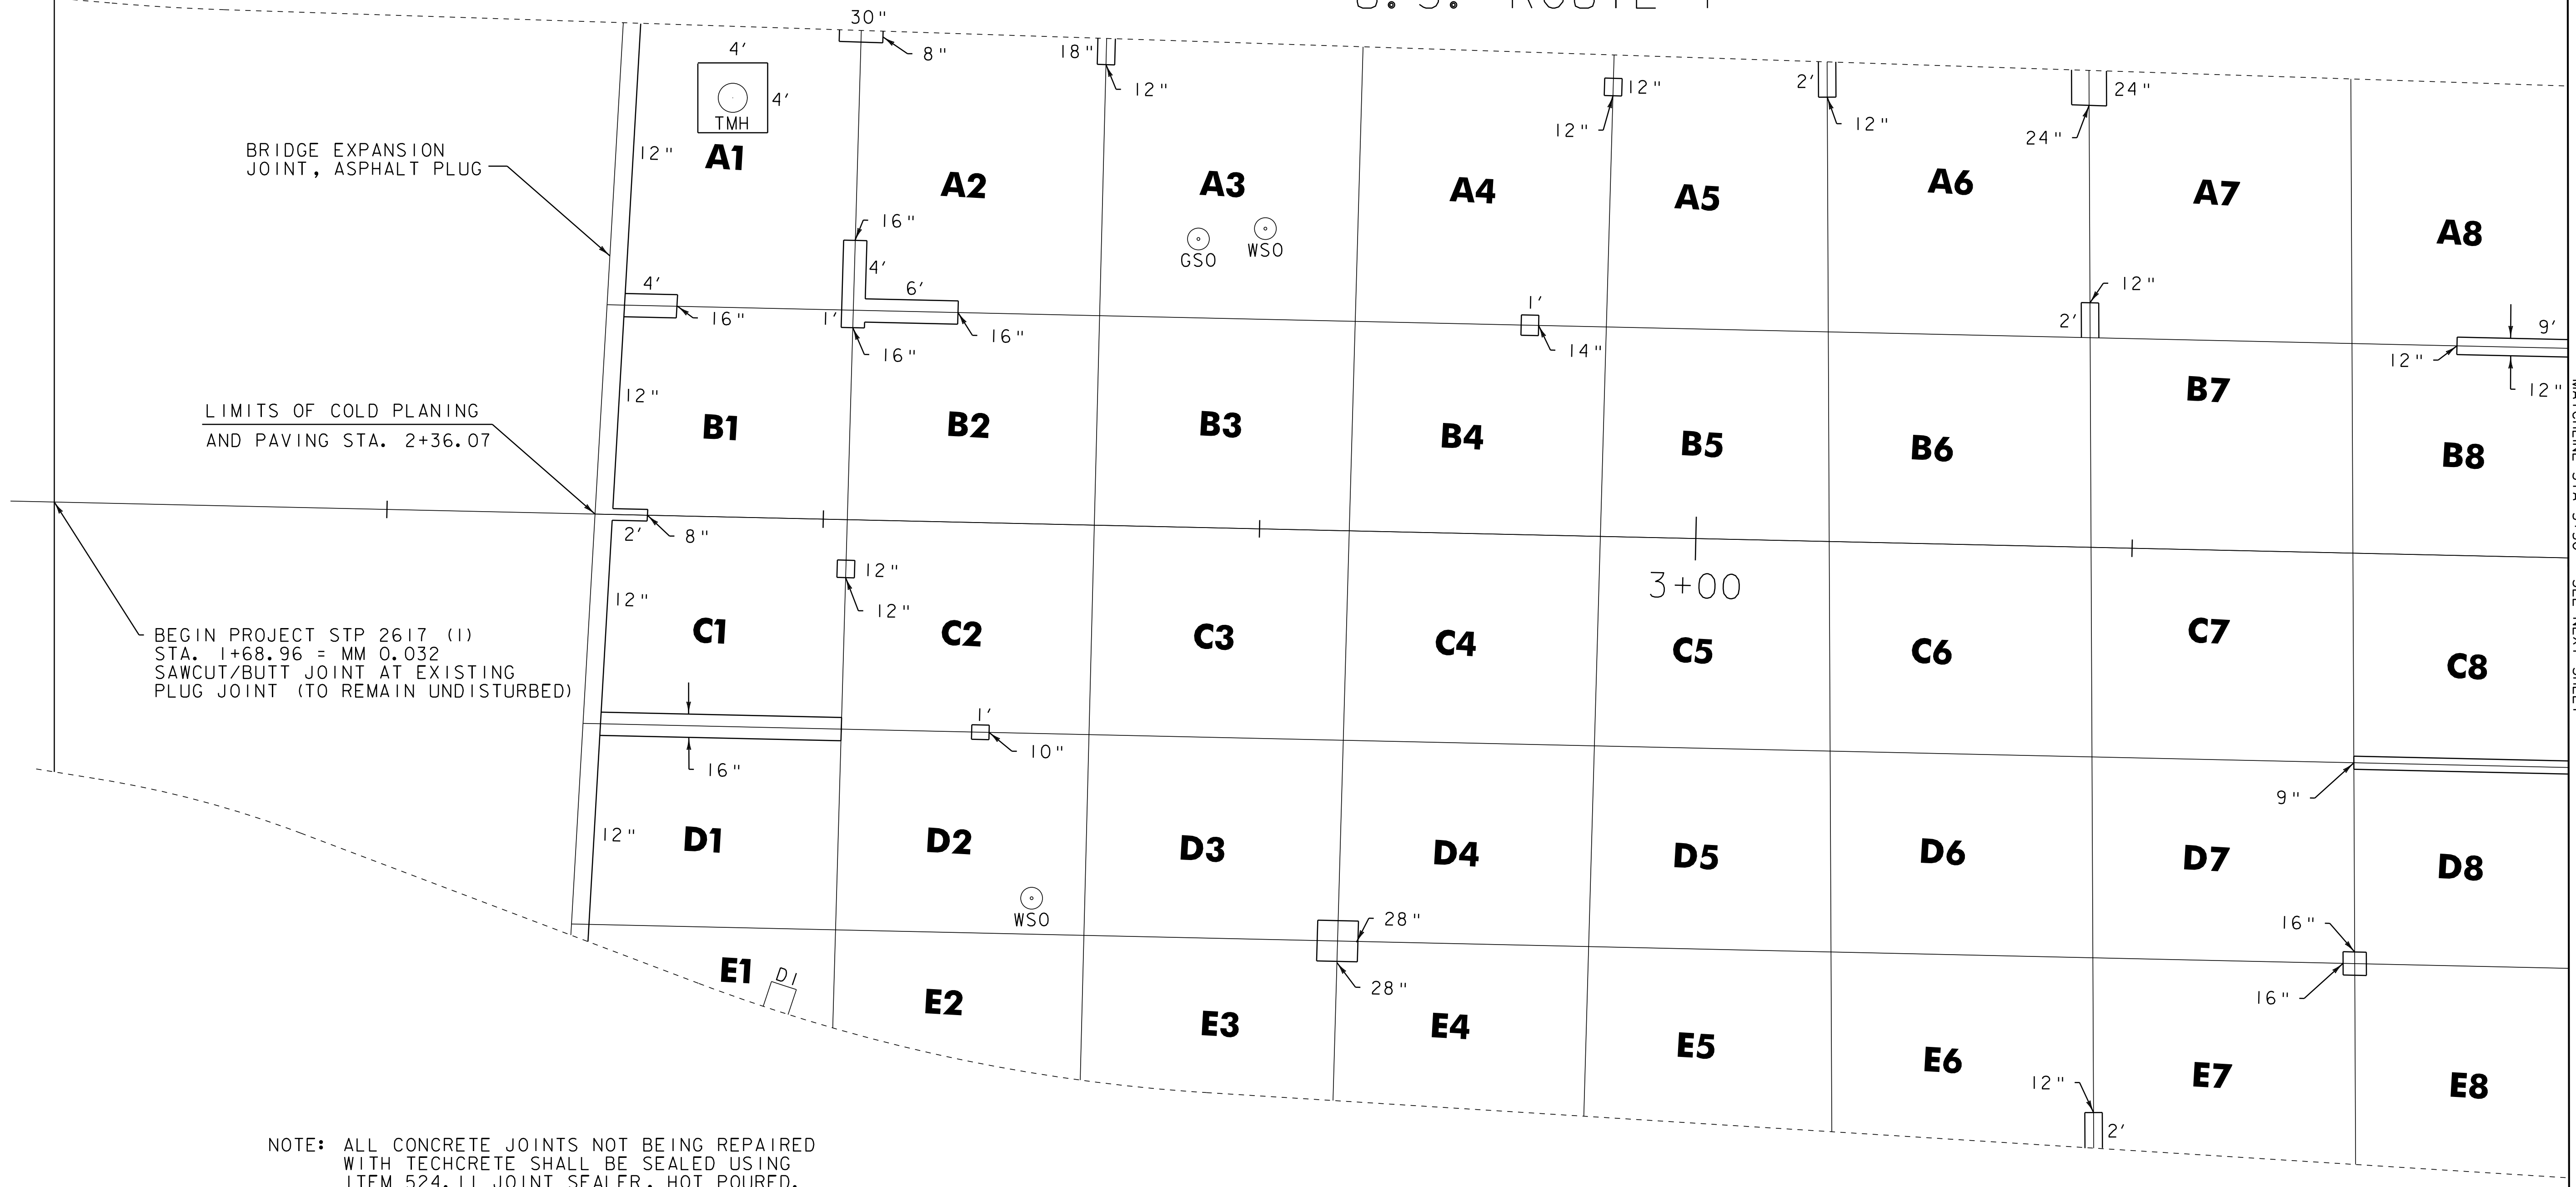

NOTE: ALL CONCRETE JOINTS NOT BEING REPAIRED WITH TECHCRETE SHALL BE SEALED USING ITEM 524.11 JOINT SEALER, HOT Poured.

DATUM	
VERTICAL	N/A
HORIZONTAL	N/A

JOINT REPAIR LOCATION PLAN #1	PROJECT NAME: WINOOSKI	PLOT DATE: 31-OCT-2011 16:46
	PROJECT NUMBER: STP 2617(1)S	DRAWN BY: SJL
	FILE NAME: 06d064.dgn	CHECKED BY: EPD
	DESIGNED BY: SJL	SHEET 70 OF 88
	PLOT FILE: 06D064_70.i	