


KEY BANK



U. S. ROUTE 7

PAVED

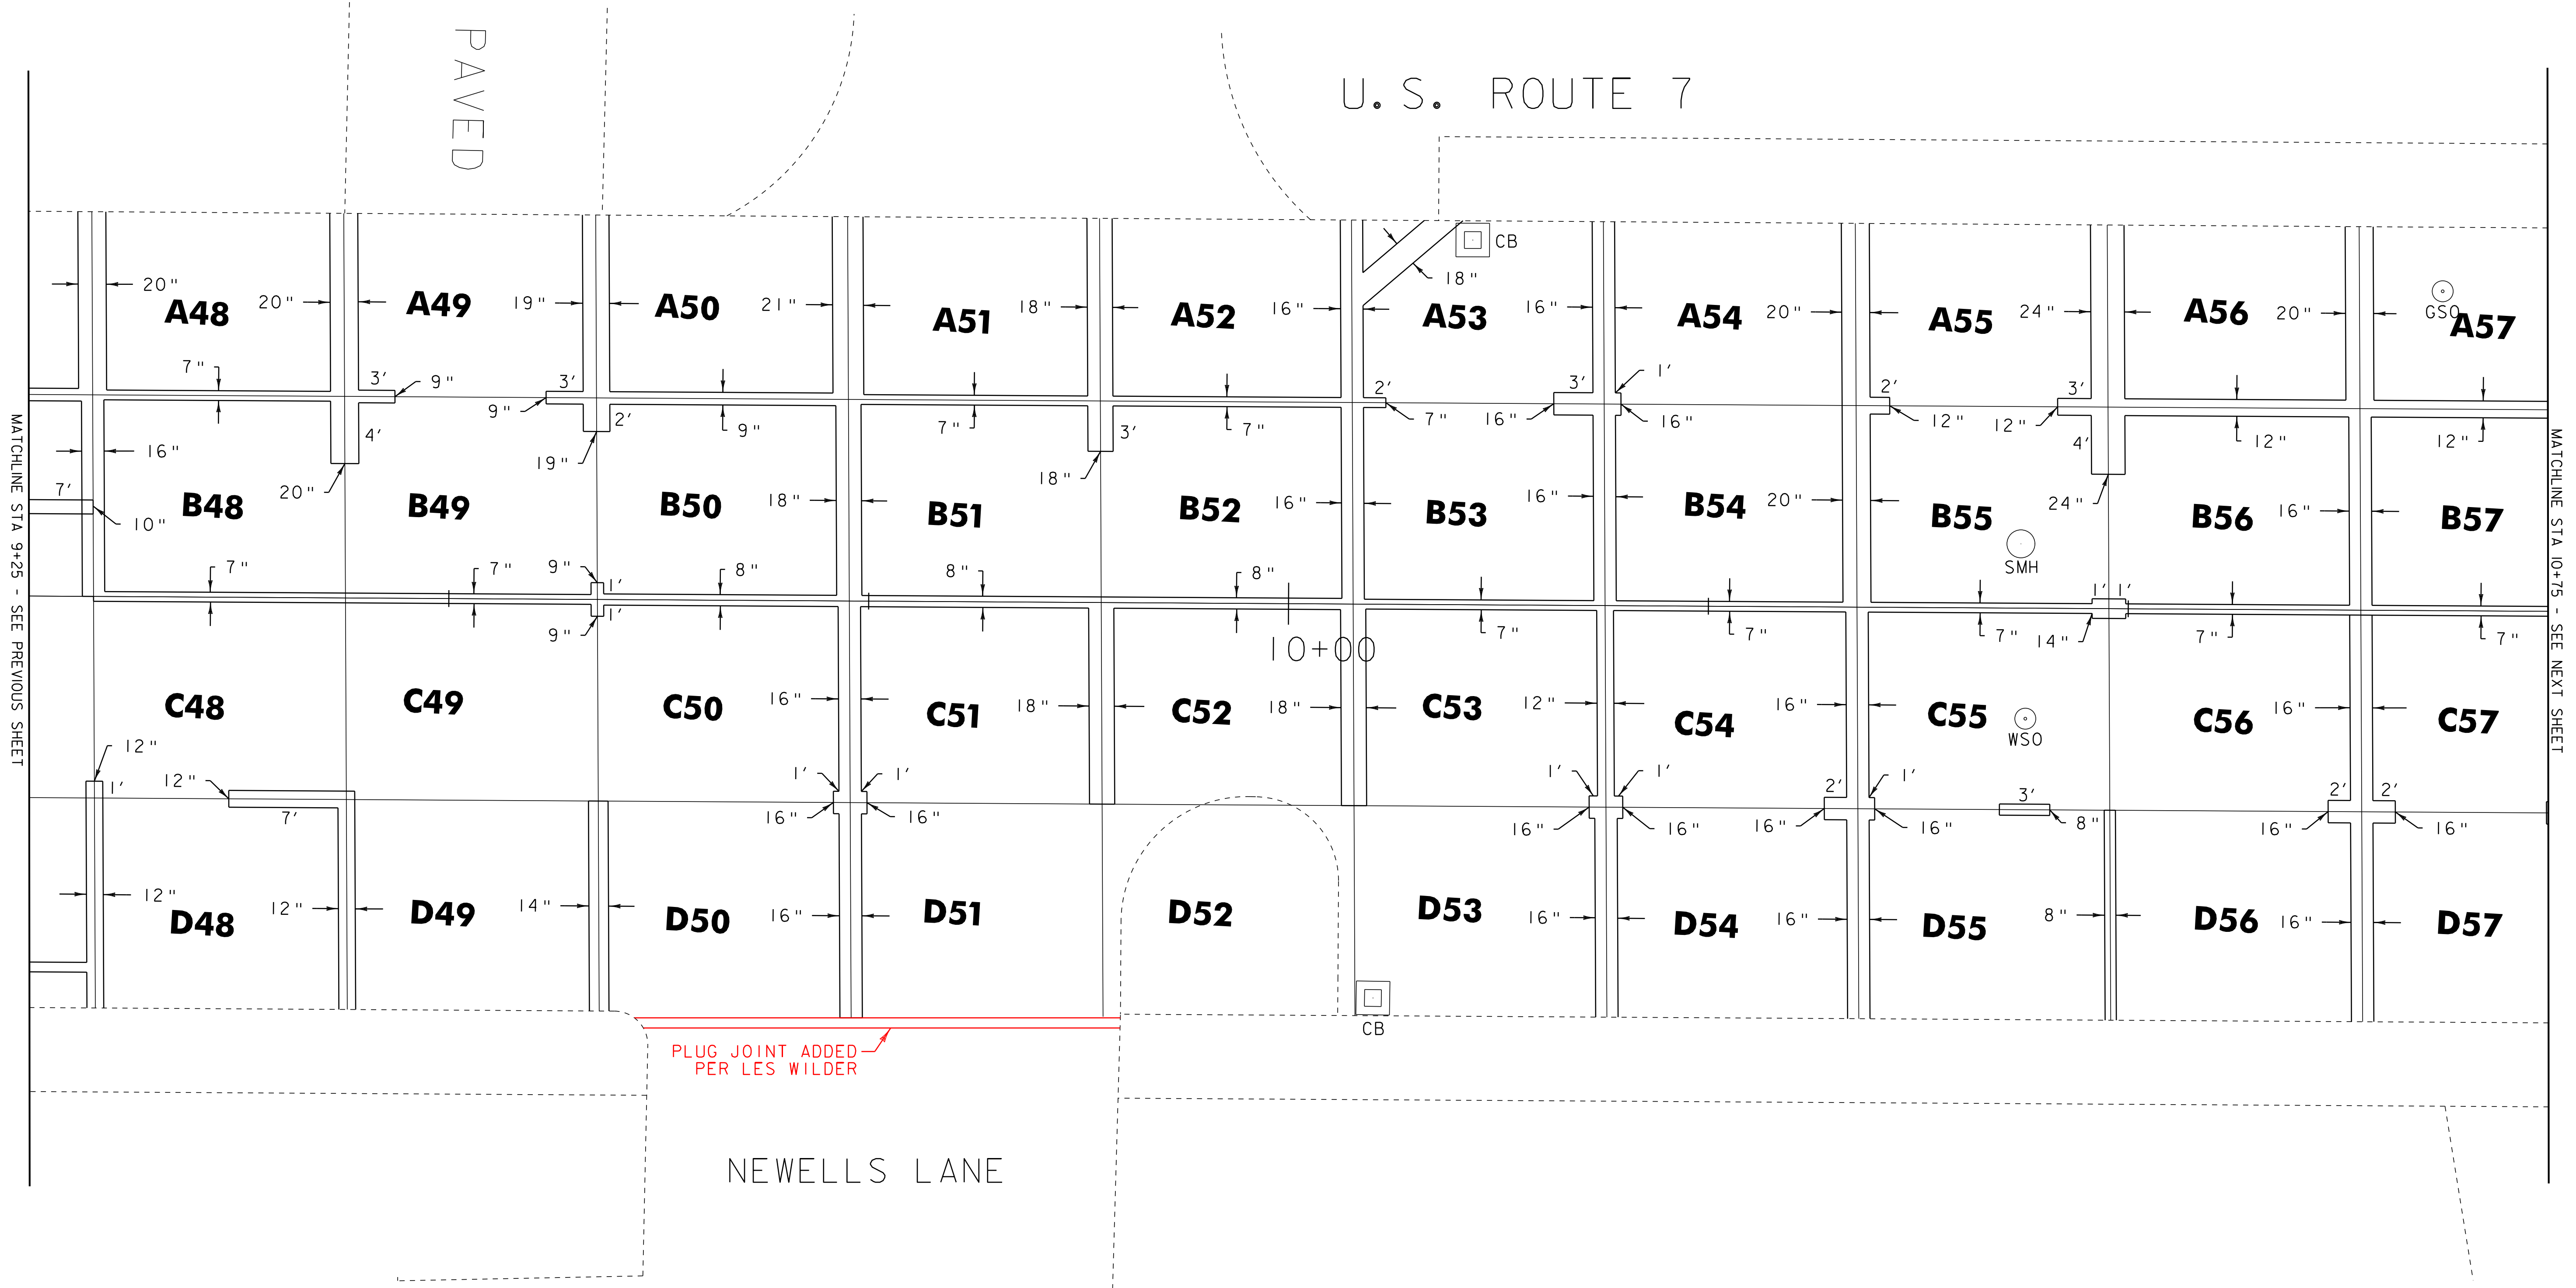

MATCHLINE STA 9+25 - SEE PREVIOUS SHEET

MATCHLINE STA 10+75 - SEE NEXT SHEET

PLUG JOINT ADDED
PER LES WILDER

NEWELLS LANE

10+00

CB

SMH

WSO

GSO

CB

DATUM	
VERTICAL	N/A
HORIZONTAL	N/A

JOINT REPAIR LOCATION PLAN #6	PROJECT NAME: WINOOSKI	PLOT DATE: 31-OCT-2011 16:47
	PROJECT NUMBER: STP 2617(I)S	DRAWN BY: SJL
	FILE NAME: 06d064.dgn	CHECKED BY: EPD
	DESIGNED BY: SJL	SHEET 75 OF 88
	PLOT FILE: 06D064_75.i	