


516.10 BRIDGE EXPANSION JOINT, ASPHALT PLUG

STA. 10+94 LT & RT = 47FT

STA. 11+52 LT & RT = 47FT

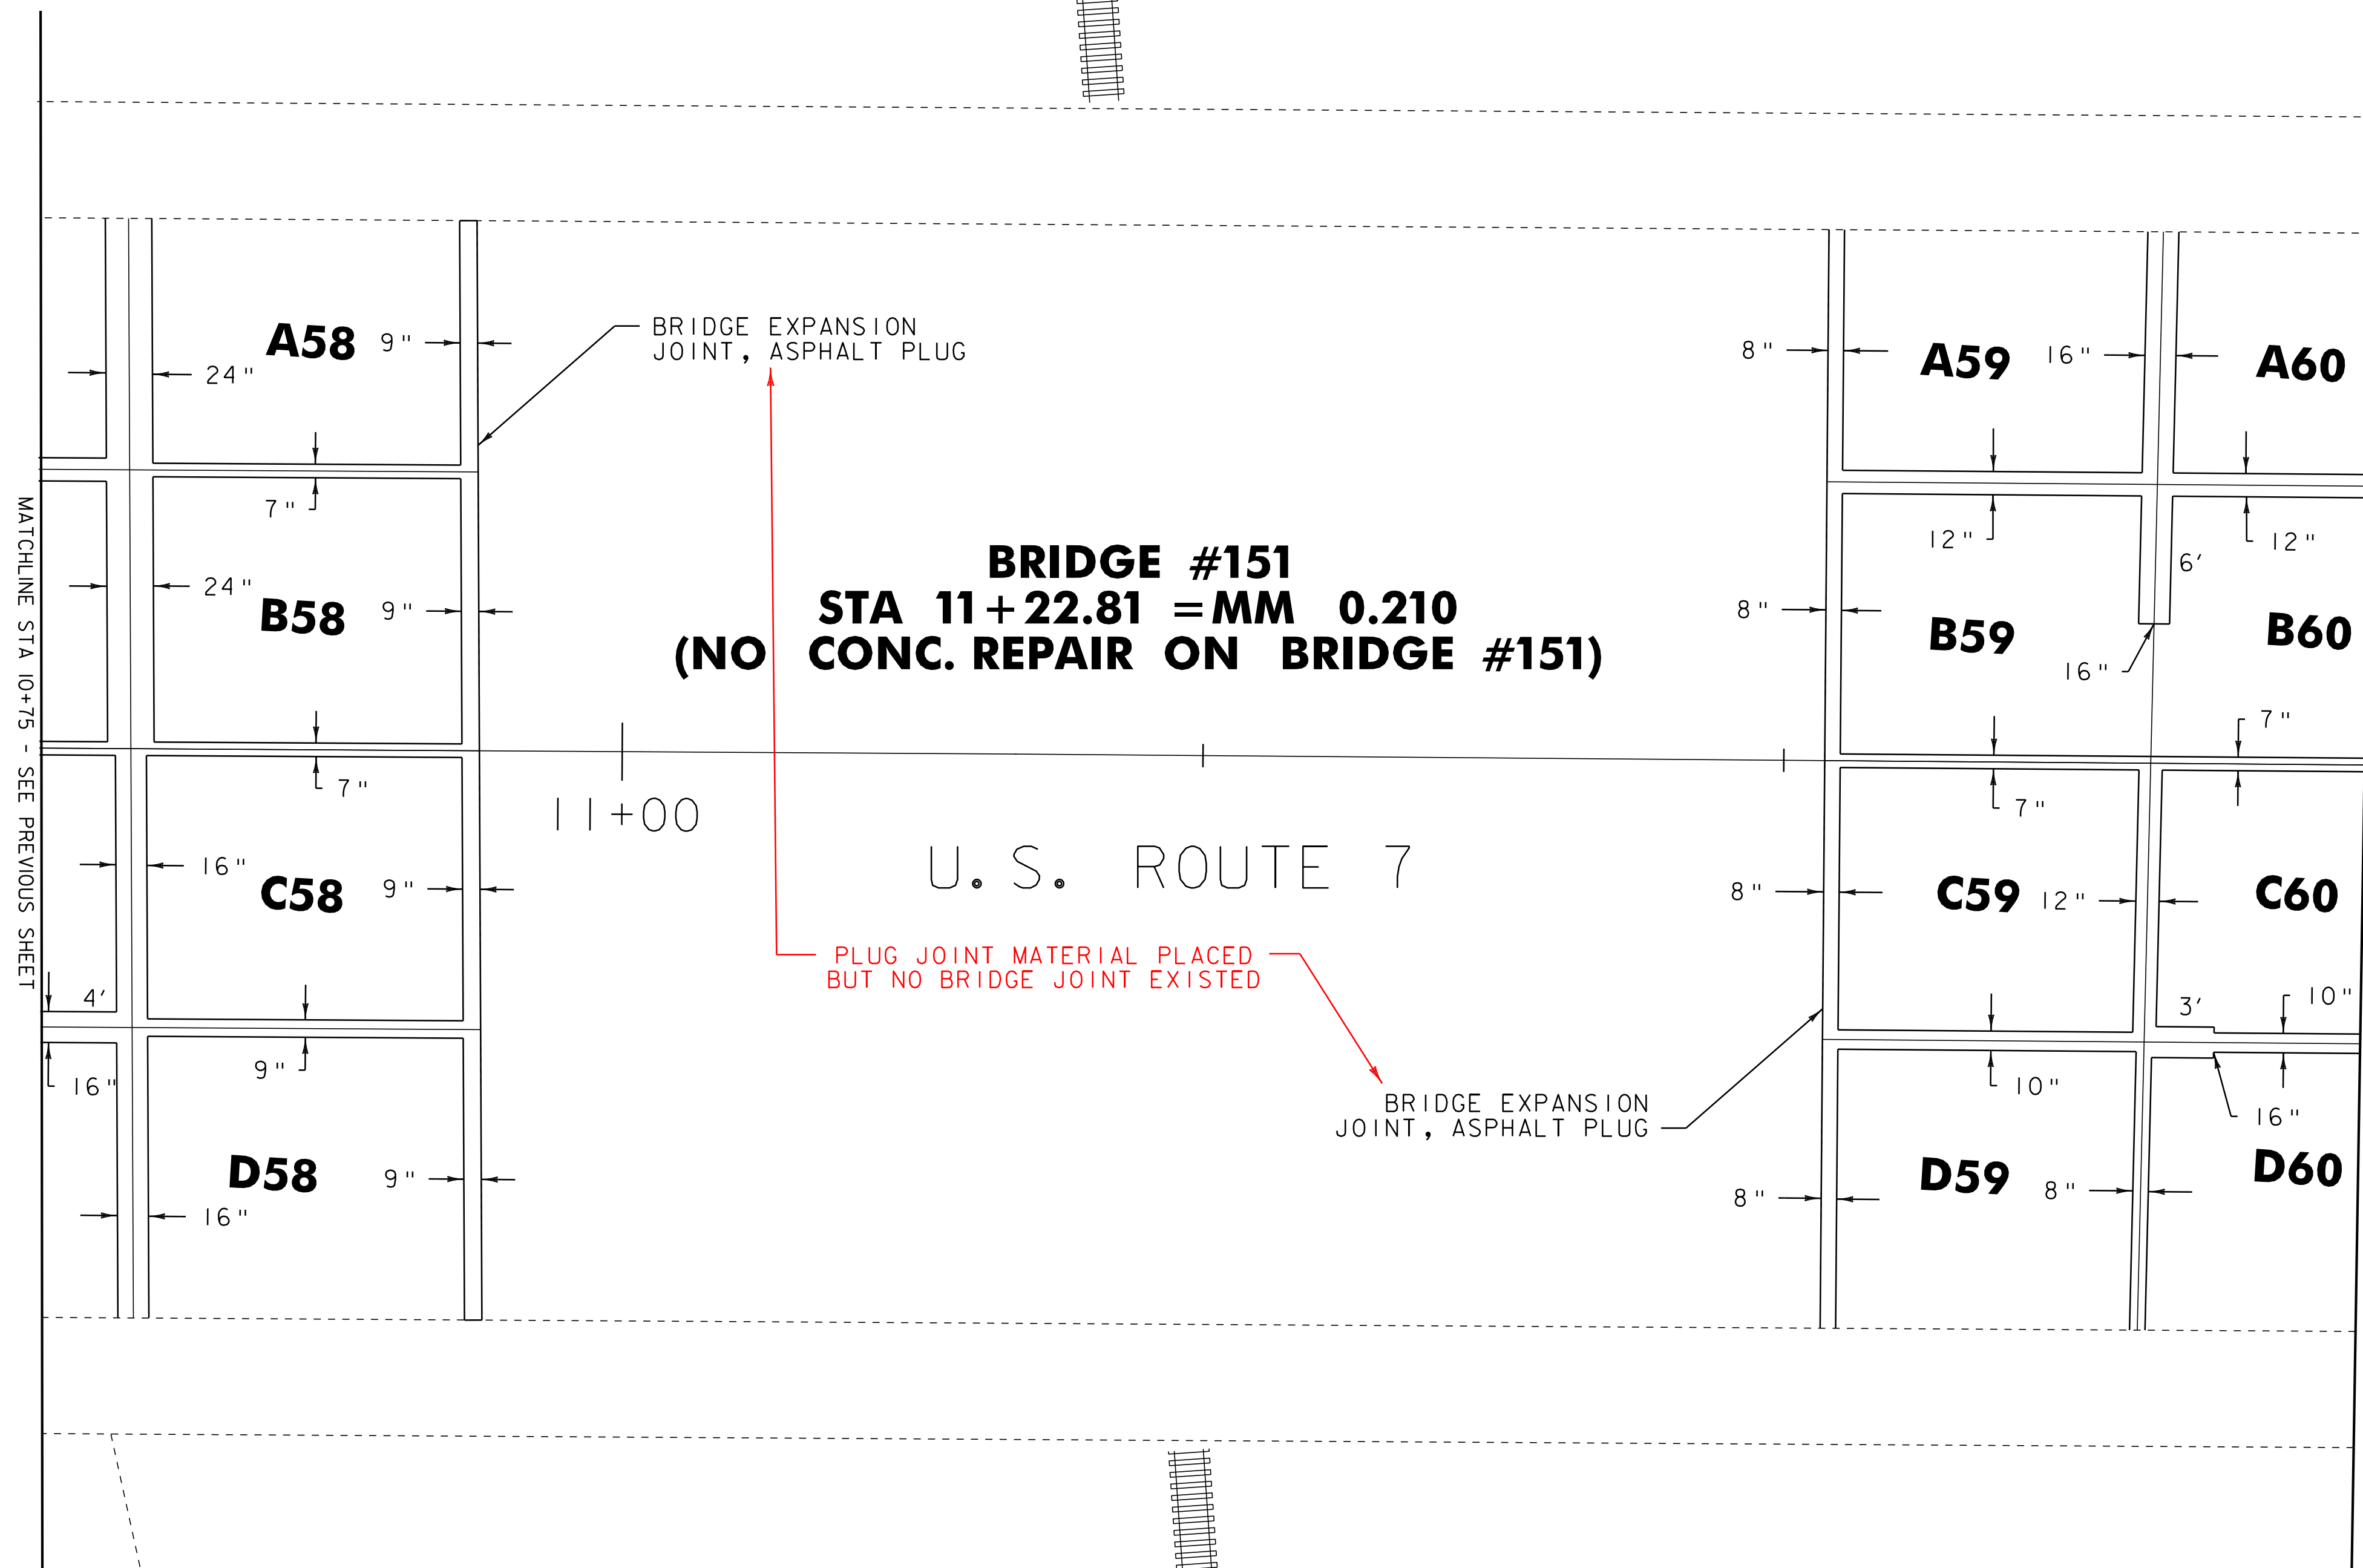

DATUM	
VERTICAL	N/A
HORIZONTAL	N/A

JOINT REPAIR LOCATION PLAN #7	PROJECT NAME: WINOOSKI	PLOT DATE: 31-OCT-2011 16:47
	PROJECT NUMBER: STP 2617(1)S	DRAWN BY: SJL
	FILE NAME: 06d064.dgn	CHECKED BY: EPD
	DESIGNED BY: SJL	SHEET 76 OF 88
	PLOT FILE: 06D064_76.i	