




U. S. ROUTE 7

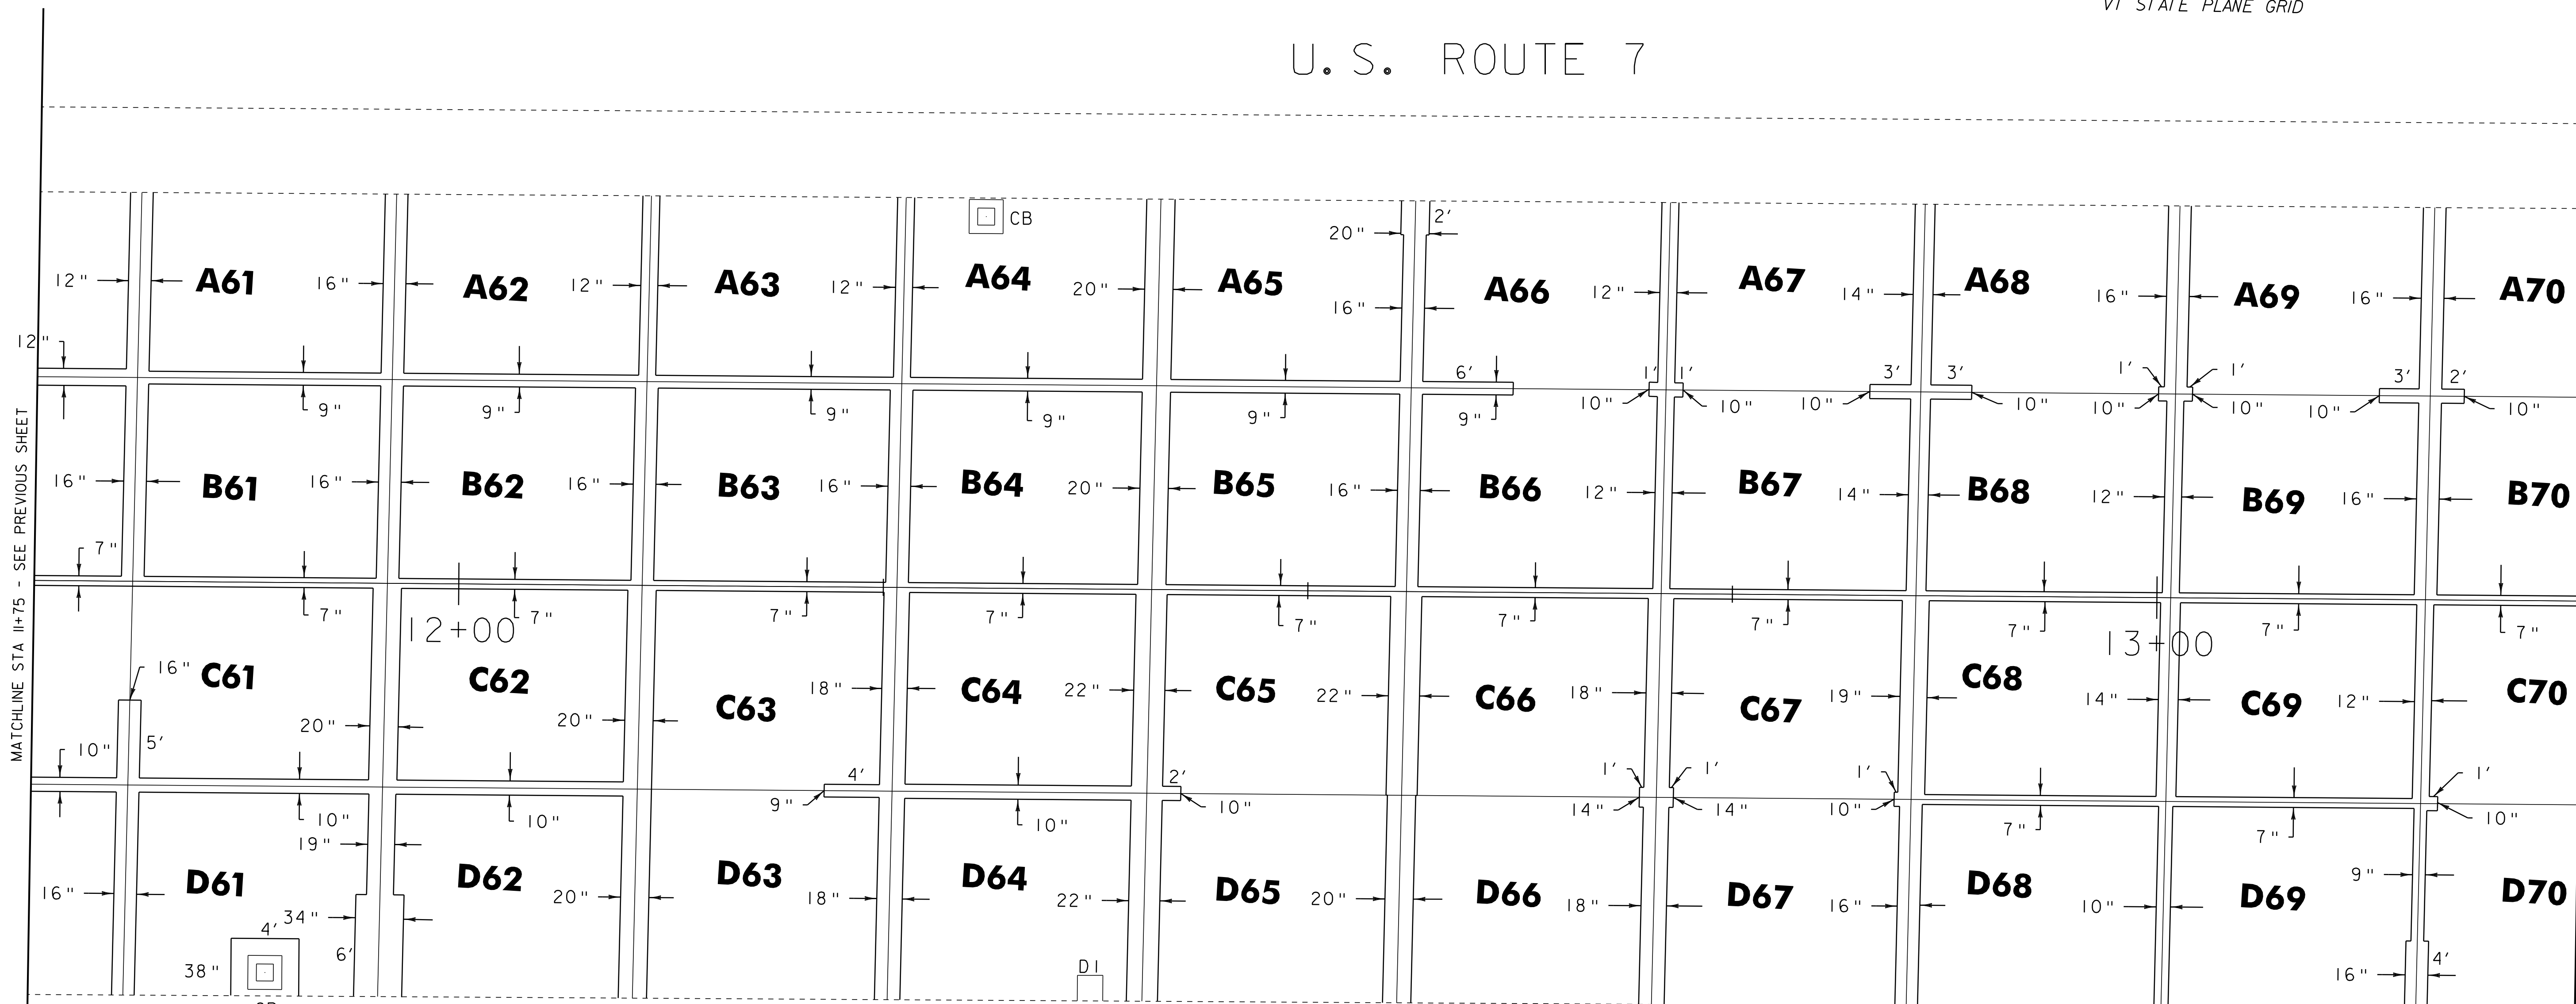

PAVED

DATUM	
VERTICAL	N/A
HORIZONTAL	N/A

JOINT REPAIR LOCATION PLAN #8	PROJECT NAME: WINOOSKI	PLOT DATE: 31-OCT-2011 16:47
	PROJECT NUMBER: STP 2617(I)S	DRAWN BY: SJL
	FILE NAME: 06d064.dgn	CHECKED BY: EPD
	DESIGNED BY: SJL	SHEET 77 OF 88
	PLOT FILE: 06D064_77.i	