


516.10 BRIDGE EXPANSION JOINT, ASPHALT PLUG

STA. 13+38 TO STA. 13+81 LT= 44FT


STA. 13+91.49 LT & RT = 56FT

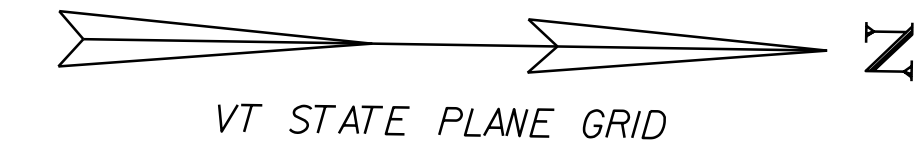

MAPLE STREET

BRIDGE EXPANSION JOINT, ASPHALT PLUG

NOT DONE

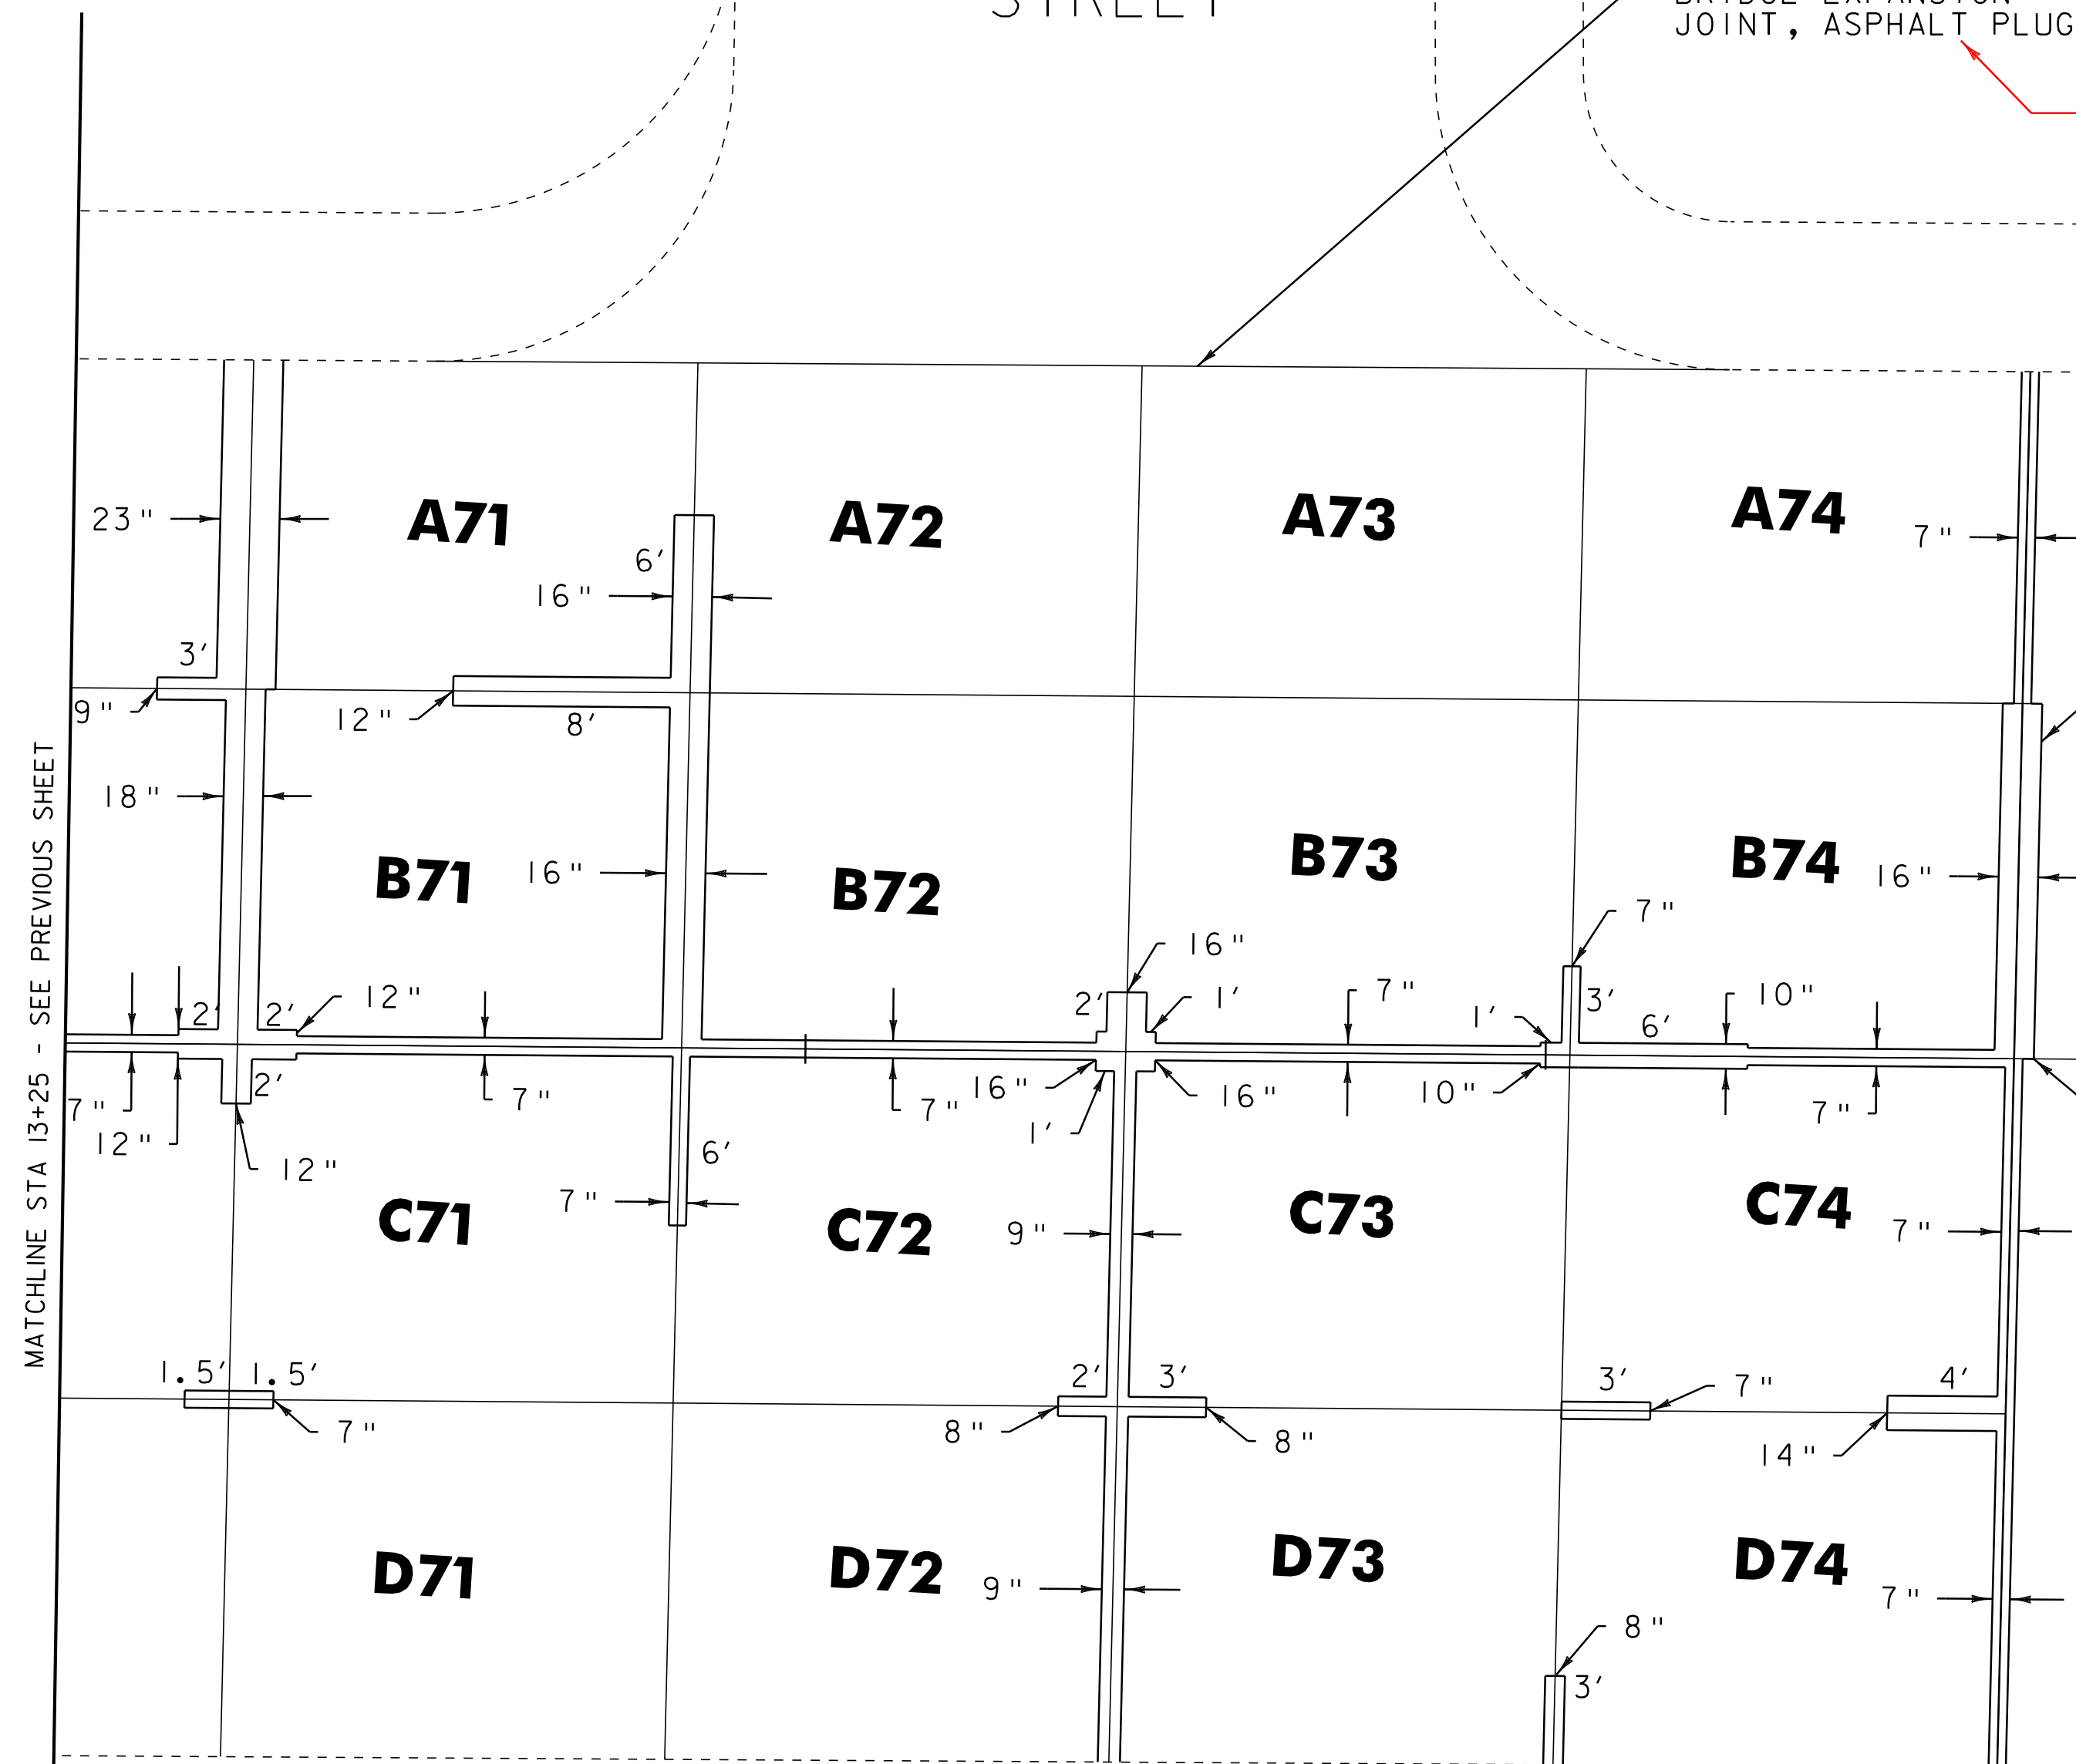

BRIDGE EXPANSION JOINT, ASPHALT PLUG

NOT DONE

BRIDGE EXPANSION JOINT, ASPHALT PLUG

END PROJECT STP 2617 (1)
STA. 13+91.49 = MM 0.264

U. S. ROUTE 7

MANSION STREET

MATCHLINE STA 13+25 - SEE PREVIOUS SHEET

DATUM	
VERTICAL	N/A
HORIZONTAL	N/A

JOINT REPAIR LOCATION PLAN #9	PROJECT NAME: WINOOSKI	PLOT DATE: 31-OCT-2011 16:47
	PROJECT NUMBER: STP 2617(1)S	DRAWN BY: SJL
	FILE NAME: 06d064.dgn	CHECKED BY: EPD
	DESIGNED BY: SJL	SHEET 78 OF 88
	PLOT FILE: 06D064_78.i	