


516.10 BRIDGE EXPANSION JOINT, ASPHALT PLUG
 WEST ALLEN STREET JOINT = 50FT

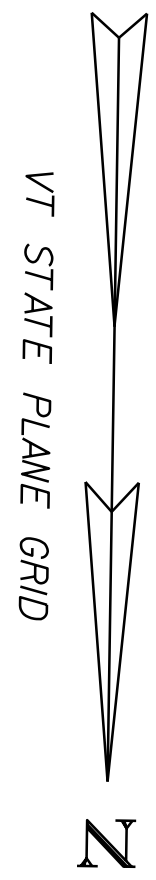

FOLLETT STREET

WEST ALLEN STREET

BRIDGE EXPANSION JOINT, ASPHALT PLUG



MATCHLINE - SEE SHEET 28

**JOINT REPAIR
 LOCATION
 PLAN #10**

PROJECT NAME: WINOOSKI
 PROJECT NUMBER: STP 2617(1)S

FILE NAME: 06d064.dgn
 PROJECT LEADER: CDL
 DESIGNED BY: SJL
 PLOT FILE: 06D064_79.i

PLOT DATE: 31-OCT-2011 16:47
 DRAWN BY: SJL
 CHECKED BY: EPD
 SHEET 79 OF 88

DATUM	
VERTICAL	N/A
HORIZONTAL	N/A