


- NOTES:
- SEE TITLE SHEET FOR BENCHMARK LOCATIONS.
 - FIELD VERIFY EDGE OF TRAVEL WAY AND PAVEMENT STRIPING PRIOR TO THE PLACEMENT OF SENSORS.

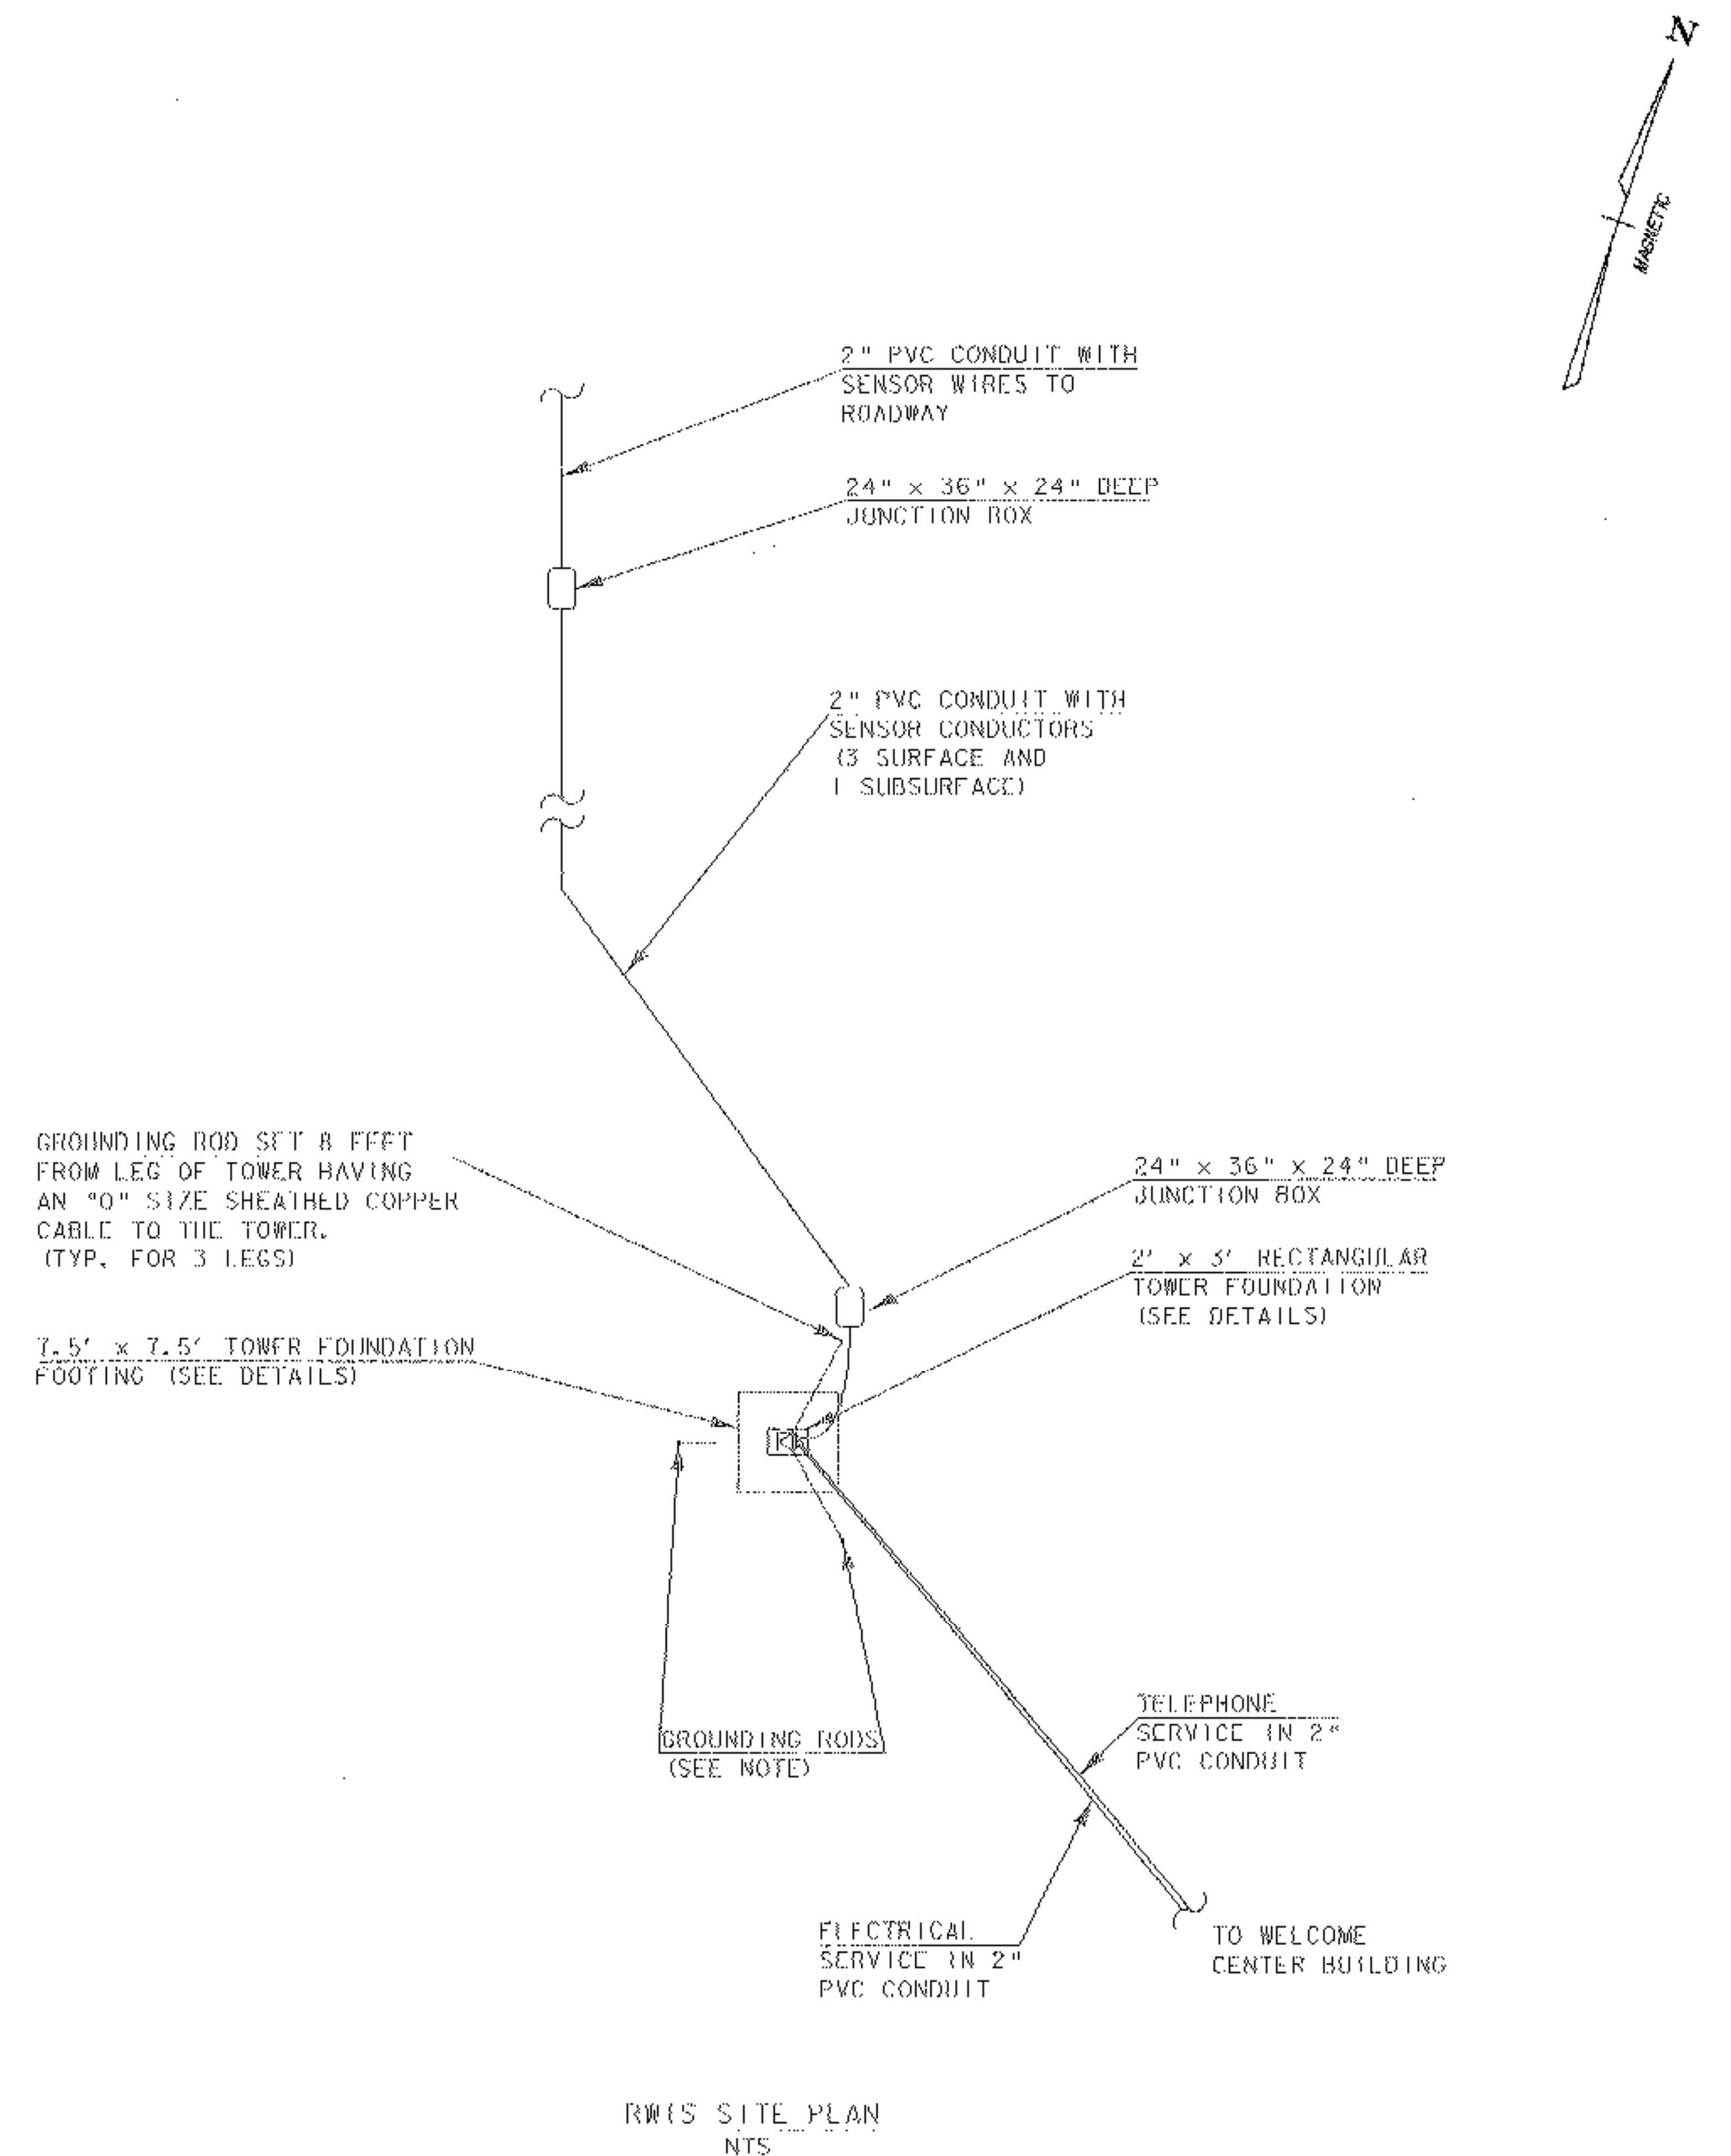

FAIR HAVEN	
PROJECT:	FAIR HAVEN: RWIS MENDON: RWIS
FILE NAME: 1001.dgn	PLOT DATE: 10-AUG-2007
PROJECT LEADER: D. GRAHAVOC	DRAWN BY: MAL
DESIGNED BY: BMB	CHECKED BY: MDL
SITE PLAN & RWIS LAYOUT	SHEET 5 OF 12