

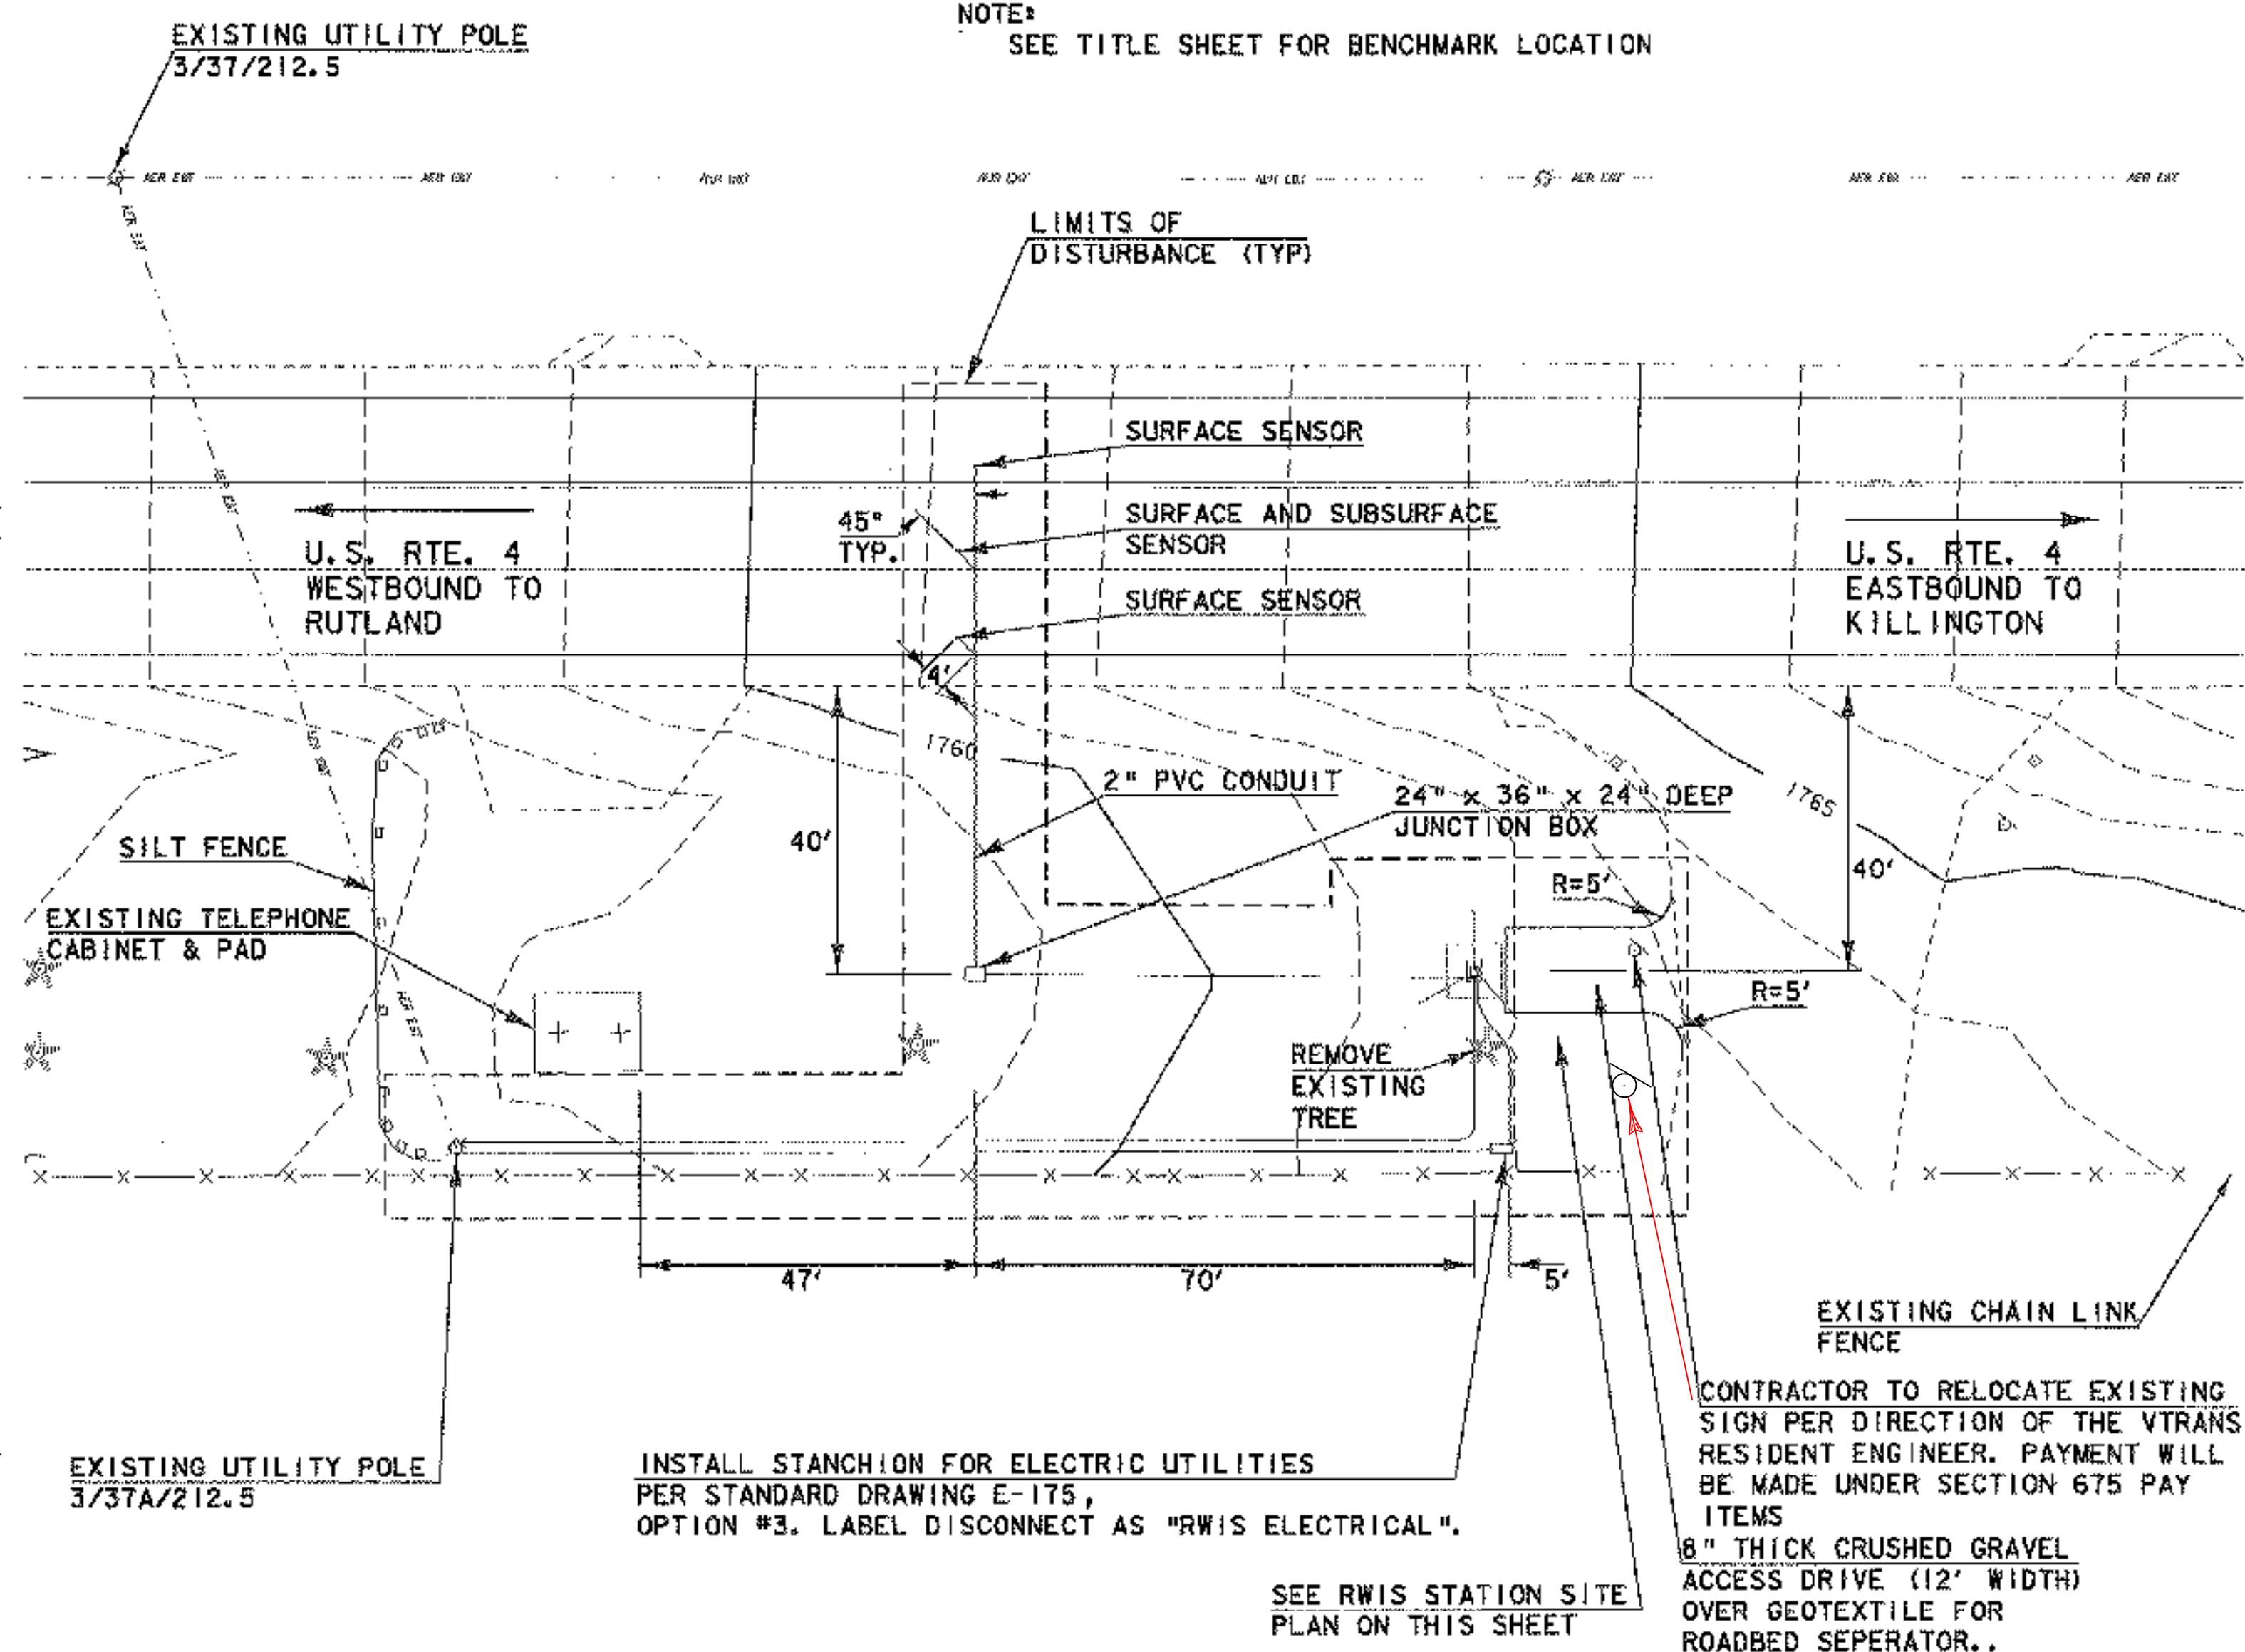


NOTE:
SEE TITLE SHEET FOR BENCHMARK LOCATION

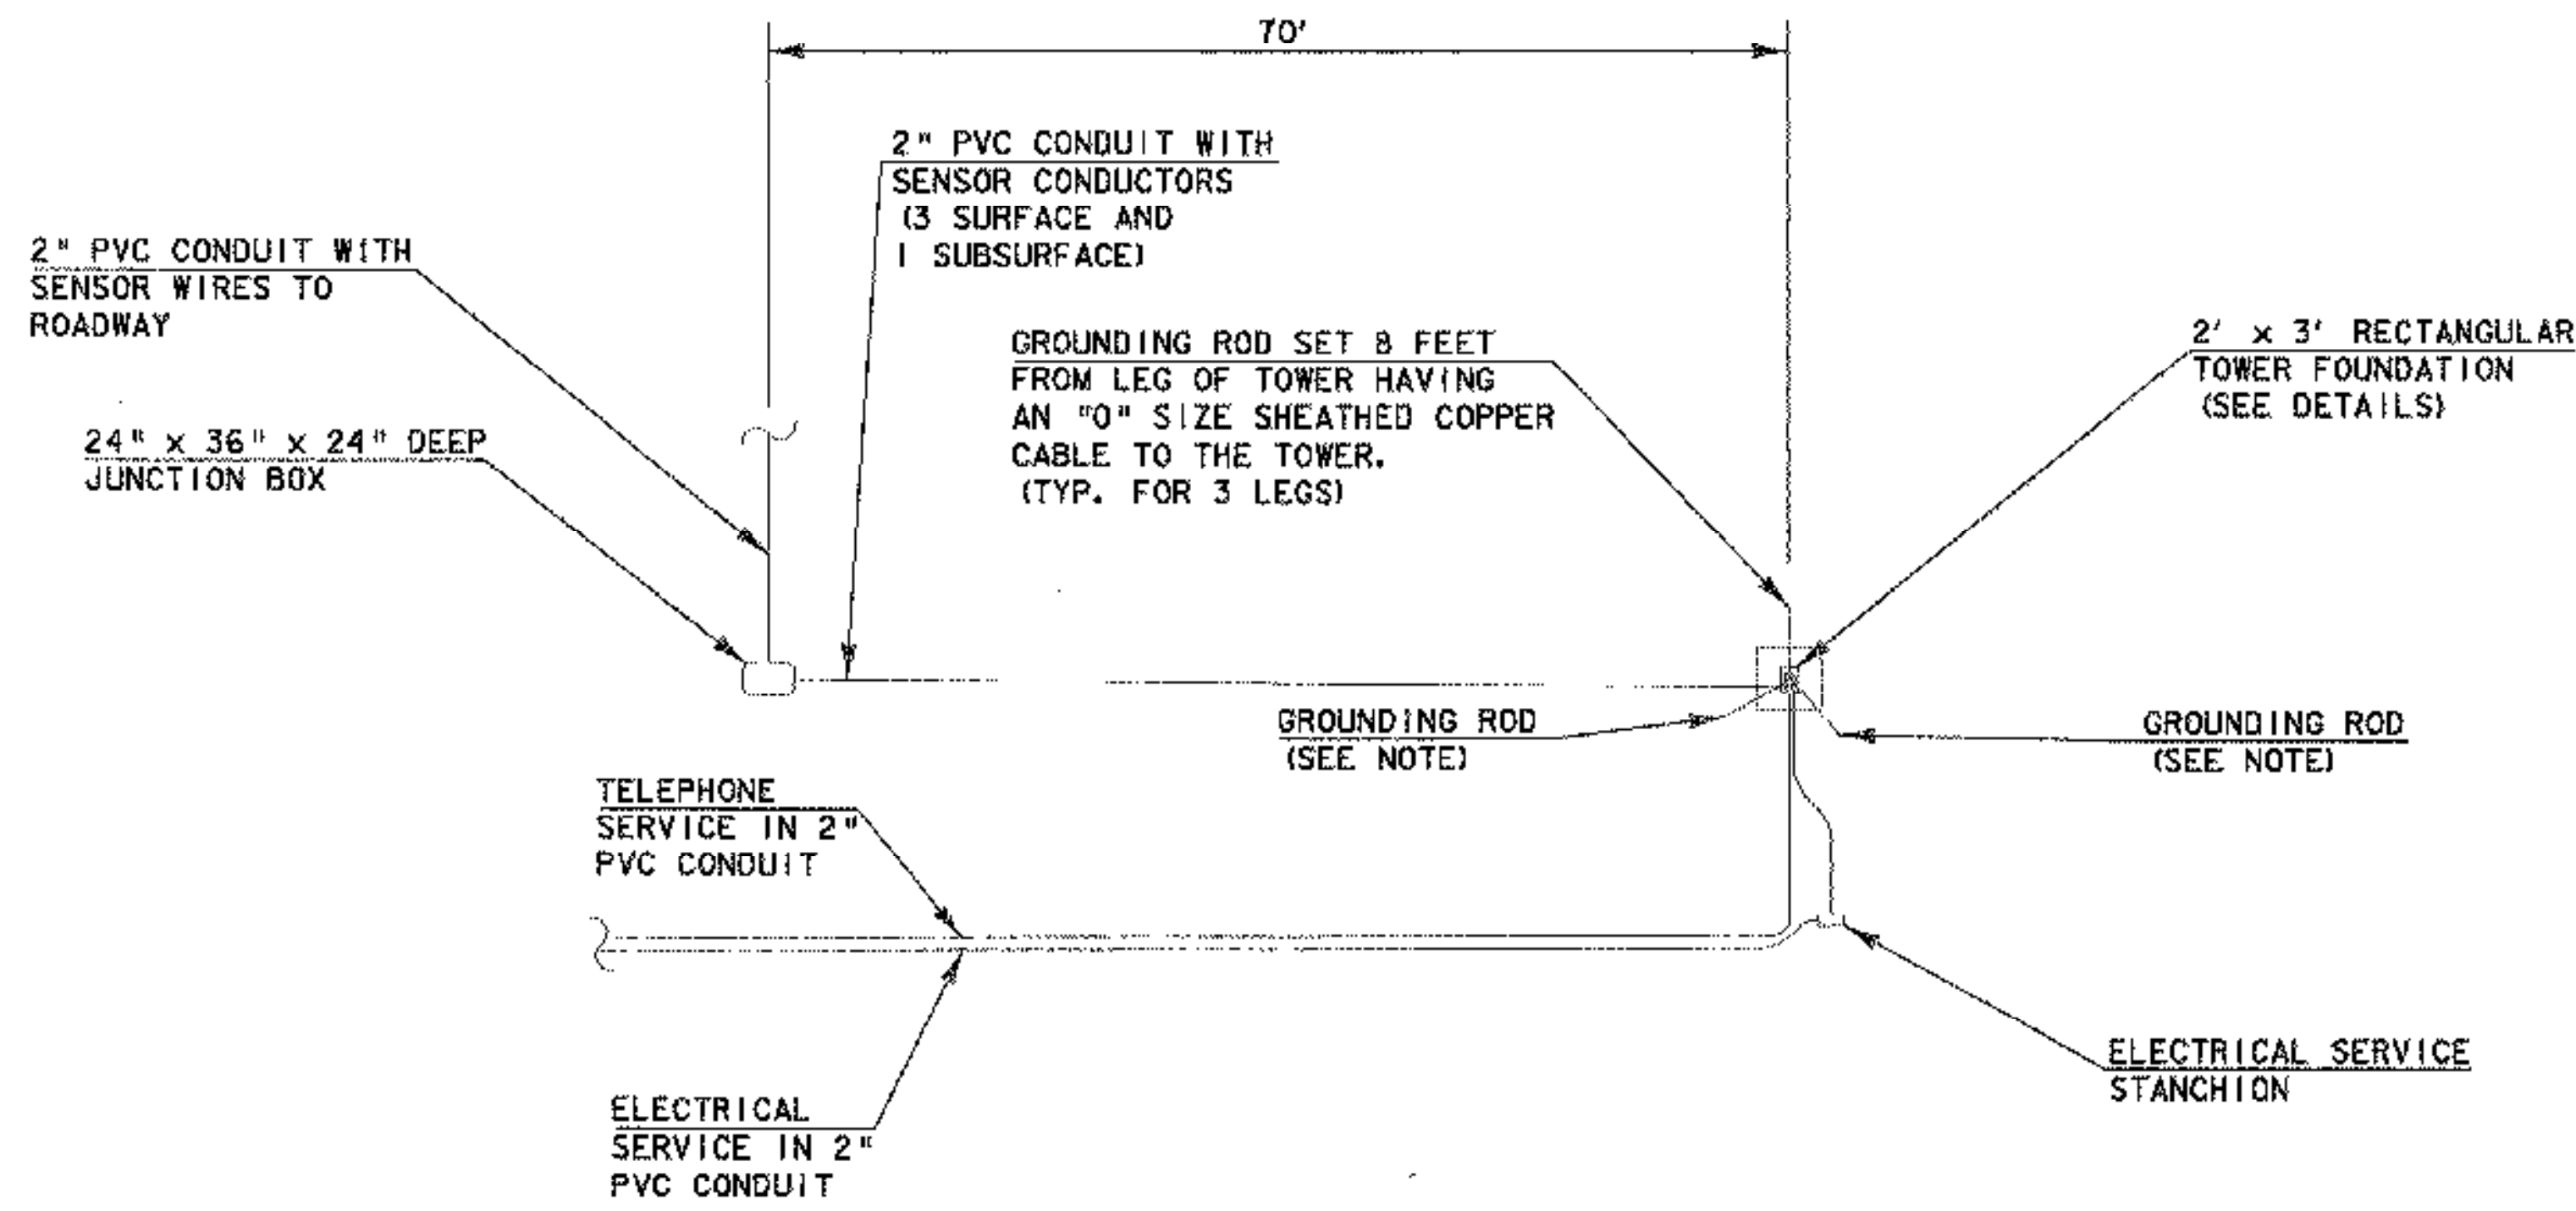

PROPOSED MENDON SITE PLAN
SCALE 1" = 20'

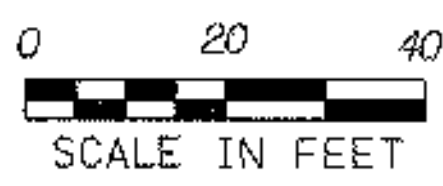

RWIS SITE PLAN
NTS

MENDON

PROJECT:	FAIR HAVEN: RWIS MENDON: RWIS	
FILE NAME:	1a02.dgn	PLOT DATE: 10-AUG-2007
PROJECT LEADER:	D. GRAHAVOC	DRAWN BY: MAL
DESIGNED BY:	BMB	CHECKED BY: MOL
SITE PLAN		SHEET 9 OF 12