

INDEX OF SHEETS

- 1. TITLE SHEET
- 2. PROJECT TYPICAL SHEET
- 3. QUANTITY SHEET
- 4. PROJECT LOCATION SHEET
- 5-6. GENERIC PAVEMENT MARKING DETAILS
- 7. CONSTRUCTION APPROACH SIGNING SHEET

STANDARDS

E-100	CONSTRUCTION APPROACH SIGNS	01/02/04
E-101	CONSTRUCTION SIGN DETAILS	05/30/03
E-102	CONSTRUCTION SIGN DETAILS	06/30/03
E-102A	CONSTRUCTION SIGN DETAILS	05/01/04
E-103	MAINLINE TRAFFIC CONTROL DIVIDED HIGHWAY ONE LANE CLOSED	03/01/04
E-105	TRAFFIC CONTROL FOR CONSTRUCTION VEHICLE U-TURNS ON DIVIDED HIGHWAY	05/01/04
E-106	TRAFFIC CONTROL - MISCELLANEOUS DETAILS	03/01/04
E-107A	BREAKAWAY BARRICADE DETAILS	08/08/95
E-110	MAJOR MAINTENANCE OPERATION-LANE CLOSURE	08/08/95

STATE OF VERMONT
AGENCY OF TRANSPORTATION



PROPOSED IMPROVEMENT

STATEWIDE
IM RUTF(13)


I-91 NORTHBOUND LANE

WORK TO BE PERFORMED UNDER THIS PROJECT INCLUDES CORRECTION OF RUTTED AREAS BY COLD PLANING AND PAVING, STRIPING, AND APPROPRIATE TRAFFIC CONTROL OF THE EXISTING INTERSTATE HIGHWAY,

PROJECT LOCATIONS

I-91
 161.018 165.202
 NB MM 161.00 - 165.20 BARTON-COVENTRY
 NB MM 167.20 - 168.90 COVENTRY-DERBY
 167.208 168.90

PROJECT LENGTH 31 152 L.F. = 5.90 MILES

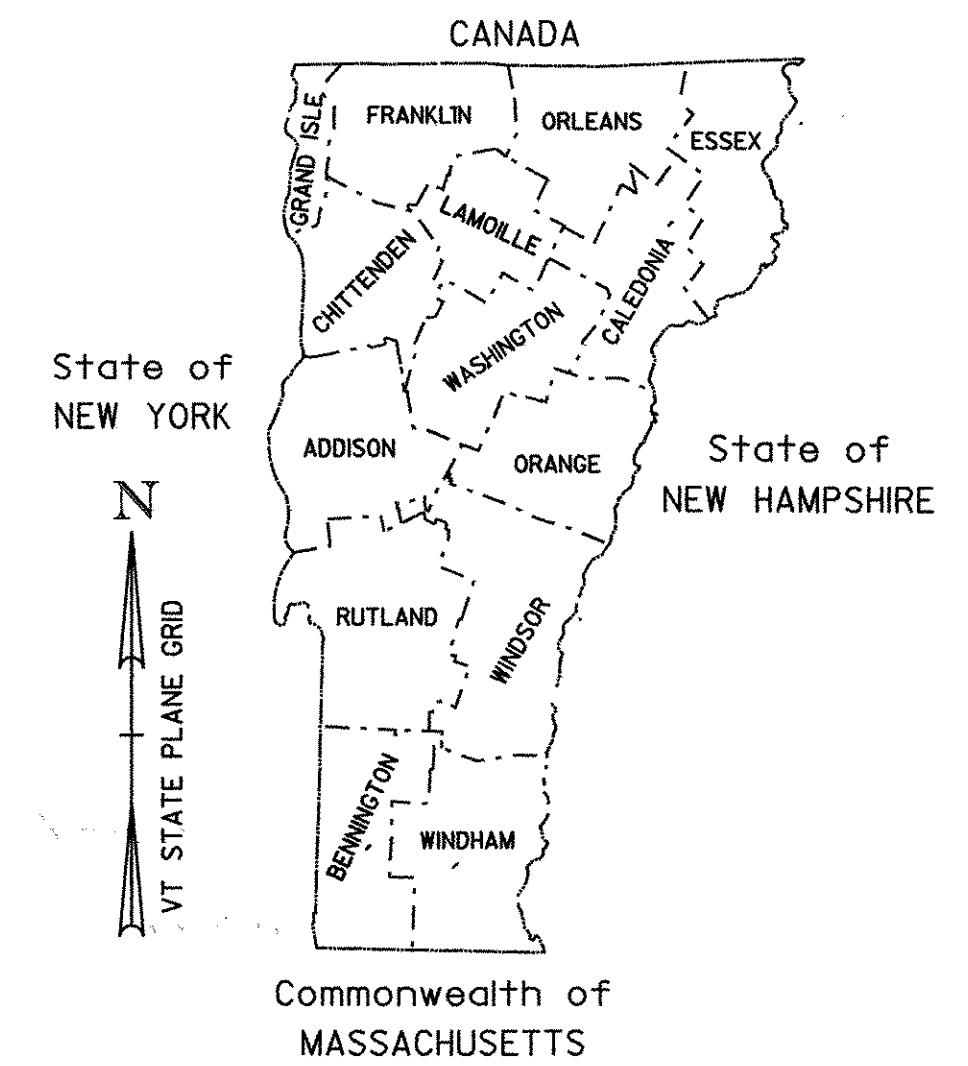

RECORD PLANS

CONTRACTOR: PIKE INDUSTRIES, INC. - BERLIN, VT

RESIDENT ENGINEER: DOUG BUMPS

CONSTRUCTION BEGAN: SEPTEMBER 17, 2007

CONSTRUCTION COMPLETE: OCTOBER 17, 2007

RECORD PLANS BY: DOUG BUMPS & C. PIERCE

I HEREBY CERTIFY THAT ALL THE CONSTRUCTION REQUIRED BY THIS SET OF DRAWINGS HAS BEEN ACCOMPLISHED AS INDICATED HEREIN.

BY Douglas Bumps RESIDENT ENGINEER

DATE 3/1/08

NOTE: Any further information concerning final quantities, amounts or other details relative to this project may be found at Central Files in the electronic archives.

CONVENTIONAL SIGNS

COUNTY LINE	----
TOWN LINE	----
LIMITS OF ACCESS	—○—○—○—○—
POINT OF ACCESS	X
FENCE LINE	—x—x—x—x—
STONE WALL	○○○○○○○○○○○○○○○○
TRAVELED WAY	----
GUARD RAIL	—○—○—○—○—
RAILROAD	+
SURVEY LINE	+
CULVERT	— — — — —
POWER POLE	⊕
TELEPHONE POLE	⊕
TREES	⊗
CONTROL OF ACCESS	///
PROPERTY LINE	----
R.O.W. TAKING LINE	—SR—
SLOPE RIGHTS	—○—○—○—○—
TOP OF CUT	—△—△—△—△—
TOE OF SLOPE	—○—○—○—○—

DATUM

VERTICAL	N/A
HORIZONTAL	N/A

THESE PLANS ARE SUBJECT TO SUCH ENGINEERING CHANGES AS MAY BE REQUIRED BY THE FEDERAL HIGHWAY ADMINISTRATION OR THE DIRECTOR OF PROGRAM DEVELOPMENT. CONSTRUCTION IS TO BE CARRIED ON IN ACCORDANCE WITH THESE PLANS AND THE STANDARD SPECIFICATIONS FOR CONSTRUCTION DATED 2006, AS APPROVED BY THE FEDERAL HIGHWAY ADMINISTRATION ON JUNE 15, 2006 FOR USE ON THIS PROJECT, INCLUDING ALL SUBSEQUENT REVISIONS AND SUCH REVISED SPECIFICATIONS AND SPECIAL PROVISIONS AS ARE INCORPORATED IN THESE PLANS.

APPROVED [Signature] DATE 3/20/07
 DIRECTOR OF PROGRAM DEVELOPMENT

DEPARTMENT OF TRANSPORTATION
 FEDERAL HIGHWAY ADMINISTRATION

APPROVED [Signature] DATE 4-5-07
 DIVISION ADMINISTRATOR

PROJECT STATEWIDE IM RUTF(13)

SHEET 1 OF 7 SHEETS