



INTERSTATE TYPICAL PAVEMENT MARKINGS

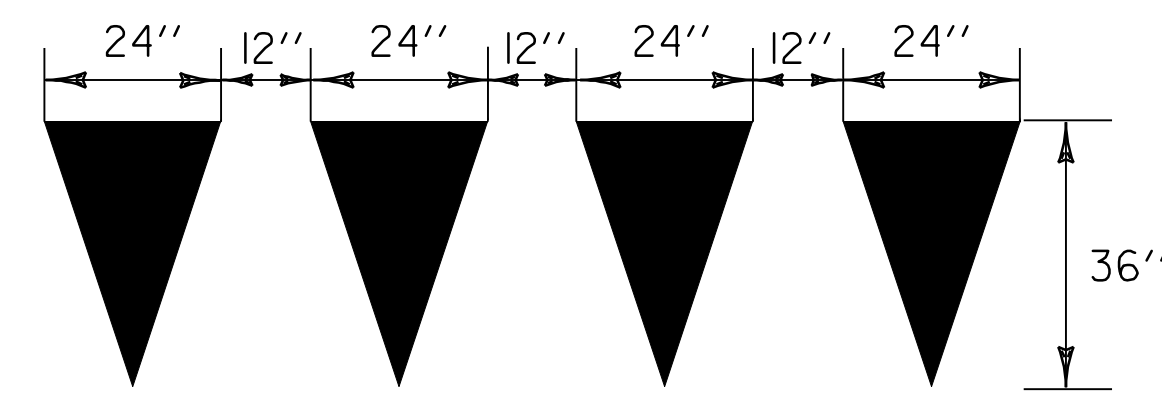


YIELD LINE DETAILS

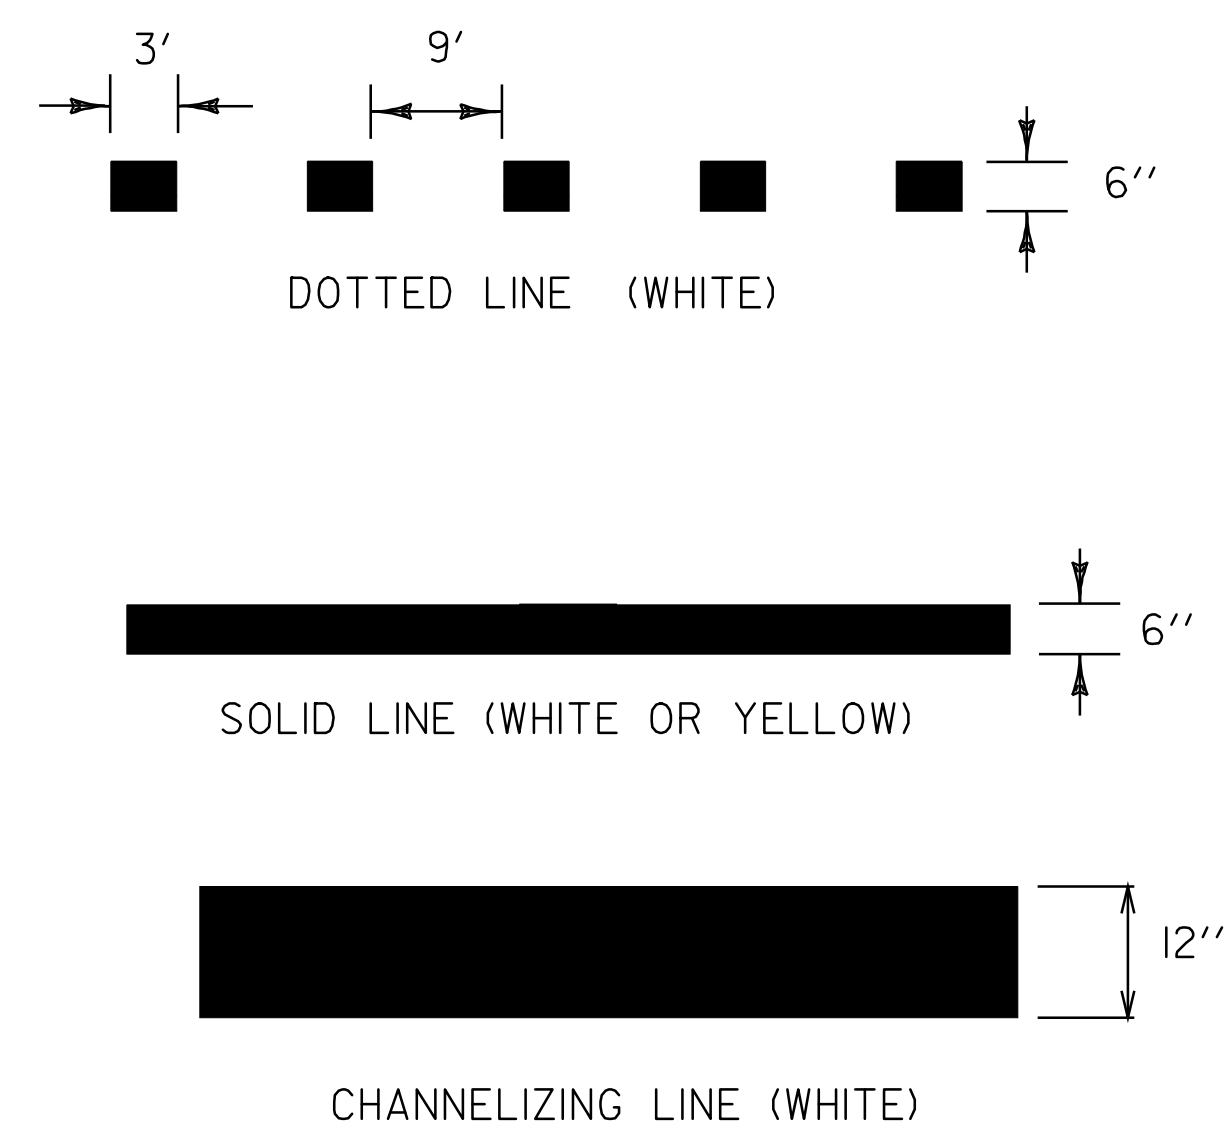

PAVEMENT MARKING LINE DETAILS

NOTE: DOTTED LINE, CHANNELIZING LINE AND YIELD MARKINGS TO BE INSTALLED ONLY AT THE DIRECTION OF THE RESIDENT ENGINEER. YELLOW LINE IS NOT REQUIRED ON THIS PROJECT.

NOT TO SCALE

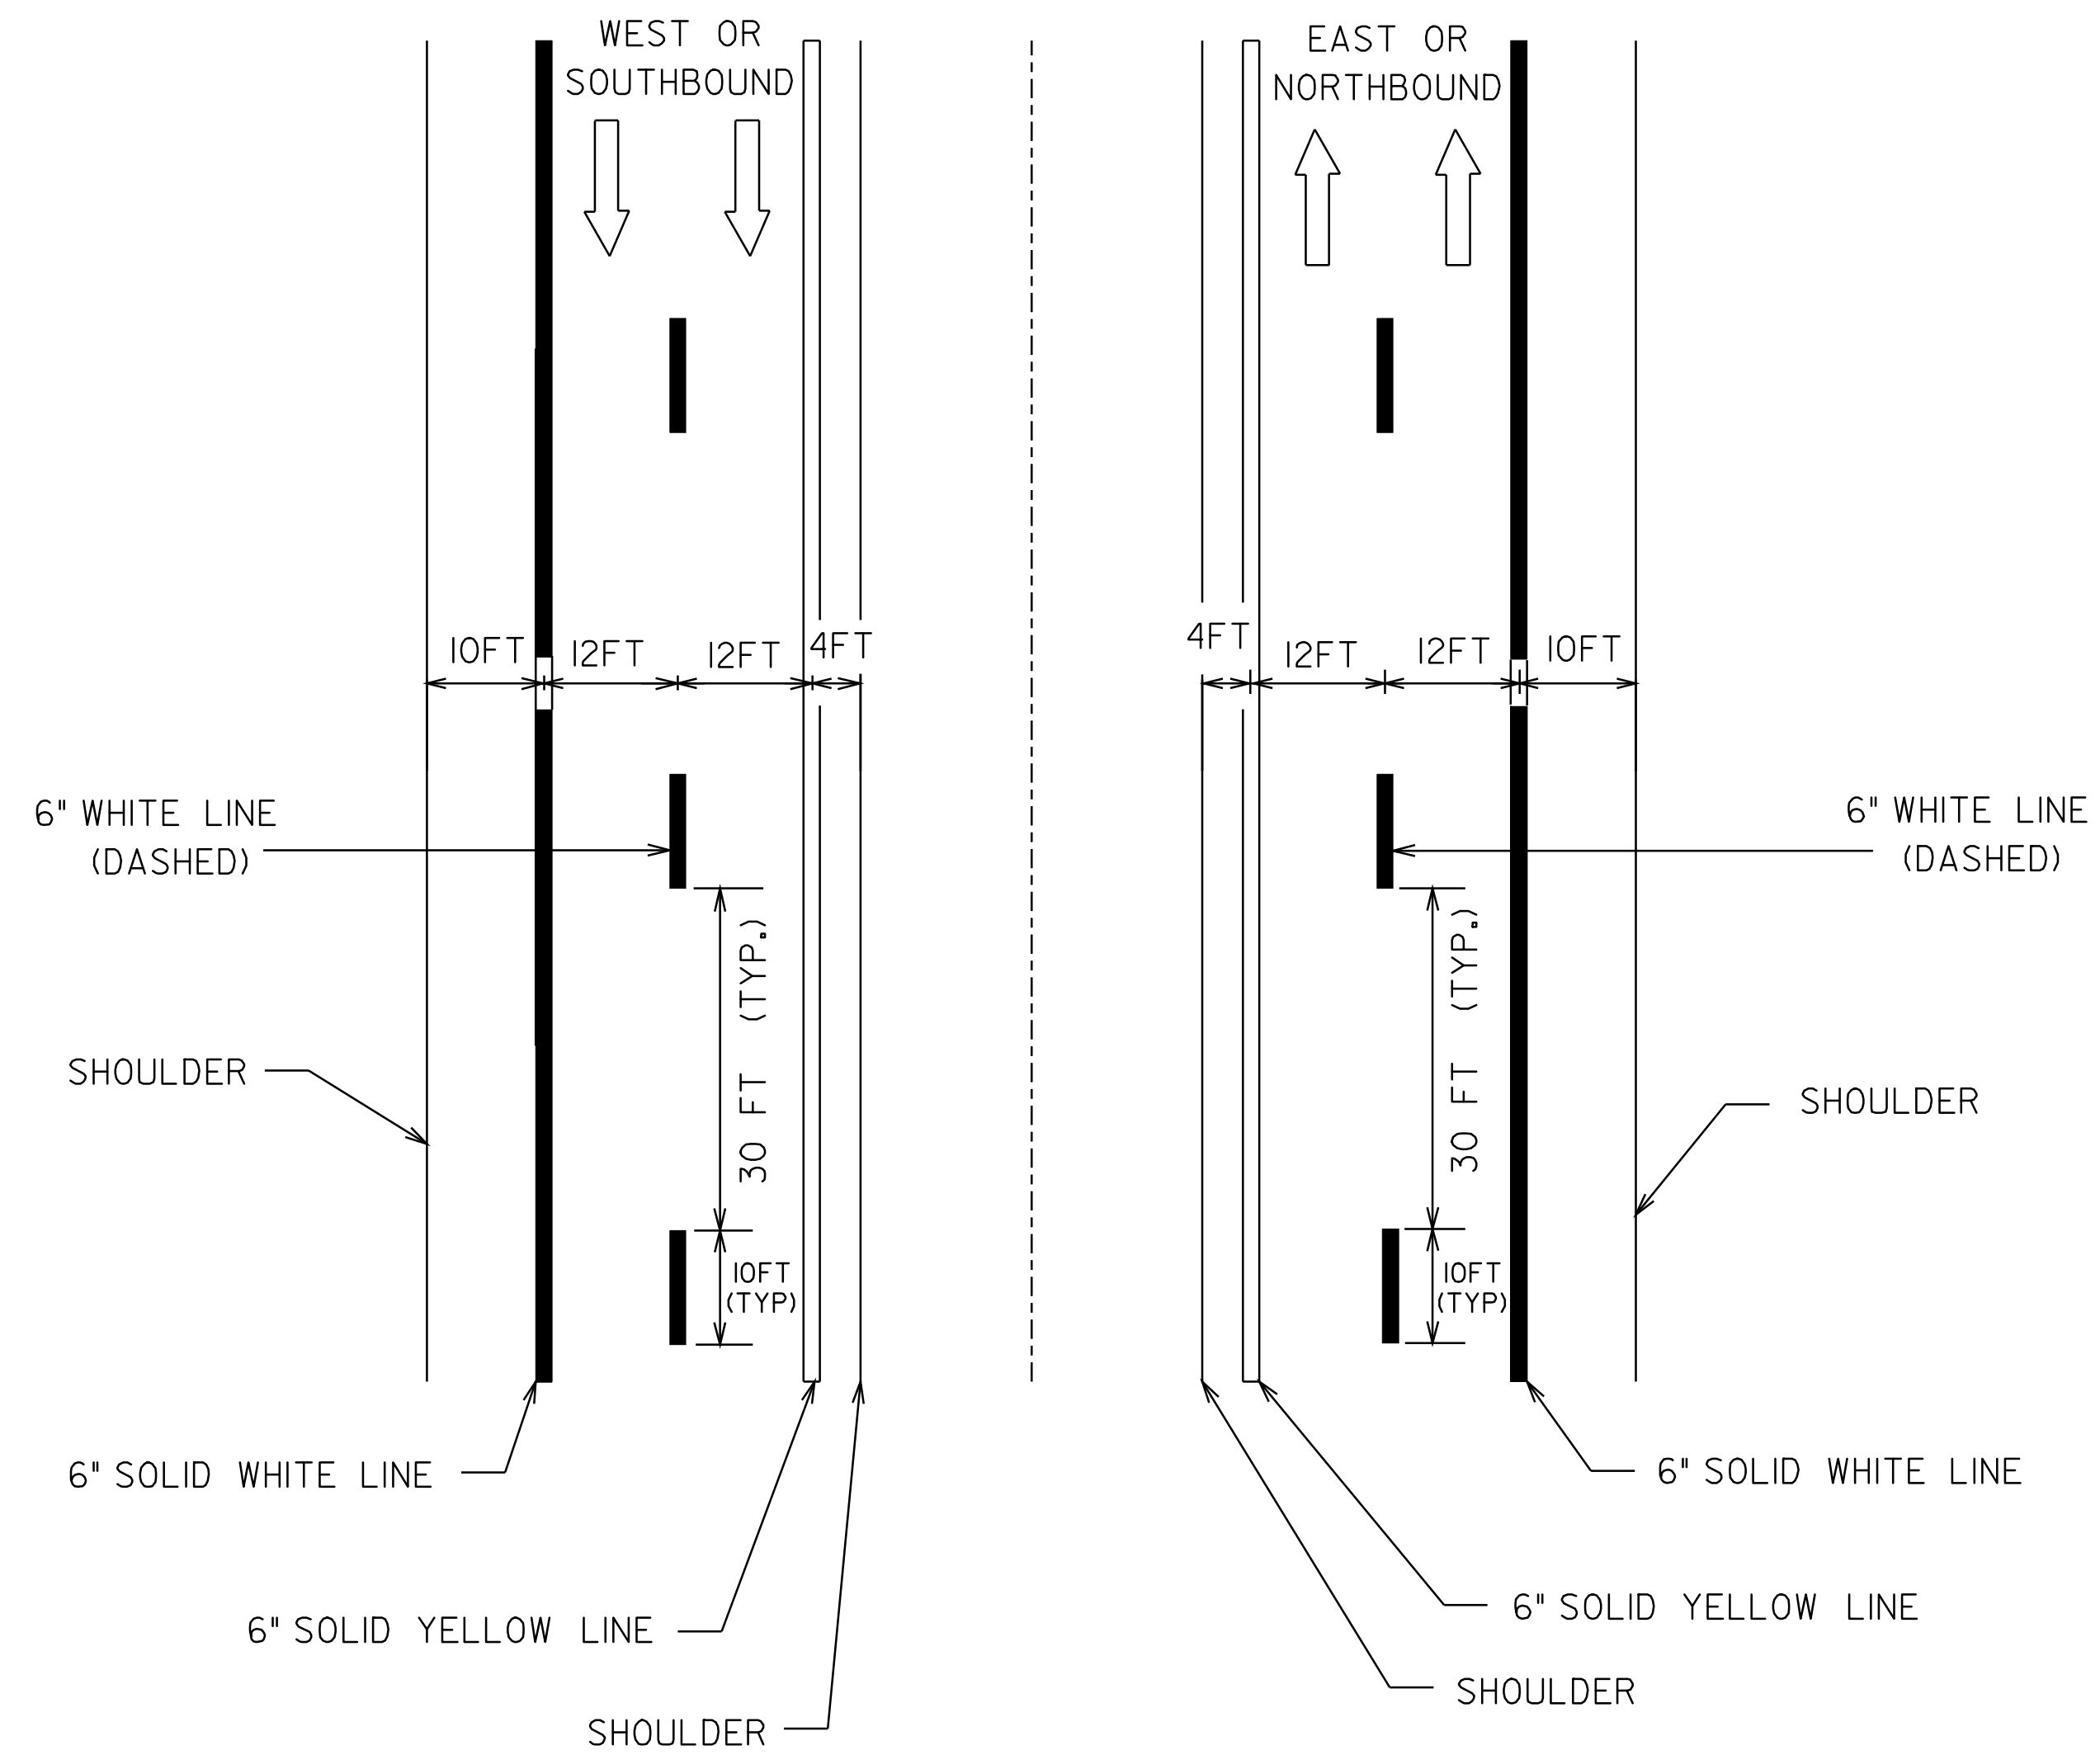

TYPICAL MAINLINE MARKING PLAN

LEGEND

- 6" WHITE LINES
- 6" YELLOW LINES
- DIRECTION OF TRAFFIC FLOW