


BRADFORD INTERCHANGE # 16
I-91

NOT TO SCALE

RAMPS REQUIRING CRACK SEALING

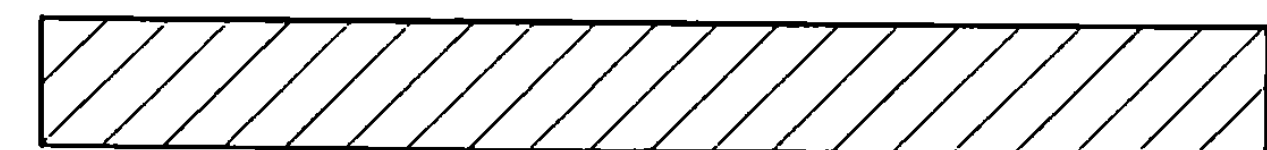

BRADFORD INTERCHANGE DETAIL	PROJECT NAME: STATEWIDE	PLOT DATE: 07-MAR-2008
	PROJECT NUMBER: STP CRAK(26)	DRAWN BY: LOCKE
	FILE NAME: p07k178.dgn	CHECKED BY: PAVT MGMT
	DESIGNED BY: LOCKE	SHEET 8 OF 11
	p07k178int3.l	